IREDELL COUNTY HEALTH DEPARTMENT

STATESVILLE 704-878-5305 MOORESVILLE 704-664-5281

IMPROVEMENT PERMIT / AUTHORIZATION TO CONSTRUCT / OPERATION PERMIT / EXISTING SYSTEM INSPECTION

PERMIT# 103824 PIN# 4861-34-7559 DATE 1-2-02

OWNER OR CONTRACTOR OMA DALTON, HEIRS PHONE: Business Home (704) 546-5483

ADDRESS 1139 TABOR ROAD, OLIN, NC 28660

LOCATION US 21 N, TL TABOR ROAD, TL OMI LANE, MHS AT END ON LEFT

SUBDIVISION BLOCK / SECTION LOT LOT AREA 1.66 ACRES SITE CLASS. 1 DESIGN FLOW 360 L.T.A.R. EXISTING

Septic Tank: 1000 Gallons: STB 825 Date 5-11-98
Pump Tank: Gallons: PT Date
Pump Make: Model Serial No
Nitrification Field: No Fields 1 Square Feet 900 Linear Feet 300
No Lines THREE Trench Width 36" Max Trench Bottom Depth VARIES Gravel Depth 18"

☐ New System ☐ Repair System Type: I. II. III. IV. V. VI
System Description: CONVENTIONAL GRAVITY
Repair System Description:
Maintenance Agreement Required: ☐ Yes ☐ NO

☐ House/Mod. Home No. Bedrooms 3
☑ Mobile Home No. Bathrooms 2
☐ Business No. Employees
☐ Other


☐ Slab ☐ Crawl Space ☐ Basement w/plumbing ☐ Basement wo/plumbing

Water Supply: ☑ Individual ☐ Public ☐ Community
WELL


Comments:/Conditions:

Comments:/Conditions: EXISTING SYSTEM INSTALLED OUT OF CONTOUR AS SHOWN

INITIAL SITE SKETCH

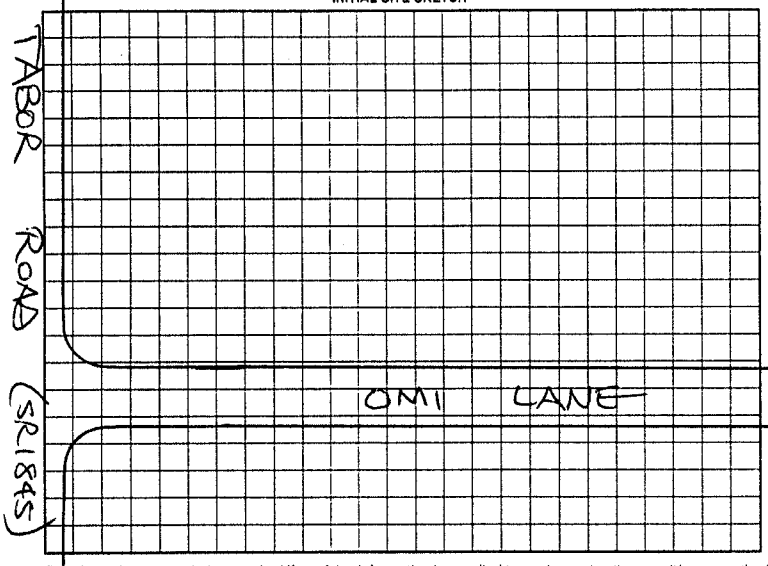

AS BUILT SKETCH

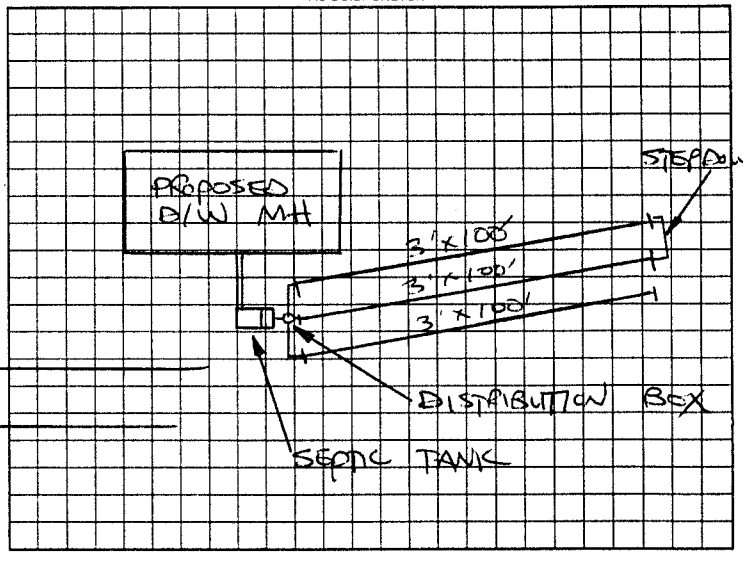

Permit can be suspended or revoked if any false information is supplied toward securing the permit/any unauthorized changes are made to the site/any unauthorized changes are made in the installation of the system. Improvement Permit with plat valid without expiration. Improvement Permit with site plan valid for sixty months. Authorization to Construct is valid for a period equal to that of Improvement Permit – not to exceed sixty months.

Signed: date Installed by:

Improvement Permit by: date Operation Permit by: date

Authorization to Construct by: date Existing System Inspection by: STEVE HENDRICK date 1-2-02

HEALTH DEPT. COPY: WHITE OWNER COPY (FINAL): YELLOW OWNER COPY (INITIAL): PINK