IREDELL COUNTY HEALTH DEPARTMENT

STATESVILLE 704-878-5305 (21) MOORESVILLE 704-664-5281

IMPROVEMENT PERMIT / AUTHORIZATION TO CONSTRUCT / OPERATION PERMIT / EXISTING SYSTEM INSPECTION

(21)

PERMIT# 105148 PIN# ~~4861-36-6569.B~~ 4861-35-9906 DATE 3-13-02

OWNER OR CONTRACTOR HOWARD K. WOOTEN PHONE: Business 704-876-1111 EXT 2657 Home

ADDRESS 612 HOLLAND DRIVE, STATESVILLE, NC 28677

LOCATION US 21 NORTH, TL TABOR ROAD, TRACT ON LEFT JUST BEFORE DUTCHMAN ROAD

SUBDIVISION BLOCK / SECTION LOT LOT AREA 80.96 ACRES SITE CLASS. PS DESIGN FLOW 360 L.T.A.R. 0.25 GPD/FT²

Septic Tank: 1000 Gallons; STB 620 Date 2-24-03
Pump Tank: Gallons; PT Date
Pump Make: Model Serial No.
Nitrification Field: No Fields 1 Square Feet 1440 Linear Feet 480
No Lines EIGHT Trench Width 36" Max Trench Bottom Depth 36" Gravel Depth 12"

☑ New System ☐ Repair System Type: I, II, III, IV, V, VI
System Description: CONVENTIONAL, GRAVITY
Repair System Description: CONVENTIONAL, PUMP
Maintenance Agreement Required: ☐ Yes ☑ No


☑ House/Mod. Home No. Bedrooms 3
☐ Mobile Home No. Bathrooms 3
☐ Business No. Employees
☐ Other
☐ Slab ☐ Crawl Space ☐ Basement w/plumbing ☑ Basement wo/plumbing

Water Supply: ☐ Individual ☑ Public ☐ Community


Comments/Conditions: INSTALL ONE FLOW DIVIDER TEE TO ACHIEVE EQUAL DISTRIBUTION INTO TWO SETS OF DROP BOXES AS SHOWN.

Comments/Conditions: SEPTIC TANK WITH RISERS INSTALLED USING "ZABEL" FILTER

INITIAL SITE SKETCH

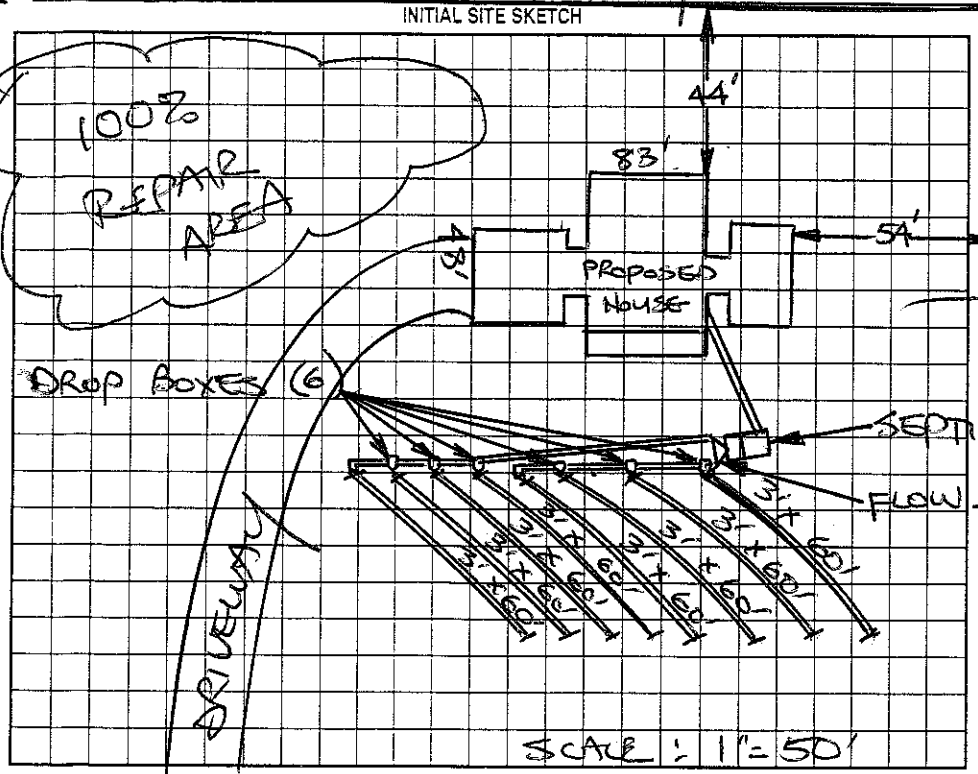

AS BUILT SKETCH

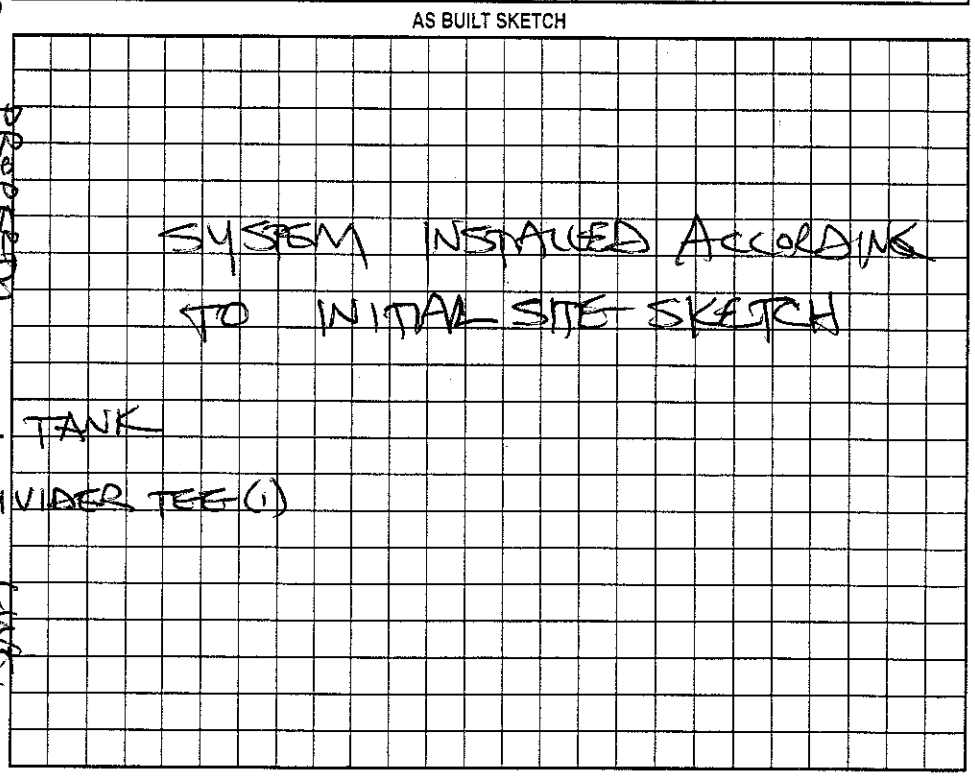

Permit can be suspended or revoked if any false information is supplied toward securing the permit/any unauthorized changes are made to the site/any unauthorized changes are made in the installation of the system. Improvement Permit with plat valid without expiration. Improvement Permit with site plan valid for sixty months. Authorization to Construct is valid for a period equal to that of Improvement Permit – not to exceed sixty months.

Signed: Howard Lee Wooten date 3/13/02 Installed by: SAMMY REAVIS

Improvement Permit by: STEVE HEDRICK date 3-13-02 Operation Permit by: STEVE HEDRICK date 6-25-03

Authorization to Construct by: STEVE HEDRICK date 3-13-02 Existing System Inspection by: date

HEALTH DEPT. COPY: WHITE OWNER COPY (FINAL): YELLOW OWNER COPY (INITIAL): PINK