ICHD - ENVIRONMENTAL HEALTH DIVISION

Statesville Office (704) 878-5305 x3456 | Mooresville Office (704) 660-6625 (BB)

PERMIT : OSWP 2024-54650

SEPTIC: IMPROVEMENT PERMIT / AUTHORIZATION TO CONSTRUCT / OPERATION PERMIT / EXISTING SYSTEM

PIN # 4861-41-5420

APPLICANT/OWNER: JEFFREY S WEEKS JR | APPLICANT ADDRESS: 60065 Little Mountain Rd Sherrills Ford NC 28673

SITE ADDRESS: 976 TABOR RD OLIN NC 286660 | PHONE: 704 526 9300 | ALT. PHONE

SITE DIRECTIONS: I-77 N → (R) TOMLIN MILL RD → (L) TABOR RD → site on (R) | SAP CONTROLLED: [X] YES [ ] NO

SUBDIVISION: MADDIE GREY ESTATES | SECTION: — | LOT # 6 | LOT AREA: 0.761 | DESIGN FLOW: 360 | L.T.A.R.(Initial): 0.275 | L.T.A.R (Repair): 0.275


Septic Tank	1000 (gal)	STB	Date	[X] New System	[ ] Repair	[ ] Expansion	System Type: I II (III) IV V VI	[X] Residence	No. Bedrooms 3
Pump Tank	(gal)	PT	Date	System Description:	GRAVITY 25% REDUCTION			[ ] Business	No. Persons 6
Pump Make	Model		Serial #	Repair System Description:	GRAVITY 25% REDUCTION			[ ] Other	No. Employees —
# Nitrification Fields	1 # Lines 6		Linear Ft 328	Maintenance Agreement Required:	[ ] YES	[X] NO		[ ] Slab	[X] Crawl Space
Trench Width 36"	*Max. Trench Depth(Initial) 31"		*Max. Trench Depth(Repair) 31"	Gravel Depth —	[X] GRAVITY	[ ] PRESSURE		[ ] Basement w/plumbing	[ ] Basement w/o plumbing

Water Supply: [ ] Private [X] Public [ ] Community

* Measured on the downhill side of the trench | Effluent Standard: [X] DSE [ ] HSE [ ] TS-I [ ] TS-II [ ] RCW [ ] NSF/ANSI 40 | Usable Depth to LC (Initial): 46" | Usable Depth to LC (Repair): 46" *Limiting Condition*

Comments / Conditions: Install on contour Utilize serial distribution. Do not park, drive, grade, etc. over septic area. Keep out of power line ROW.

INITIAL SITE SKETCH

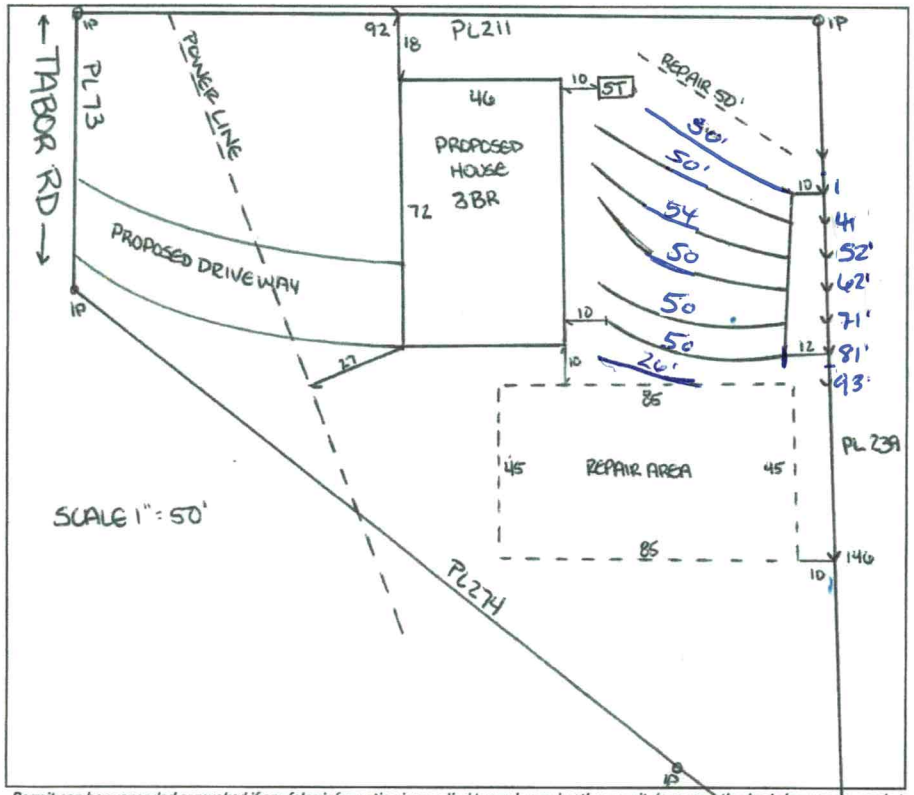

AS BUILT SKETCH

FOR SEPTIC FINAL INSPECTION CALL: 704-664-3703 between 8am-9am the day the inspection is needed. Be sure to speak with an inspector to confirm your time.

TANK + LINE #1 SW 10/30/2024

Remaining Lines 10/31/24 - DW

Permit can be suspended or revoked if any false information is supplied toward securing the permit / any unauthorized changes are made to the site / any unauthorized changes are made in the installation of the system. **CONTACT A LOCATOR SERVICE PRIOR TO ANY EXCAVATION**

[ ] **IMPROVEMENT PERMIT** *with plat valid without expiration.* [X] **IMPROVEMENT PERMIT** *with site plan valid for 60 mos.* [X] **AUTHORIZATION TO CONSTRUCT** *valid for period equal to IMPROVEMENT PERMIT--not to exceed 60 mo.*

Owner / Applicant Signature: ONLINE | Date: | Installed by: Overdrive

IMPROVEMENT PERMIT by: Sarah W Williams | Date: 7/10/2024 | OPERATION PERMIT by: D Meberg | Date: 10/31/24

AUTHORIZATION TO CONSTRUCT by: Sarah W Williams | Date: 7/10/2024 | Existing System Inspected by: | Date:

ICHD - ENVIRONMENTAL HEALTH DIVISION

Statesville Office (704) 878-5305 x3456 | Mooresville Office (704) 660-3625 (BB)

SEPTIC: IMPROVEMENT PERMIT / AUTHORIZATION TO CONSTRUCT / OPERATION PERMIT / EXISTING SYSTEM

PERMIT : OSWP 2024-54650

PIN # 4861 -- 41 -- 5420

APPLICANT/OWNER: JEFFREY S WEEKS JR | APPLICANT ADDRESS: 60065 Little Mountain Rd Sherrills Ford NC 28673

SITE ADDRESS: 976 TABOR RD OLIN NC 286660 | PHONE: 704 526 9366 | ALT. PHONE

SITE DIRECTIONS: I-77 N → (R) TOMLIN MILL RD → (L) TABOR RD → site on (R) | SAP CONTROLLED: [X] YES [ ] NO

SUBDIVISION: MADDIE GREY ESTATES | SECTION: — | LOT # 6 | LOT AREA: 0.761 | DESIGN FLOW: 360 | L.T.A.R.(Initial): 0.275 | L.T.A.R (Repair): 0.275

Septic Tank 1000 (gal) | STB | Date

Pump Tank (gal) | PT | Date

Pump Make | Model | Serial #

Nitrification Fields 1 | # Lines 6 | Linear Ft 328

Trench Width 36" | *Max. Trench Depth(Initial) 31" | *Max. Trench Depth(Repair) 31" | Gravel Depth —

* Measured on the downhill side of the trench

[X] New System [ ] Repair [ ] Expansion | System Type: I II (III) IV V VI

System Description: GRAVITY 25% REDUCTION

Repair System Description: GRAVITY 25% REDUCTION

Maintenance Agreement Required: [ ] YES [X] NO

[X] GRAVITY [ ] PRESSURE

Effluent Standard: [X] DSE [ ] HSE [ ] TS-I [ ] TS-II [ ] RCW [ ] NSF/ANSI 40

Usable Depth to LC (Initial): 46"

[X] Residence | No. Bedrooms 3

[ ] Business | No. Persons 6

[ ] Other | No. Employees —

[ ] Slab | [X] Crawl Space


[ ] Basement w/plumbing | [ ] Basement w/o plumbing

Usable Depth to LC (Repair): 46" *Limiting Condition*

Water Supply: [ ] Private [X] Public [ ] Community

Comments / Conditions: Install on contour Utilize serial distribution. Do not park, drive, grade, etc. over septic area. Keep out of power line ROW.

INITIAL SITE SKETCH

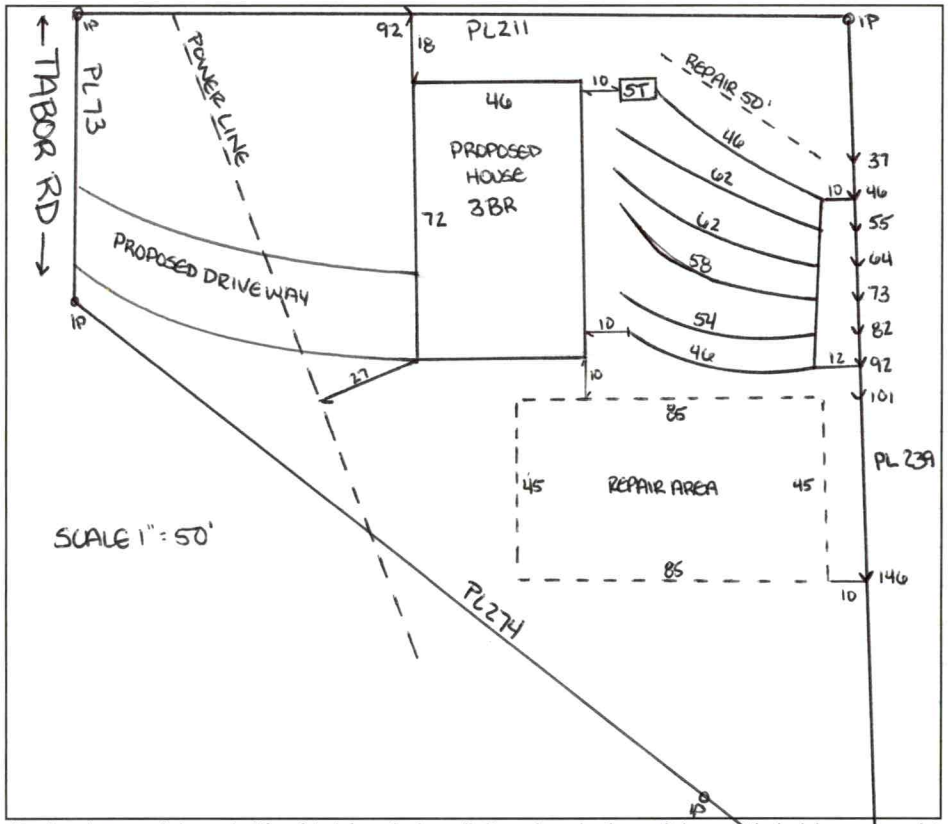

AS BUILT SKETCH

FOR SEPTIC FINAL INSPECTION CALL: 704-664-3703 between 8am-9am

the day the inspection is needed. Be sure to speak with an inspector to confirm your time.

TANK + LINE #1 SW 10/30/2024

Permit can be suspended or revoked if any false information is supplied toward securing the permit / any unauthorized changes are made to the site / any unauthorized changes are made in the installation of the system. **CONTACT A LOCATOR SERVICE PRIOR TO ANY EXCAVATION**

[ ] **IMPROVEMENT PERMIT** ***with plat*** *valid without expiration.* [X] **IMPROVEMENT PERMIT** ***with site plan*** *valid for 60 mos.* [X] **AUTHORIZATION TO CONSTRUCT** *valid for period equal to IMPROVEMENT PERMIT--not to exceed 60 mo.*

Owner / Applicant Signature: ONLINE | Date: | Installed by:

IMPROVEMENT PERMIT by: Sarah Williams | Date: 7/10/2024 | OPERATION PERMIT by: | Date:

AUTHORIZATION TO CONSTRUCT by: Sarah Williams | Date: 7/10/2024 | Existing System Inspected by: | Date:

Item	Date	Initials
Drain Lines Checked		
Tanks Checked		
Pressure Manifold or Valve Box Checked		
Pressure Head Set		
Electrical Checked		
Floats Set		
Alarm Checked		
Maintenance Contract Needed? Y / N		
Comments:		

Repairs Only	
	State Code
Failing System Code	
Type of Distribution	G or P
Type of Failure/Malfunction	
Primary Cause of Failure/Malfunction	
Age of System? _____	
Initial or Repair? _____	

PERMIT SNAPSHOT REPORT OSWP-2024-54650 FOR IREDELL COUNTY

Permit Type	Environmental Health OSWP	**Project:**		**App Date:**	05/31/2024
Work Class:	EH Septic Permit	**District:**	Iredell County	**Exp Date:**	NOT AVAILABLE
Status:	In Progress	**Square Feet:**	0.00	**Completed:**	NOT COMPLETED
Valuation:	$0.00	**Assigned To:**	Bracken, Sarah	**Approval Expire Date:**	

Description: house size change. 46x72 everything else on old improvement works great.

Parcel: 4861415420.000 Main	**Address:** 976 Tabor Rd Olin, NC 28660 Main	**Zone:** RA(Residential Agricultural District)

Property Owner	Applicant/Authorized Agent
jeffrey s weeks jr	jeffrey s weeks jr
6065 Little Mountain Rd	6065 Little Mountain Rd
Sherrills Ford, NC 28673	Sherrills Ford, NC 28673
Mobile: (704) 526-9366	Mobile: (704) 526-9366

Permit Custom Fields

How is your site plan being submitted	Custom Site Plan	Septic Application/Permit Type	Intermediate Re-Layout	Does the site contain any jurisdictional wetlands	No
Non-domestic Sewage Generated	No	Other Public Agency	No	All proposed structure dimensions	46x72 main house 28x50, 6x20 front porch, 12x16 rear deck, 22wx24d garage
What are the proposed structures	New Single-Family Residence - Stick Built	Type of New Single-Family Residence	Stick Built	Maximum Number of Bedrooms	3
If other Addition/Structure, please explain		Number of Occupants	2	Foundation Type	Crawl Space Foundation
Residential/Business/Other	Residential	Number of Employees	2	Water Supply	Other Public Water
Desired Septic System Type	Conventional (most common)	If other septic system type, please explain		Pump Make	
# of Nitrification Fields		Model		Serial #	
System Description		Repair System Description		Comments/Conditions	
Permit type(s)	Authorization to Construct	Additional Unique Setbacks Apply	No		

Attachment File Name	Added On	Added By	Attachment Group	Notes
Signature_jeffrey_weeks_5/31/2024.jpg	05/31/2024 15:10	weeks jr, jeffrey		Uploaded via CSS
976 Tabor Rd IP_v1.pdf	05/31/2024 15:58	weeks jr, jeffrey	Available Online	
authorize to act as agent_v1.pdf	05/31/2024 15:58	weeks jr, jeffrey	Available Online	
olin nc_v1.jpg	05/31/2024 15:58	weeks jr, jeffrey	As Built Sketch	

Inspection Number	Status	Inspection Type	Request Date	Scheduled Start Date	Scheduled End Date	Actual Start Date	Actual End Date
2024-228551	Requested	OSWP Septic/Well Preliminary Site Visit	07/05/2024	07/08/2024 0:00	07/08/2024 0:00		


Inspectors: Bracken, Sarah (Primary)


Checklist Item	Description	Passed	Comments
General Comments	Checklist item used to track general comments, not specific to any other checklist item	No	


PERMIT SNAPSHOT REPORT (OSWP-2024-54650)

Invoice No.	Fee		Fee Amount	Amount Paid
INV-00031644	Intermediate Re-layout		$320.00	$320.00
		Total for Invoice INV-00031644	$320.00	$320.00
		Grand Total for Permit	**$320.00**	**$320.00**

Workflow Step / Action Name	Action Type	Start Date	End Date
Application Completeness Check v.1		05/31/2024 15:59	05/31/2024 15:59
Confirm application complete v.1	Generic Action		05/31/2024 15:59
~~**Zoning Review v.1**~~			05/31/2024 15:59
~~Floodplain Admin Overview v.1~~	Task		05/31/2024 15:59
~~Issue Invoice v.1~~	Generic Action		05/31/2024 15:59
~~Fees Paid v.1~~	Generic Action		05/31/2024 15:59
Fees v.1		05/31/2024 15:59	07/02/2024 9:36
Issue Invoice v.1	Generic Action		05/31/2024 15:59
Fees Paid v.1	Generic Action		07/02/2024 9:36
Lot Readiness Verification v.1		07/05/2024 12:09	
OSWP Septic Preliminary Site Visit v.1	Inspection	07/05/2024 12:09	07/05/2024 12:09
OSWP Site Evaluation v.1	Inspection		
Issue Improvement Permit v.1			
Issue Invoice v.1	Generic Action		
Fees Paid v.1	Generic Action		
Issue Permit v.1	Generic Action		
Permit Completion Process v.1			
Authorization to Construct Permit v.1	Create Sub Permit		
Issue Authorization to Construct v.1	Generic Action		

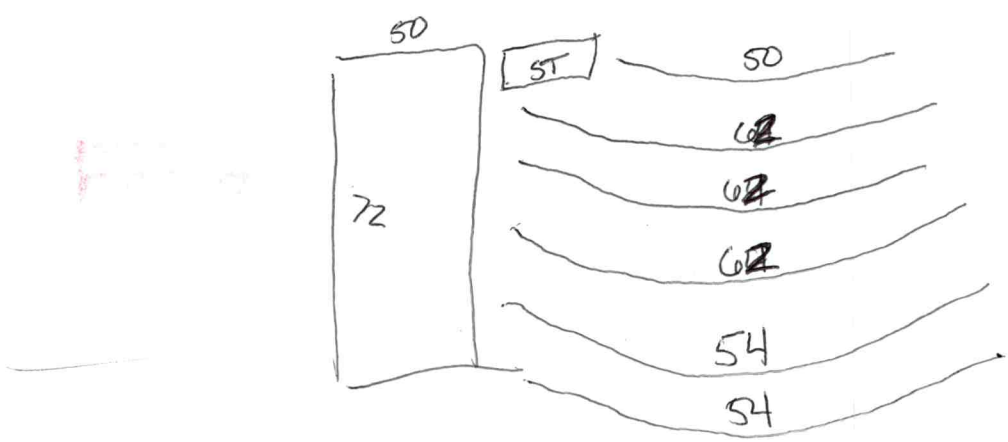

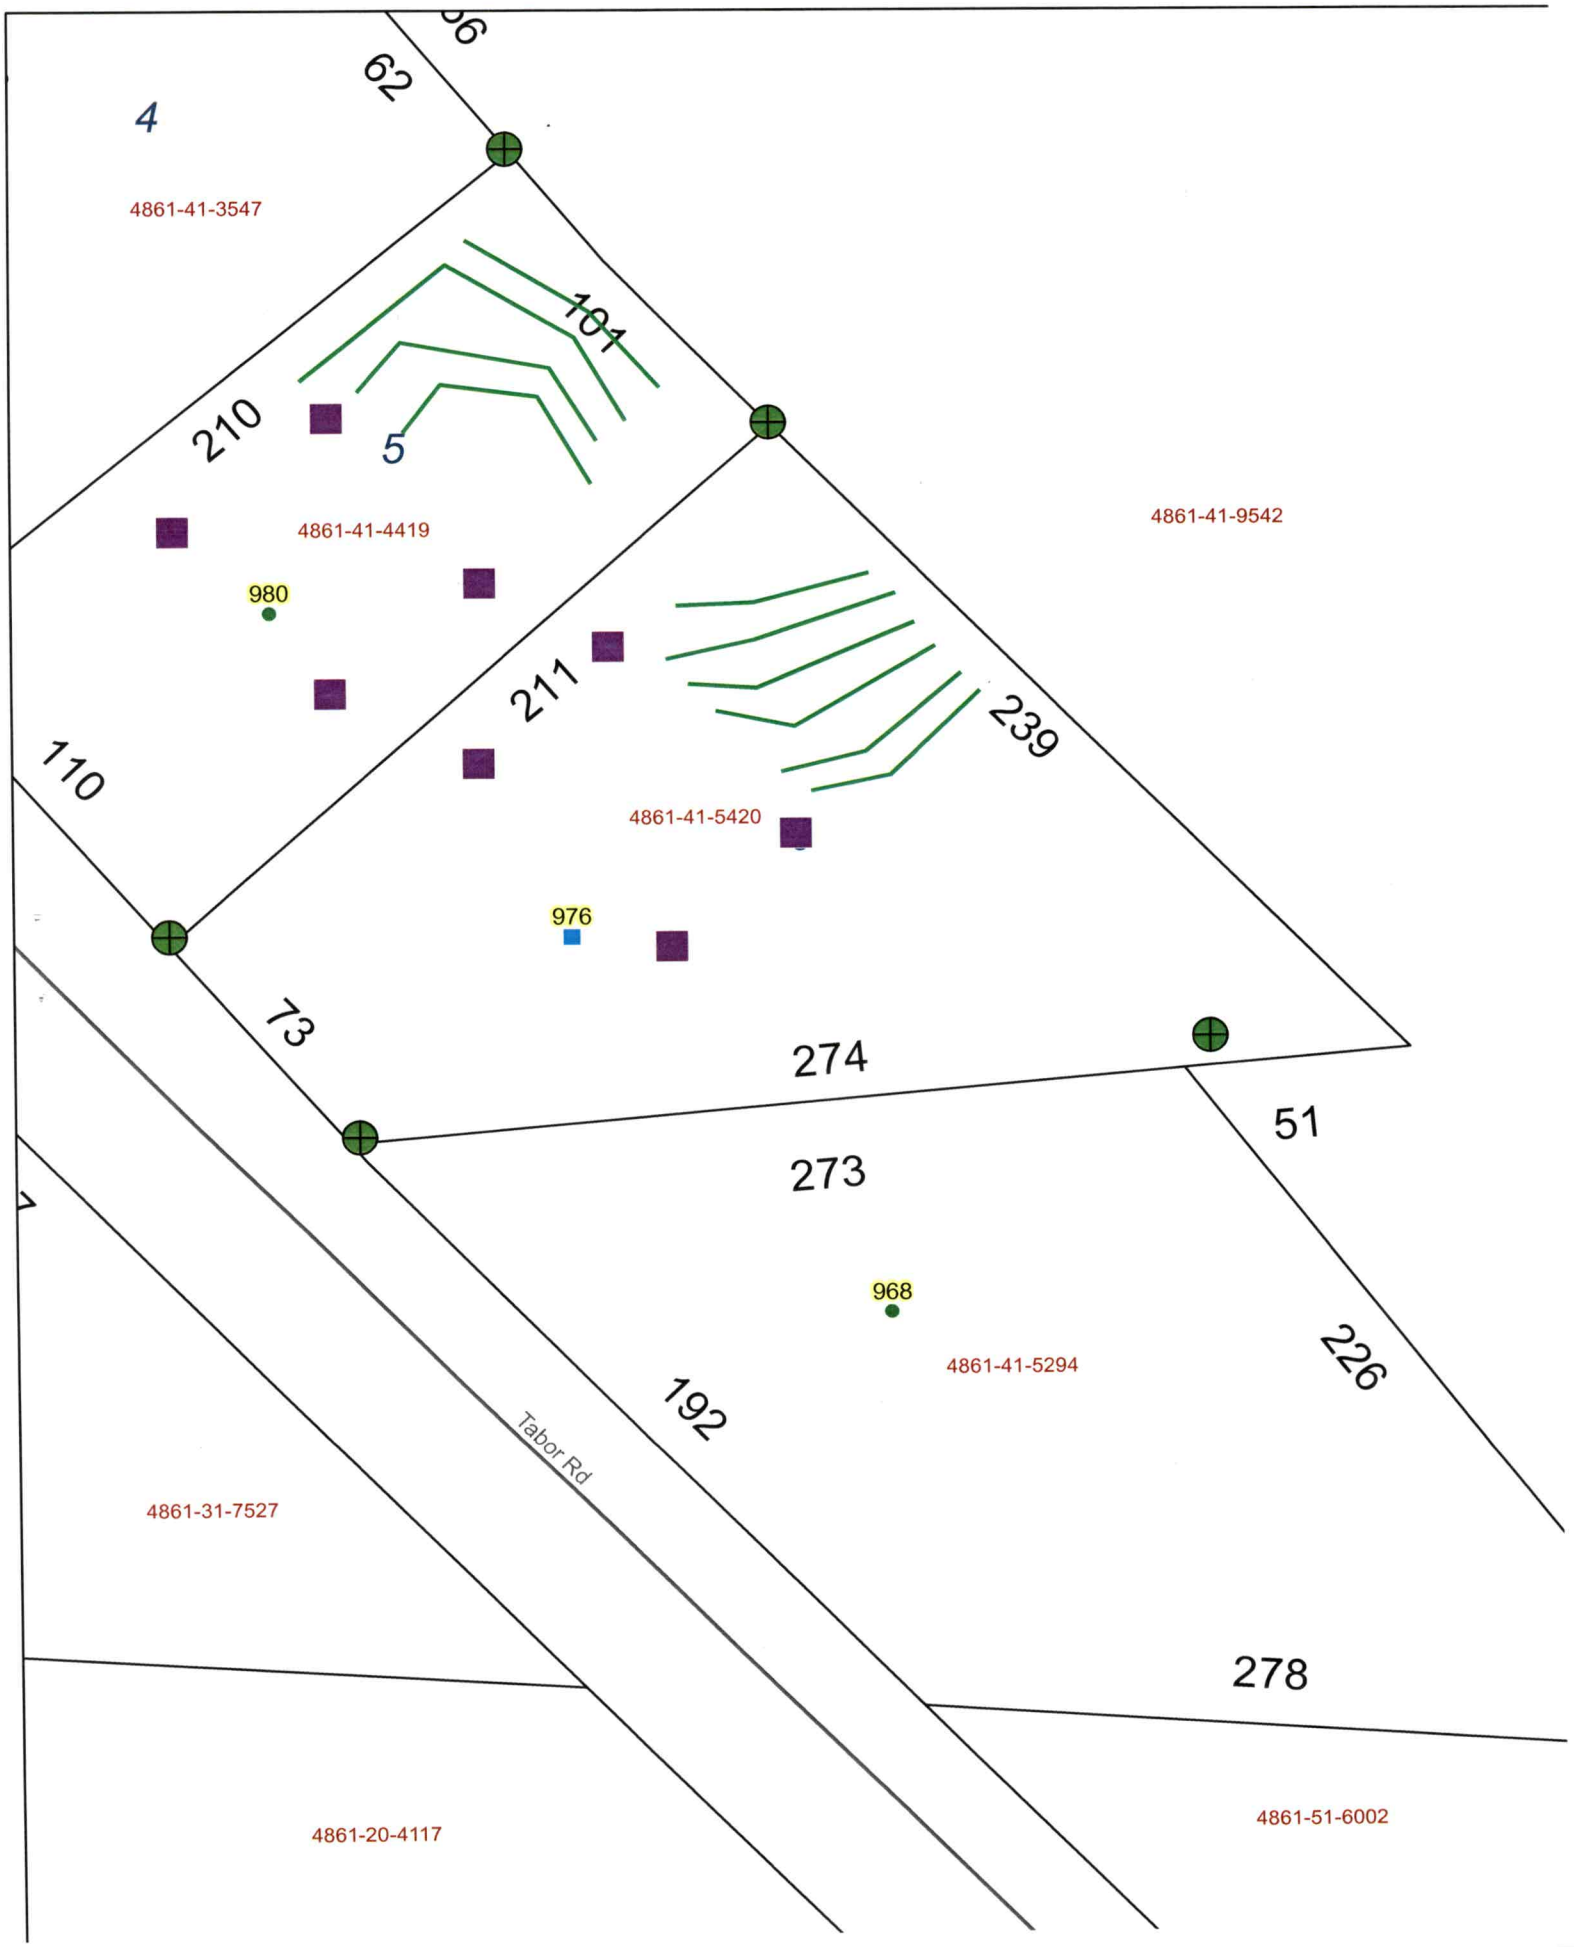
4
62
4861-41-3547
101
210
5
4861-41-4419
4861-41-9542
980
211
239
110
4861-41-5420
976
73
274
51
273
968
4861-41-5294
226
192
Tabor Rd
4861-31-7527
278
4861-20-4117
4861-51-6002

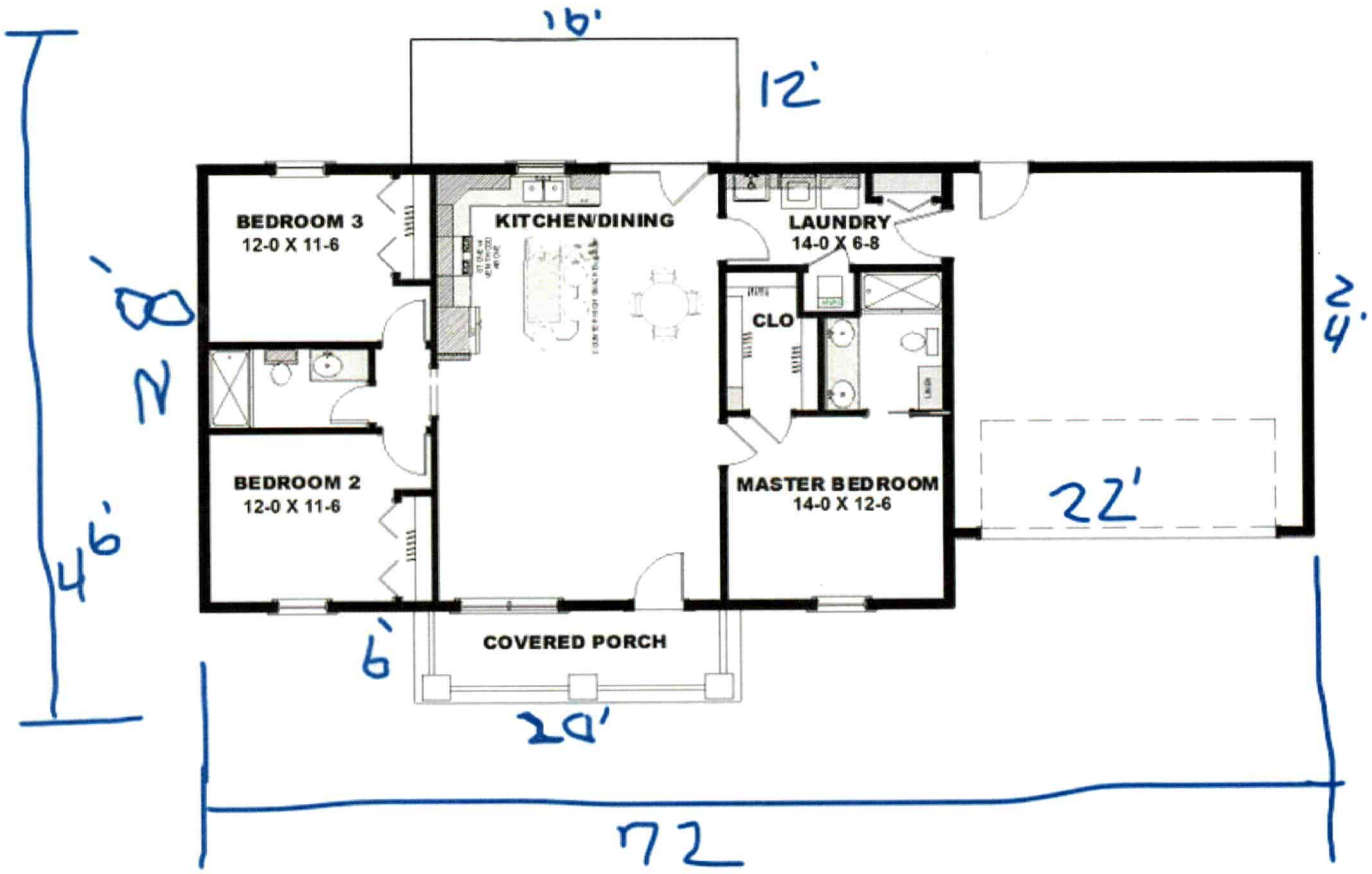
16'
12'
BEDROOM 3
12-0 X 11-6
KITCHEN/DINING
LAUNDRY
14-0 X 6-8
CLO
24'
28'
BEDROOM 2
12-0 X 11-6
MASTER BEDROOM
14-0 X 12-6
22'
46'
6'
COVERED PORCH
20'
72