ICHD - ENVIRONMENTAL HEALTH DIVISION

Statesville Office (704) 878-5305 Mooresville Office (704) 660-3625 (SB)

PERMIT # OSWP-2022-7020

SEPTIC: IMPROVEMENT PERMIT / AUTHORIZATION TO CONSTRUCT / OPERATION PERMIT / EXISTING SYSTEM

PIN # 4861 -- 50 -- 6168

APPLICANT/OWNER: WILLIAM R. MAY

APPLICANT ADDRESS: 3348 JENNINGS ROAD, UNION GROVE, N.C. 28689

SITE ADDRESS: 147 STACK ROAD, OLIN, N.C. 28660

PHONE: 704-902-4010 ALT. PHONE —

SITE DIRECTIONS: (N) ON 77, (R) ON 901, (R) ON TABOR, (L) ON STACK, LOT ON (L)


SAP CONTROLLED: ☐ YES ☐ NO EXT

SUBDIVISION: — SECTION: — LOT # — LOT AREA: 12 AC DESIGN FLOW: EXT L.T.A.R.: EXT

Septic Tank	1000	(gal)	STB 1012	Date 9/26/22	☐ New System	☑ Repair	☐ Expansion	System Type: I (II) III IV V VI	☑ Residence	No. Bedrooms	EXT	Water Supply
Pump Tank	—	(gal)	PT —	Date —	System Description:	EXISTING			☐ Business	No. Persons	EXT	☑ Private EXT
Pump Make	—	Model	—	Serial # —	Repair System Description:	TANK REPLACEMENT			☐ Other	No. Employees	—	☐ Public
# Nitrification Fields	EXT	# Lines	EXT	Linear Ft EXT	Maintenance Agreement Required:	☐ YES	☑ NO		☐ Slab	☐ Crawl Space		☐ Community
Trench Width	EXT	Trench Bottom Depth(Low side)	EXT	Gravel Depth EXT	☑ GRAVITY	☐ PRESSURE			☐ Basement w/plumbing		☑ Basement w/o plumbing	

Comments / Conditions: PUMP, CRUSH, AND FILL EXISTING SEPTIC TANK, INSPECT AND REPLACE D-BOX AS NEEDED, DRAINFIELD APPEARED TO BE FUNCTIONING AT TIME OF INSPECTION

INITIAL SITE SKETCH

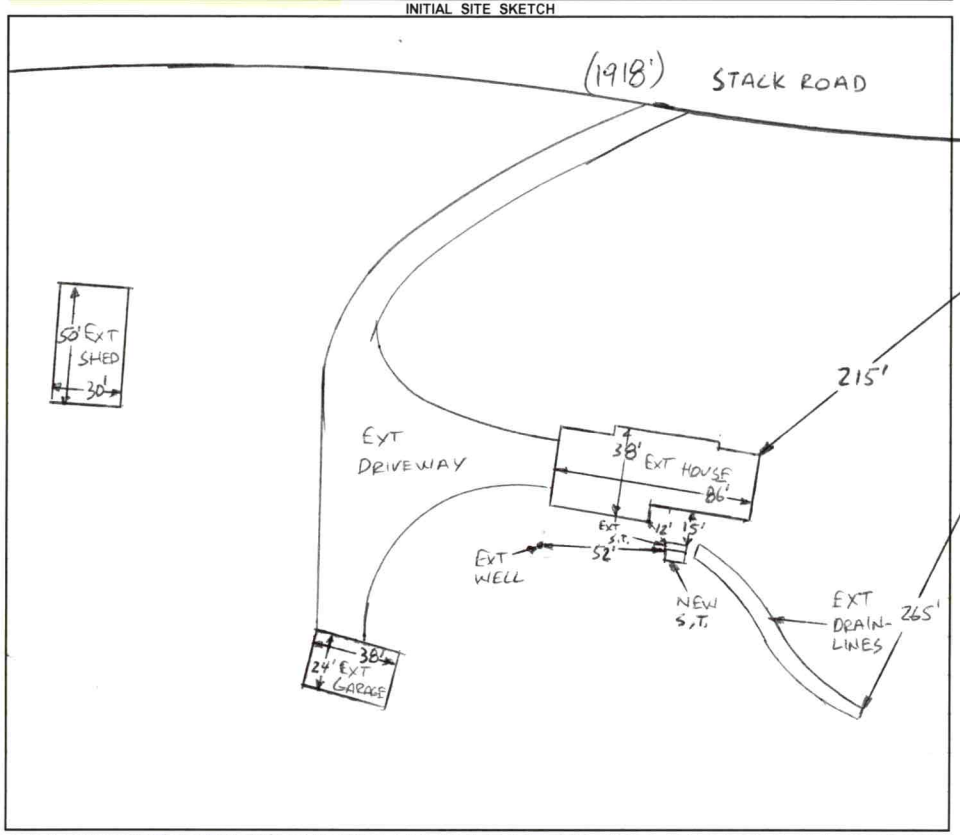

AS BUILT SKETCH

FOR SEPTIC FINAL INSPECTION CALL: 704-664-3703 between 8am-9am

the day the inspection is needed. Be sure to speak with an inspector to confirm your time.

1 IN = 80 FT

S.T. = SEPTIC TANK

EXT = EXISTING

Permit can be suspended or revoked if any false information is supplied toward securing the permit / any unauthorized changes are made to the site / any unauthorized changes are made in the installation of the system. **CONTACT A LOCATOR SERVICE PRIOR TO ANY EXCAVATION**

☐ **IMPROVEMENT PERMIT** ***with plat*** *valid without expiration.* ☑ **IMPROVEMENT PERMIT** ***with site plan*** *valid for 60 mos.* ☑ **AUTHORIZATION TO CONSTRUCT** *valid for period equal to IMPROVEMENT PERMIT--not to exceed 60 mo.*

Owner / Applicant Signature: Online Signature Date: Installed by: Al Beachboard

IMPROVEMENT PERMIT by: Bryant C. White Date: 11-17-2022 OPERATION PERMIT by: Date: 11/28/22

AUTHORIZATION TO CONSTRUCT by: Bryant C. White Date: 11-17-2022 Existing System Inspected by: Date:

FOR SEPTIC FINAL INSPECTION: CALL 704-664-3703 between 8am-9am the day the inspection is needed.

Item	Date	Initials
Drain Lines Checked		
Tanks Checked		
Pressure Manifold or Valve Box Checked		
Pressure Head Set		
Electrical Checked		
Floats Set		
Alarm Checked		
Maintenance Contract Needed? Y / N		
Comments:		

Repairs Only	
	State Code
Failing System Code	
Type of Distribution	G or P
Type of Failure/Malfunction	
Primary Cause of Failure/Malfunction	
Age of System? _____	
Initial or Repair? _____	

PERMIT SNAPSHOT REPORT OSWP-2022-7020
FOR IREDELL COUNTY

Permit Type: Environmental Health OSWP
Work Class: EH Septic Improvement Permit Repair
Status: PRIORITY PERMIT
Valuation: $0.00
Description: Septic Repair (May need exploratory digging).

Project:
District: Iredell County
Square Feet: 0.00
Assigned To: White, Bryant

App Date: 10/14/2022
Exp Date: NOT AVAILABLE
Completed: NOT COMPLETED
Approval Expire Date:

Parcel: 4861506168.000 Main

Address: 147 Stack Rd Main
Olin, NC 28660

Zone: RA(Residential Agricultural District)

Applicant/Authorized Agent
WILLIAM R II+CHRISTIE D
FOSTER MAY MAY

Applicant/Authorized Agent
William R May
3348 Jennings Road
Union Grove, NC 28689
Mobile: (704) 902-4010

Property Owner
TIFFANY L+JAMES T
MITCHELL II HUBBS

Permit Custom Fields

How is your site plan being submitted	Custom Site Plan	Does the site contain any jurisdictional wetlands	No	Non-domestic Sewage Generated	No
Other Public Agency	No	Maximum Number of Bedrooms	3	Number of Occupants	6
Foundation Type	Concrete Slab Foundation	Water Supply	Existing Well	Desired Septic System Type	Conventional (most common)
If other septic system type, please explain		Additional Unique Setbacks Apply	No		

Attachment File Name	Added On	Added By	Attachment Group	Notes
Signature_William_May_10/14/2022.jpg	10/14/2022 8:36	May, William		Uploaded via CSS
Auth to Act Mitchell_v1.pdf	10/20/2022 7:44	Nebel, Barbara	Available Online	Authorize to Act as Agent
site plan Mitchell_v2.pdf	10/21/2022 12:10	Nebel, Barbara	Available Online	Site Plan


Invoice No.	Fee	Fee Amount	Amount Paid
NOT INVOICED	Existing System Septic Repair Permit	$150.00	$0.00
	Total for Invoice NOT INVOICED	$150.00	$0.00
	Grand Total for Permit	**$150.00**	**$0.00**

Workflow Step / Action Name	Action Type	Start Date	End Date
Application Completeness Check v.1		10/21/2022 0:00	10/21/2022 12:11
Confirm application complete v.1	Generic Action		10/21/2022 12:11
~~Zoning Review v.1~~			10/21/2022 12:11
~~Iredell County Zoning Approval v.1~~	Task		10/21/2022 12:11
~~Issue Invoice v.1~~	Generic Action		10/21/2022 12:11
~~Fees Paid v.1~~	Generic Action		10/21/2022 12:11
Assign v.1			
Case Assigned v.1	Generic Action		
Lot Readiness Verification v.1			
OSWP Septic Preliminary Site Visit v.1	Inspection		
OSWP Site Evaluation v.1	Inspection		
Permit Ready v.1			
Issue Permit v.1			
Issue Invoice v.1	Generic Action		
Fees Paid v.1	Generic Action		
Issue Permit v.1	Generic Action		
Environment Health Inspections v.1			
Operation Permit Inspection v.1	Inspection		

IREDELL COUNTY DEPARTMENT of ENVIRONMENTAL HEALTH

SITE PLAN WORKSHEET

SEE THE "SAMPLE SITE PLAN" BELOW. ***INCOMPLETE SITE PLANS WILL BE RETURNED TO YOU FOR COMPLETION AND MAY RESULT IN A DELAY IN THE ISSUANCE OF YOUR SEPTIC SYSTEM OR WELL PERMIT!!!***

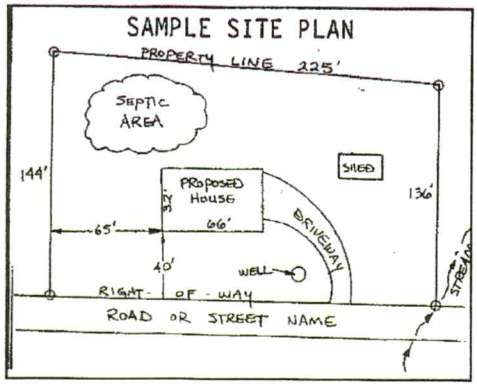

Place an (X) beside each item as you complete the site plan:


- ( ) Property Line measurements are clearly identified
- ( ) All proposed structures are indicated
- ( ) Front and side setbacks from property line
- ( ) Preferred driveway location
- ( ) Preferred well location
- ( ) Preferred septic system location
- ( ) North arrow, or other sufficient indicator of direction

Circle N/A on the following if appropriate:

Location of septic systems and wells within 100' of your property	N/A
Location of easements and rights of ways on your property	N/A
Location of any designated wetlands on the property	N/A


USE THIS SPACE TO DRAW YOUR SITE PLAN

Show: proposed house or business footprint, wells, water lines, patios, pools and decks, and any other item that will occupy space on the site

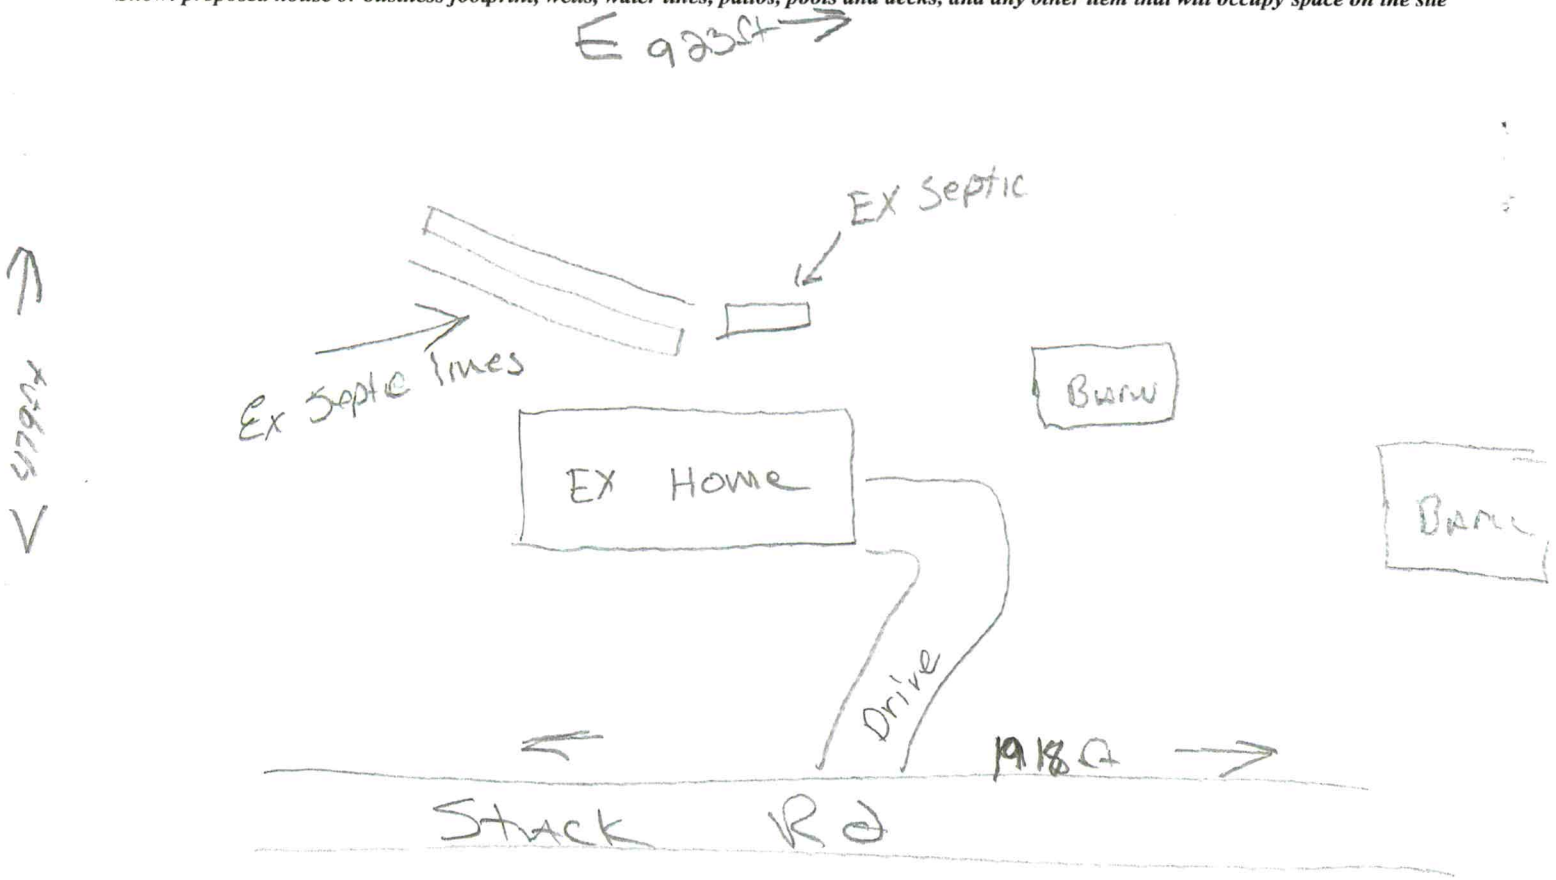

Signature: Kristy Foster May / A-1 Backhoe Inc 10/13/2022

Property owner or owner's legal representative signature (SIGNATURE REQUIRED) **DATE**

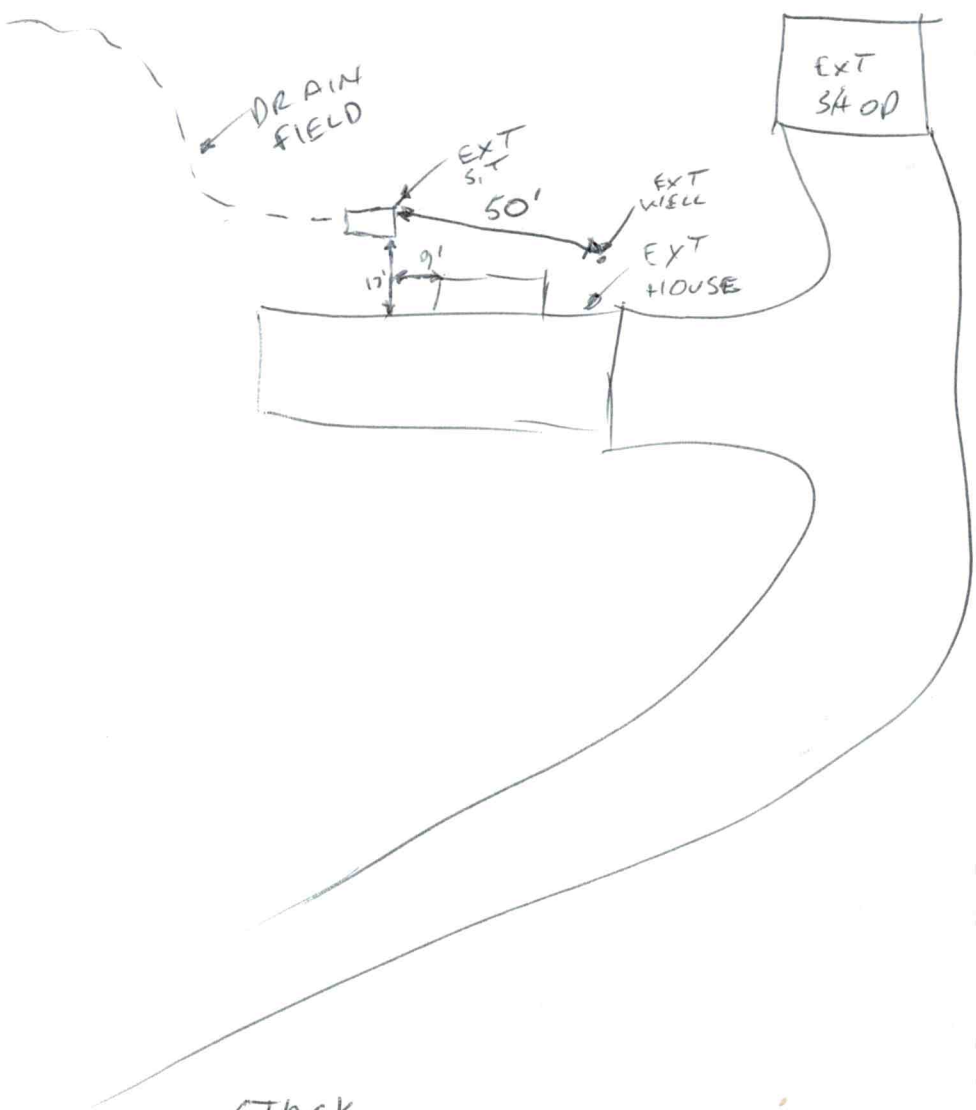
DRAIN FIELD
EXT SEPTIC
50'
EXT WELL
EXT HOUSE
EXT SHED
17'
9'
STACK ROAD