IREDELL COUNTY HEALTH DEPARTMENT - *ENVIRONMENTAL HEALTH* ☑ STATESVILLE OFFICE 704-878-5305 ☐ MOORESVILLE OFFICE 704-664-5281

IMPROVEMENT PERMIT / AUTHORIZATION TO CONSTRUCT / OPERATION PERMIT / EXISTING SYSTEM INSPECTION

PERMIT # 17560l PIN # 4861556326

OWNER Kimberly Howser APPLICANT: Same DATE 10-26-12

SITE ADDRESS 370 Dutchman Rd. PHONE: Home/Cell # 704-872-2703 Business # N/A

SITE DIRECTIONS Hwy 90 N TL Tabor Rd TL Dutchman Rd. OWNER / APPLICANT ADDRESS 370 Dutchman Rd.

SUBDIVISION N/A BLOCK / SECTION N/A LOT # N/A LOT AREA 0.75 acres DESIGN FLOW 480 gpd L.T.A.R. 0.25

Septic Tank 1000 Gallons: STB 1012 Date 1-17-12 ☐ New System ☑ Repair ☐ Expansion System Type I II (III) IV V VI

Pump Tank Gallons: P T Date System Description:

Pump Make Model Serial # Repair System Description: 25% Reduction

No. Nitrification Fields: 1 No. Lines 5 Linear Feet 480' Maintenance Agreement Required ☐ YES ☑ NO


Trench Width 36" Max. Trench Bottom Depth 36" Gravel Depth N/A ☑ GRAVITY ☐ PRESSURE

☑ Residence No. Bedrooms 4 ☐ Business No. Persons ☐ Other No. Employees ☐ Slab ☑ Crawl Space ☐ Basement w/plumbing ☐ Basement w/o plumbing

Water Supply: ☐ Private ☑ Public ☐ Community

Comments / Conditions: Install a 25% Reduction system on contour with serial distribution. Pump & crush old septic tank. Tax Card shows house as a 4 bedroom residence.

INITIAL SITE SKETCH

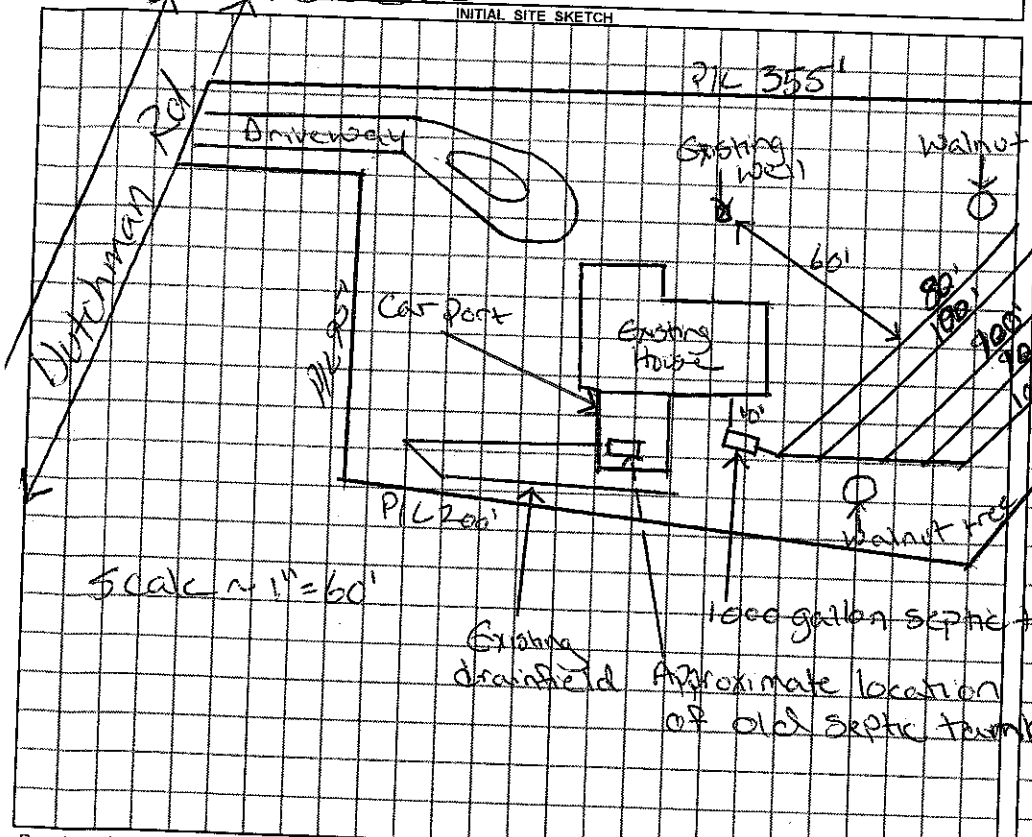

AS BUILT SKETCH

Permit can be suspended or revoked if any false information is supplied toward securing the permit / any unauthorized changes are made to the site / any unauthorized changes are made in the installation of the system.

☐ ***IMPROVEMENT PERMIT*** with plat valid without expiration. ☑ ***IMPROVEMENT PERMIT*** with plat valid without expiration. site plan valid 60 mo. ☑ ***AUTHORIZATION TO CONSTRUCT*** valid for period equal to IMPROVEMENT PERMIT--not to exceed 60 mo.

Owner / Applicant Signature: Kimberly Howser Date 10/26/12 Installed by: Piedmont Backhoe Service

IMPROVEMENT PERMIT by: Justin Henderson REHS Date 10-26-12 OPERATION PERMIT by: James REHS Date 11-2-12

AUTHORIZATION TO CONSTRUCT by: Justin Henderson REHS Date 10-26-12 Existing System Inspected by: REHS Date

YOU SHOULD CONTACT A LOCATOR SERVICE PRIOR TO ANY EXCAVATION

White Copy – Environmental Health YELLOW COPY (Final) Owner / Applicant PINK COPY (Initial) Owner / Applicant