IREDELL COUNTY HEALTH DEPARTMENT

Statesville Office (704) 878-5305 Mooresville Office (704) 660-3625 PERMIT # 218400

IMPROVEMENT PERMIT / AUTHORIZATION TO CONSTRUCT / OPERATION PERMIT / EXISTING SYSTEM

PIN # 4861-63-5898.000

APPLICANT: Benjamin Loftis APPLICANT ADDRESS: 202 Dogwood Forest Ln. Harmony NC 28634

SITE ADDRESS: 275 Dutchman Rd. Harmony NC 28634 PHONE: 704-902-0937 ALT. PHONE: 704-546-3336

SITE DIRECTIONS: Hwy 21 N, R 901, L Dutchman, Site on L


SUBDIVISION: — SECTION: — LOT # — LOT AREA: 50 Acre DESIGN FLOW: 600 GPD L.T.A.R.: .3

Septic Tank	1500	(gal)	STB	964	Date	4/12/16	☒ New System	☐ Repair	☐ Expansion	System Type: I II ☒ III IV V VI	
Pump Tank		(gal)	PT		Date		System Description:	25% Reduction - Gravity			
Pump Make			Model		Serial #		Repair System Description:	25% Reduction - Pump			
# Nitrification Fields	1		# Lines	4 @ 125'	Linear Ft:	500'	Maintenance Agreement Required:	☐ YES	☒ NO		
Trench Width	36"		Max. Trench Bottom Depth*	21" Lowside*	Gravel Depth	N/A	☒ GRAVITY	☐ PRESSURE			


☒ Residence	No. Bedrooms	5	Water Supply	
☐ Business	No. Persons	10	☐ Private	
☐ Other	No. Employees		☒ Public	
☐ Slab	☐ Crawl Space		☐ Community	
☒ Basement w/plumbing			☐ Basement w/o plumbing	

Comments / Conditions: Any Well Must Be 100' From Septic System. Follow All NC Septic Rules.

INITIAL SITE SKETCH

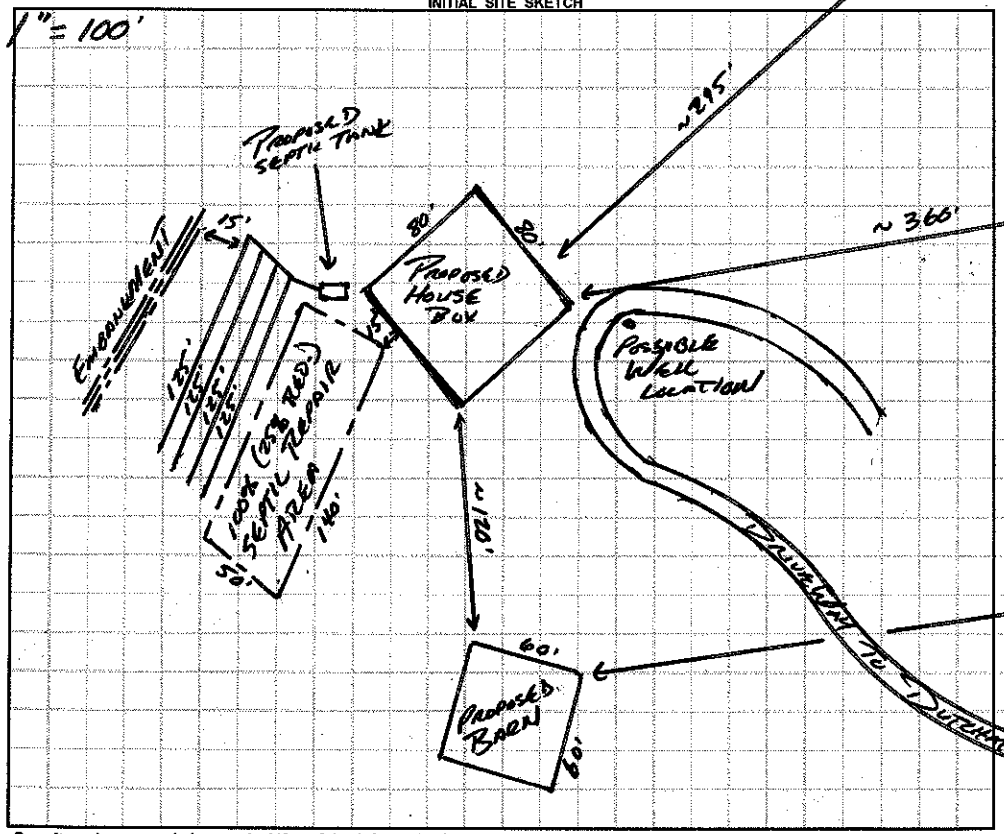

AS BUILT SKETCH

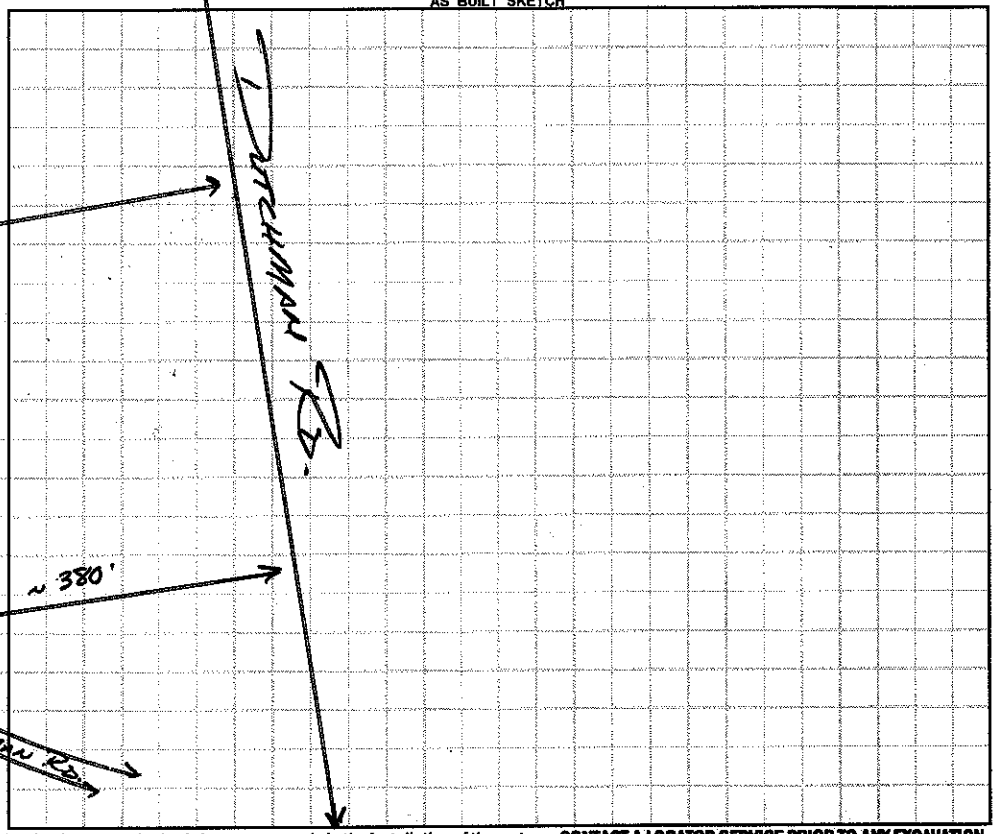

Permit can be suspended or revoked if any false information is supplied toward securing the permit / any unauthorized changes are made to the site / any unauthorized changes are made in the installation of the system. **CONTACT A LOCATOR SERVICE PRIOR TO ANY EXCAVATION**

☐ **IMPROVEMENT PERMIT** *with plat valid without expiration.* ☒ **IMPROVEMENT PERMIT** *with site plan valid for 60 mos.* ☒ **AUTHORIZATION TO CONSTRUCT** *valid for period equal to IMPROVEMENT PERMIT—not to exceed 60 mo.*

Owner / Applicant Signature: Benjamin Loftis Date: 6/16/16 Installed by: Sonny Reavis

IMPROVEMENT PERMIT by: APPROVED JUN 15 2016 Date: OPERATION PERMIT by: W Sparks Date: 10/28/16

AUTHORIZATION TO CONSTRUCT by: APPROVED JUN 15 2016 Existing System Inspected by: Date:

Health Dept. Copy - WHITE Applicant (Final Approval) - YELLOW Applicant (Conditional Approval) - PINK