IREDELL COUNTY HEALTH DEPARTMENT

STATESVILLE 704-878-5305 MOORESVILLE 704-664-5281

IMPROVEMENT PERMIT / AUTHORIZATION TO CONSTRUCT / OPERATION PERMIT / EXISTING SYSTEM INSPECTION

PERMIT# 107079 PIN# 4861-75-3081.B DATE 7-1-02

OWNER OR CONTRACTOR FLEETWOOD HOMES OF STATESVILLE Business Home 704-872-0179

ADDRESS 1270 NORTHSIDE DRIVE, STATESVILLE, NC 28677

LOCATION US 21 N, TL TABOR ROAD, TR DUTCHMAN ROAD, 0.8 MILE ON LEFT, 150' BACK

SUBDIVISION BLOCK / SECTION LOT LOT AREA 1.00 ACRE SITE CLASS PS DESIGN FLOW 600 L T A.R. 0.30 GPD/FT²

Septic Tank: 1500 Gallons: STB 1011 Date 6-16-01
Pump Tank: Gallons: PT Date
Pump Make: Model Serial No.
Nitrification Field: No Fields 1 Square Feet 2000 Linear Feet 666
No Lines SIX Trench Width 36" Max Trench Bottom Depth 36" Gravel Depth 12"

☑ New System ☐ Repair System Type: I II III IV V VI
System Description: CONVENTIONAL, GRAVITY
Repair System Description: 50% REDUCTION, PUMP
Maintenance Agreement Required: ☐ Yes ☑ No
☐ Slab ☐ Crawl Space ☐ Basement w/plumbing ☐ Basement wo/plumbing


☐ House/Mod. Home No. Bedrooms 5
☑ Mobile Home No. Bathrooms 2
☐ Business No. Employees
☐ Other

Water Supply: ☑ Individual ☐ Public ☐ Community WELL

Comments/Conditions: ① KEEP SYSTEM MINIMUM 100' FROM WELL. ② INSTALL SUBSURFACE INTERCEPT DRAINAGE DITCH. PROPERTY LINE 210.75'

Comments/Conditions: SEPTIC TANK WITH MARKER INSTALLED USING "PolyLok" FILTER

INITIAL SITE SKETCH

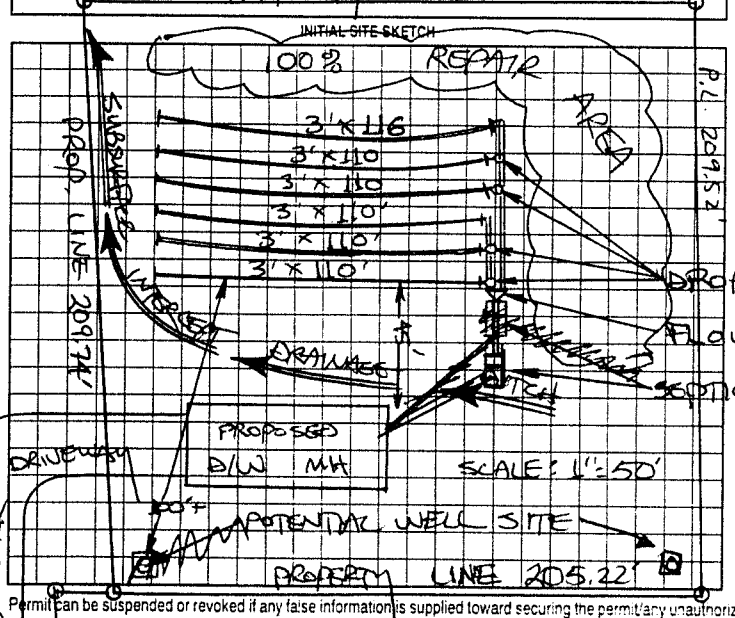

AS BUILT SKETCH

SYSTEM INSTALLED ACCORDING TO INITIAL SITE SKETCH

DROP BOXES (4)
FLOW DIVIDER TEE (1)
SEPTIC TANK (1500 GALLON)

Permit can be suspended or revoked if any false information is supplied toward securing the permit/any unauthorized changes are made to the site/any unauthorized changes are made in the installation of the system. Improvement Permit with plat valid without expiration. Improvement Permit with site plan valid for sixty months. Authorization to Construct is valid for a period equal to that of Improvement Permit – not to exceed sixty months

Signed: date 7/1/02 Installed by: CRAIG THOMPSON

Improvement Permit by: STEVE HEDRICK date 7-1-02 Operation Permit by: STEVE HEDRICK date 7-16-02

Authorization to Construct by: STEVE HEDRICK date 7-1-02 Existing System Inspection by: date

HEALTH DEPT COPY WHITE OWNER COPY (FINAL) YELLOW OWNER COPY (INITIAL) PINK