ICHD - ENVIRONMENTAL HEALTH DIVISION

Statesville Office (704) 878-5305 Mooresville Office (704) 660-3625 PERMIT # AP 327671

SEPTIC: IMPROVEMENT PERMIT / AUTHORIZATION TO CONSTRUCT / OPERATION PERMIT / EXISTING SYSTEM

PIN # 4861 -- 86 -- 9245

APPLICANT/OWNER: Antonio Bravo Sanitiz APPLICANT ADDRESS: (Yolanda Rojas)

SITE ADDRESS: 1625 W. Memorial Hwy Harmony NC 28634 PHONE: ALT. PHONE 704-431-7107

SITE DIRECTIONS: 21 N; (L) 901 W @ square of Harmony; site on (L) just past Nabors Rd


SUBDIVISION: SECTION: LOT # LOT AREA: SAP CONTROLLED: ☐ YES ☐ NO

DESIGN FLOW: Existing L.T.A.R.: Existing

Septic Tank	EXT	(gal)	STB	EXT	Date	EXT	☐ New System	☐ Repair	☐ Expansion	System Type: I II III IV V VI	☑ Residence	No. Bedrooms	EXT	Water Supply
Pump Tank		(gal)	PT		Date		System Description:				☐ Business	No. Persons		☐ Private
Pump Make			Model		Serial #		Repair System Description:	Existing			☐ Other	No. Employees		☑ Public
# Nitrification Fields	EXT		# Lines	EXT	Linear Ft	EXT	Maintenance Agreement Required:	☐ YES	☑ NO		☐ Slab	☐ Crawl Space		☐ Community
Trench Width	EXT		Trench Bottom Depth(Low side)	EXT	Gravel Depth	EXT		☐ GRAVITY	☐ PRESSURE		☐ Basement w/ plumbing		☐ Basement w/o plumbing	

Comments / Conditions: * System Functioning at time of Inspection *

INITIAL SITE SKETCH

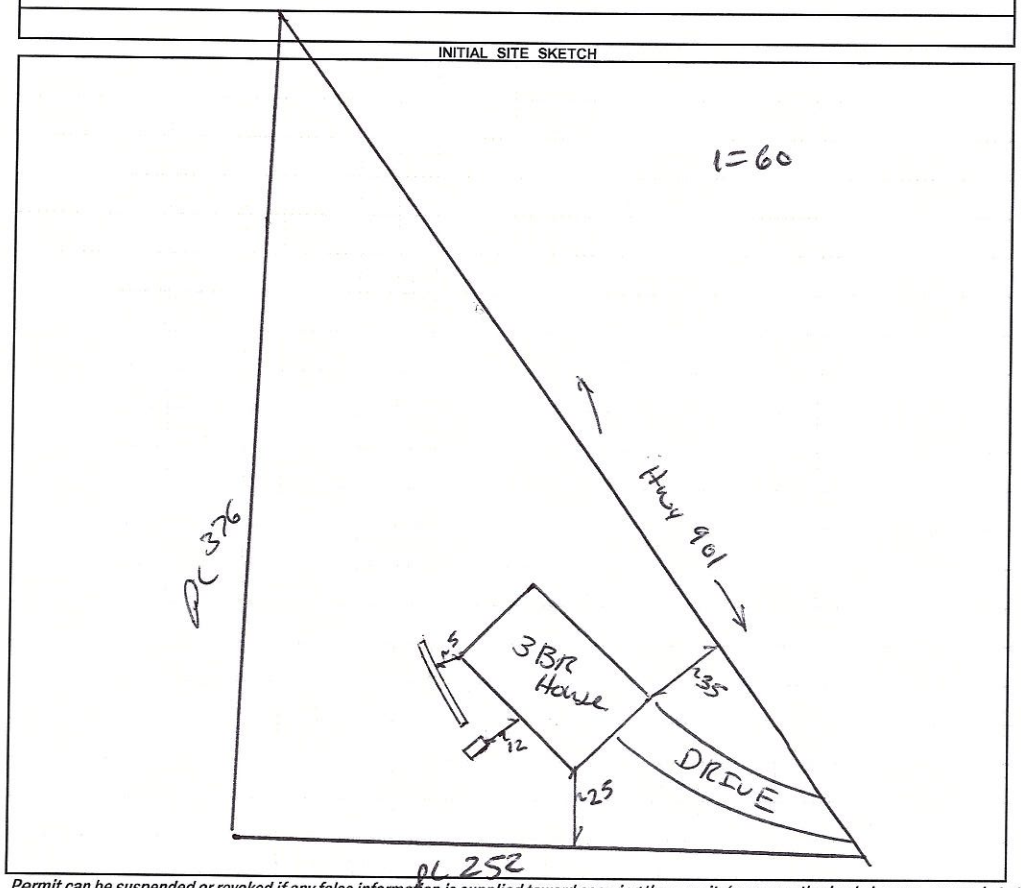

AS BUILT SKETCH

FOR SEPTIC FINAL INSPECTION CALL: 704-664-3703 between 8am-9am the day the inspection is needed. Be sure to speak with an inspector to confirm your time.

Permit can be suspended or revoked if any false information is supplied toward securing the permit / any unauthorized changes are made to the site / any unauthorized changes are made in the installation of the system. **CONTACT A LOCATOR SERVICE PRIOR TO ANY EXCAVATION**

☐ **IMPROVEMENT PERMIT** *with plat valid without expiration.* ☐ **IMPROVEMENT PERMIT** *with site plan valid for 60 mos.* ☐ **AUTHORIZATION TO CONSTRUCT** *valid for period equal to IMPROVEMENT PERMIT--not to exceed 60 mo.*

Owner / Applicant Signature: Date: 6-3-22 Installed by:

IMPROVEMENT PERMIT by: Date: OPERATION PERMIT by: Date:

AUTHORIZATION TO CONSTRUCT by: Date: Existing System Inspected by: Brianna A Bryant Date: 5-17-2022

FOR SEPTIC FINAL INSPECTION: CALL 704-664-3703 between 8am-9am the day the inspection is needed.

RECEIVED APR 1 4 2022 "Called Ready"

BB

APPLICATION MUST BE FILLED OUT COMPLETELY & BE LEGIBLE
OR IT WILL NOT BE PROCESSED RECEIVED APR 1 4 2022

Iredell County Health Department – Environmental Health Division

Relocation / Expansion

PAGE 1: *APPLICATION FORM* AP-327671 $500.00

Application For: ( ) New Well Permit ( ) Well Repair Permit ( ) Well Abandonment
(✓) Septic Improvement Permit ( ) Authorization to Construct ( ) Existing System Inspection ( ) Septic System Repair

THE ABOVE PERMIT DOCUMENTS WILL BECOME INVALID IF INFORMATION PROVIDED ON THIS APPLICATION IS FALSIFIED OR CHANGED, OR IF THE SITE IS ALTERED. THE IMPROVEMENT PERMIT IS VALID FOR EITHER 60 MONTHS OR WITHOUT EXPIRATION DEPENDING UPON DOCUMENTATION SUBMITTED. APPLICATION WITH SITE PLAN 60 MONTHS, APPLICATION WITH COMPLETE, SCALED PLAT WITHOUT EXPIRATION. SEE 15A NCAC 18A .1937(f) FOR DETAILS.

Page 2: *Site Plan Worksheet* form MUST accompany this application English Speaking

The following optional attachments may also be submitted: ( ) Survey Plat, scaled no more than 1 inch = 60 feet
Place an (X) beside whichever is submitted if applicable ( ) Custom Site Plan, scaled no more than 1 inch = 60 feet

Applicant Information: (PRINT CLEARLY) CONTACT: YOLANDA ROJAS for anything 704-431-7107

Applicant Name: Antonio Bravo Samitiz Address: _____ Zip: _____

Applicant Email: Antoniobravos777@gmail.com Phone: 336-488-0614 Alt. Phone: _____

Owner Name: The estate of James W. Morrison, Virginia Lee Morrison, Jerry Morris & Aisha Morrison Address: 757 Allen Creek Rd Zip: 28625

Owner Email: _____ Phone: Statesville 28625 NC Alt. Phone: _____

Property Information:

Street Address: 625 W. Memorial Hwy., Harmony, NC 28634

Subdivision Name: None Section/Phase: _____ Lot Number: _____

Driving Directions: _____

Site Development Information: *(check or complete ALL that apply*

(✓) New Single Family Residence (Doublewide Mobile Home) Maximum Number of Bedrooms: 3
( ) New Multi-Family Residence Maximum Number of Occupants: 6
( ) Accessory Building ( ) Swimming Pool
( ) Bedroom(s) Addition ( ) Other Addition/Structure: _____
( ) Repair to failing septic system ___ Tank ___ Drain lines Describe Problem: _____
Non-Residential Site Development: Type of Business: _____
Square Footage of Building: _____ Max. Number of Employees: _____ Max. Number of Seats/Beds/Other: _____

CHECK FOUNDATION TYPE
(✓) Crawl Space Foundation
( ) Concrete Slab Foundation
( ) Basement with Plumbing
( ) Basement without Plumbing

Water Supply: ( ) Replacement Well – Reason: _____
( ) Multi-connection Well Number of Houses: _____ Number of Persons: _____
( ) New Well ( ) Existing Well ( ) Community Well ( ) City Water (✓) Other Public Water Iredell Water & Utility Service County Water

Desired Septic System Type: *(you may rank in order of preference)* Year existing system installed: Unknown
( ) No Preference ( ) Alternative (✓) Conventional ( ) Innovative ( ) Modified Conventional ( ) Other: _____

Please answer the following to the best of your ability:
( ) Yes (✓) No Does the site contain any jurisdictional wetlands?
( ) Yes (✓) No Is any non-domestic sewage (i.e. industrial) to be generated?
( ) Yes (✓) No Is the site subject to approval by any other public agency?

I have read this application and certify that the information provided herein is true, complete, and correct. Authorized county and state officials are granted right of entry to conduct necessary inspections to determine compliance with applicable laws and rules. I understand that I am solely responsible for the proper identification and labeling of all property lines and corners and making the site accessible so that a complete site evaluation can be performed.

Signature: _____ 4-13-2022
Property owner or owner's legal representative signature (SIGNATURE REQUIRED) DATE

IREDELL COUNTY DEPARTMENT OF ENVIRONMENTAL HEALTH

DOCUMENTATION TO AUTHORIZE AN OWNER'S LEGAL REPRESENTATIVE

(Check and sign only ONE of the options below)

1. ☐ **APPLICANT AND OWNER ARE THE SAME.** * (Sign here) Virginia Lee Morrison Aisha N Morrison

Applications for permits require the "signature of the owner or owner's legal representative" (15A NCAC 18A .1937). If the owner does not sign the application himself or herself, they can submit any one of the following documents to designate their legal representative: *Power of Attorney; Real Estate Contract; Estate executor; Bankruptcy trustee; Court ordered guardianship* In the absence of the above documentation, the property owner may provide the local health department with documentation that designates a legal representative. A property owner may:
Complete this form to document his or her legal representative, or provide his or her own form that contains the information in this form. If there are multiple property owners, then all property owners must sign the form that designates a legal representative.
By signing a form that designates a legal representative for purposes of 15A NCAC 18A .1937, the property owner authorizes that representative to act on their behalf in matters pertaining to the application and permitting process, including signing or receiving any application, document or permit. The owner retains full responsibility to meet all permit conditions specified by the local health department.

2. I, The estate of James W. Morrison; Virginia Lee Morrison, Jerry Morrison & Aisha Morrison am the legal owner(s) of the property located at 625 W. Memorial Hwy, Harmony, NC 28634, identified as PIN (Parcel Identification Number) 4861-86-9245, located in Iredell County, North Carolina.

I do hereby authorize (print legal representative/company name): Antonio Bravo Samitz, to act as an agent on my behalf in applying for/signing/obtaining any of the documents described below.

- Application for Improvement Permit (IP) / Authorization to Construct (AC)
- Improvement Permit (IP) / Authorization to Construct (AC)
- Application for soil/site evaluation (new/repair)
- Application/permit for private drinking water well/well abandonment
- Application for Compliance Inspection

I agree to abide by all decisions and/or conditions between the legal representative acting on my behalf and the Iredell County Department of Public Health, Environmental Health Division.

Virginia L. Morrison
Jerry L. Morrison
Aisha N. Morrison
Signature of Owner(s)

4/13/22
Date

Mooresville - Environmental Health
Fax: 704-662-3239
610 E. Center Avenue, Mooresville, NC 28115


Statesville - Environmental Health
ronda.hart@co.iredell.nc.us
Fax: 704-871-3483
349 N. Center Street, Statesville, NC 28677

IREDELL COUNTY HEALTH DEPARTMENT

ENVIRONMENTAL HEALTH DIVISION

PAGE 2: *SITE PLAN WORKSHEET*

SEE THE "SAMPLE SITE PLAN" BELOW. *INCOMPLETE SITE PLANS WILL BE RETURNED TO YOU FOR COMPLETION AND MAY RESULT IN A DELAY IN THE ISSUANCE OF YOUR SEPTIC SYSTEM PERMIT!!!*

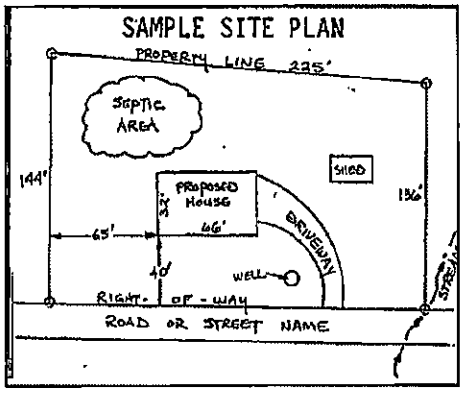

Place an (X) beside each item as you complete the site plan:

( ) **Property Line measurements are clearly identified**
( ) **All proposed structures are indicated**
( ) **Front and side setbacks from property line**
( ) **Preferred driveway location and well location**
( ) **Area you prefer your septic system to be placed**
( ) **North arrow, or other sufficient indicator of direction**

Circle N/A on the following if appropriate:

Location of septic systems and wells within 100' of your property	**N/A**
Location of easements and rights of ways on your property	**N/A**
Location of any designated wetlands on the property	**N/A**


USE THIS SPACE TO DRAW YOUR SITE PLAN

Show: proposed house or business footprint, wells, water lines, patios, pools and decks, and any other item that will occupy space on the site

See Attached

Signature: _____
Property owner or owner's legal representative signature (SIGNATURE REQUIRED)

4-13-2022
DATE

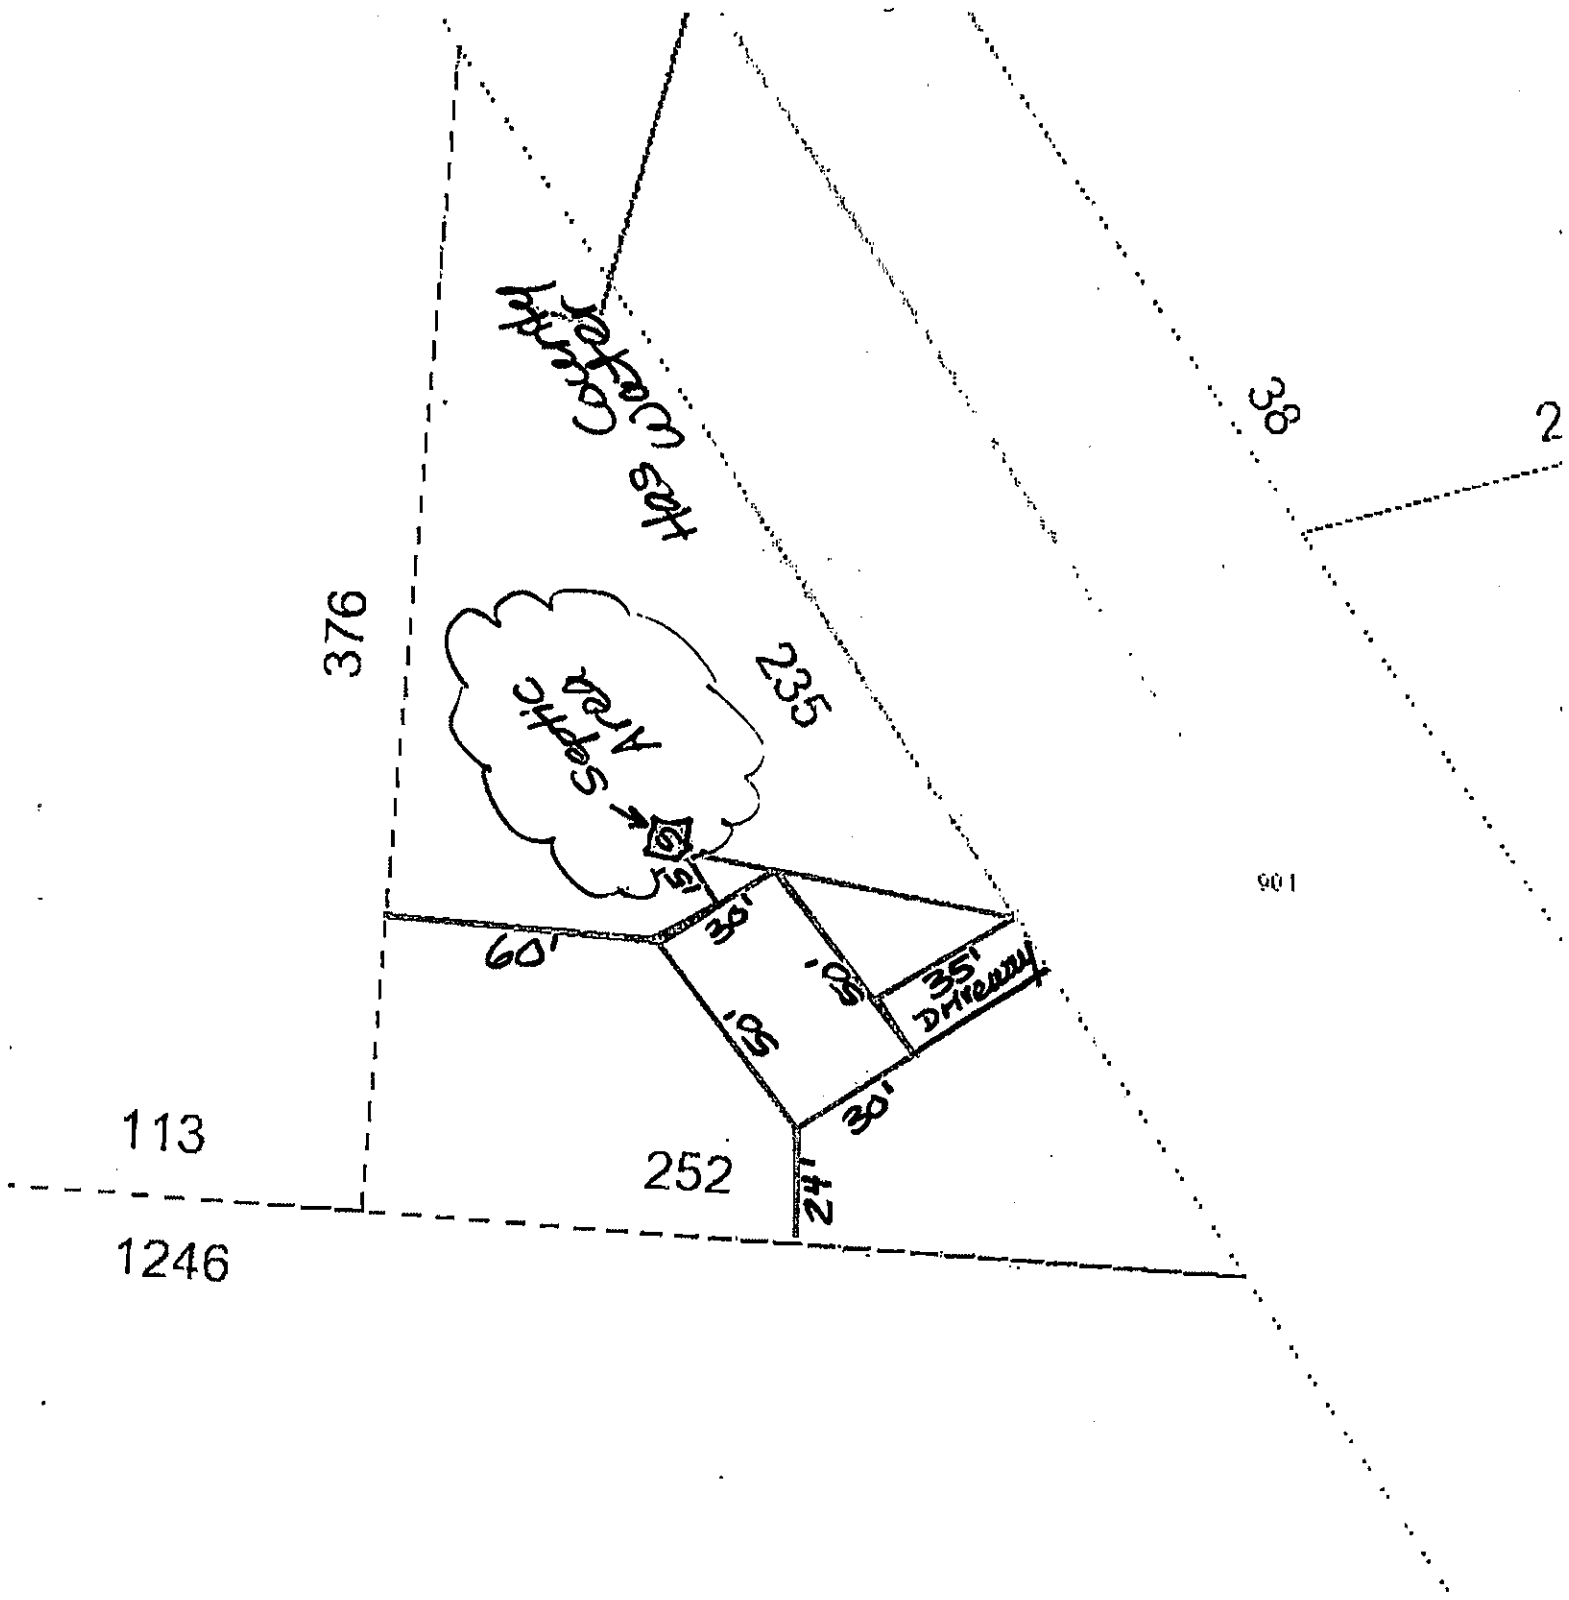
376
235
Septic Area
60'
30'
35'
Driveway
113
252
24'
1246
38
2
901

IREDELL COUNTY HEALTH DEPARTMENT

STATESVILLE 704-878-5305 MOORESVILLE 704-664-5281

IMPROVEMENT PERMIT / AUTHORIZATION TO CONSTRUCT / OPERATION PERMIT / EXISTING SYSTEM INSPECTION

DATE 12-15-00

PERMIT# 093268 PIN# 4861 86 9245

OWNER OR CONTRACTOR JAMES MORRISON PHONE: Business 878-2472 Home 873-2453

ADDRESS 625 W. MEMORIAL Hwy HARMONY NC 28634

LOCATION US 21 N, TL NC 901, LOT 4th LEFT PAST MT. NEBO CH. RD.

SUBDIVISION _____ BLOCK / SECTION _____ LOT 5 LOT AREA 1.24 Acre SITE CLASS. PS DESIGN FLOW 360 L.T.A.R. EXISTING

Septic Tank: EXISTING Gallons: STB _____ Date _____

Pump Tank: _____ Gallons: PT _____ Date _____

Pump Make: _____ Model _____ Serial No _____

Nitrification Field: No Fields 1 Square Feet _____ Linear Feet EXISTING

No Lines _____ Trench Width _____ Max Trench Bottom Depth _____

☐ New System ☑ Repair System Type: I, II, III, IV, V

System Description: CONVENTIONAL GRAVITY

Repair System Description: _____

Maintenance Agreement Required: ☐ Yes ☒ No

☐ Slab ☑ Crawl Space ☐ Basement w/plumbing ☐ Basement wo/plumbing

☐ House/Mod. Home ☒ Mobile Home ☐ Business ☐ Other


No. Bedrooms 3 No. Bathrooms 2 No. Employees _____

Water Supply: ☐ Individual ☒ Public ☐ Community


Comments/Conditions:

Comments/Conditions: SYSTEM UNDERSIZED ACCORDING TO TODAY'S STANDARDS – NO PERMIT FOUND FOR INITIAL INSTALLATION (1969)

INITIAL SITE SKETCH

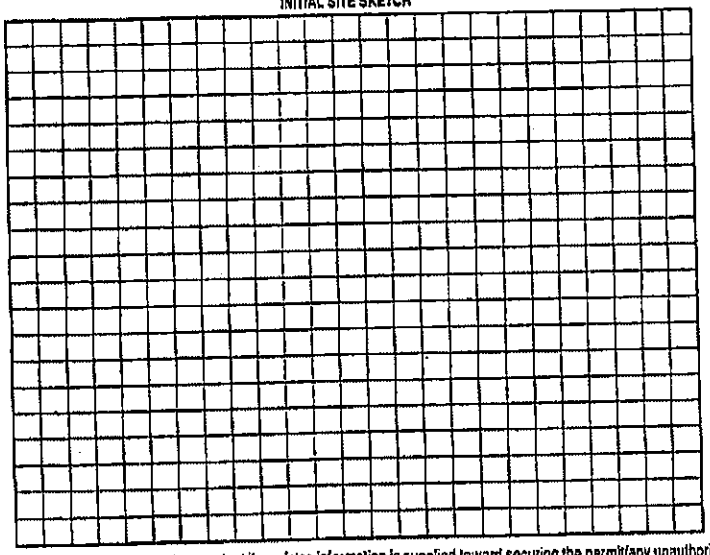

AS BUILT SKETCH

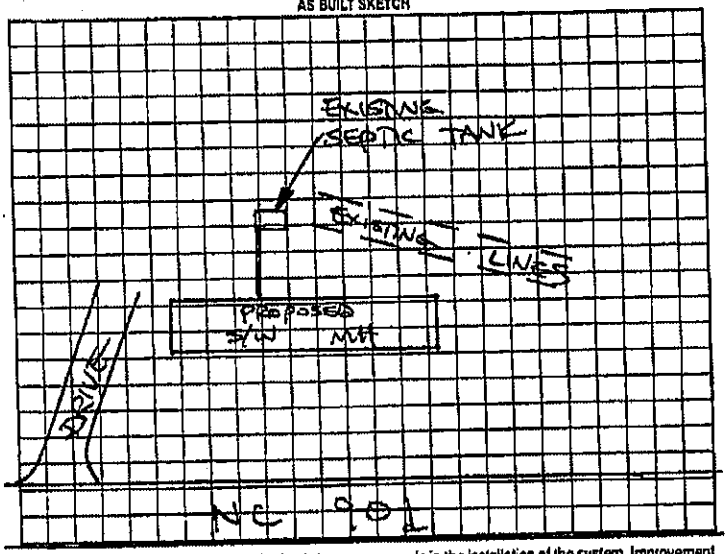

Permit can be suspended or revoked if any false information is supplied toward securing the permit/any unauthorized changes are made to the site/any unauthorized changes are made in the installation of the system. Improvement Permit with plat valid without expiration. Improvement Permit with site plan valid for sixty months. Authorization to Construct is valid for a period equal to that of Improvement Permit – not to exceed sixty months.

Signed: _____ date _____

Improvement Permit by: _____ date _____

Authorization to Construct by: _____ date _____

Installed by: _____

Operation Permit by: _____ date _____


Existing System Inspection by: STEVE HENDRICK date 12-15-00

HEALTH DEPT. COPY WHITE OWNER COPY (FINAL) YELLOW OWNER COPY (INITIAL) PINK

Acknowledgement Of
Plans Submittal ONLY!

Date 4-13-2022

Date 5-18-2022

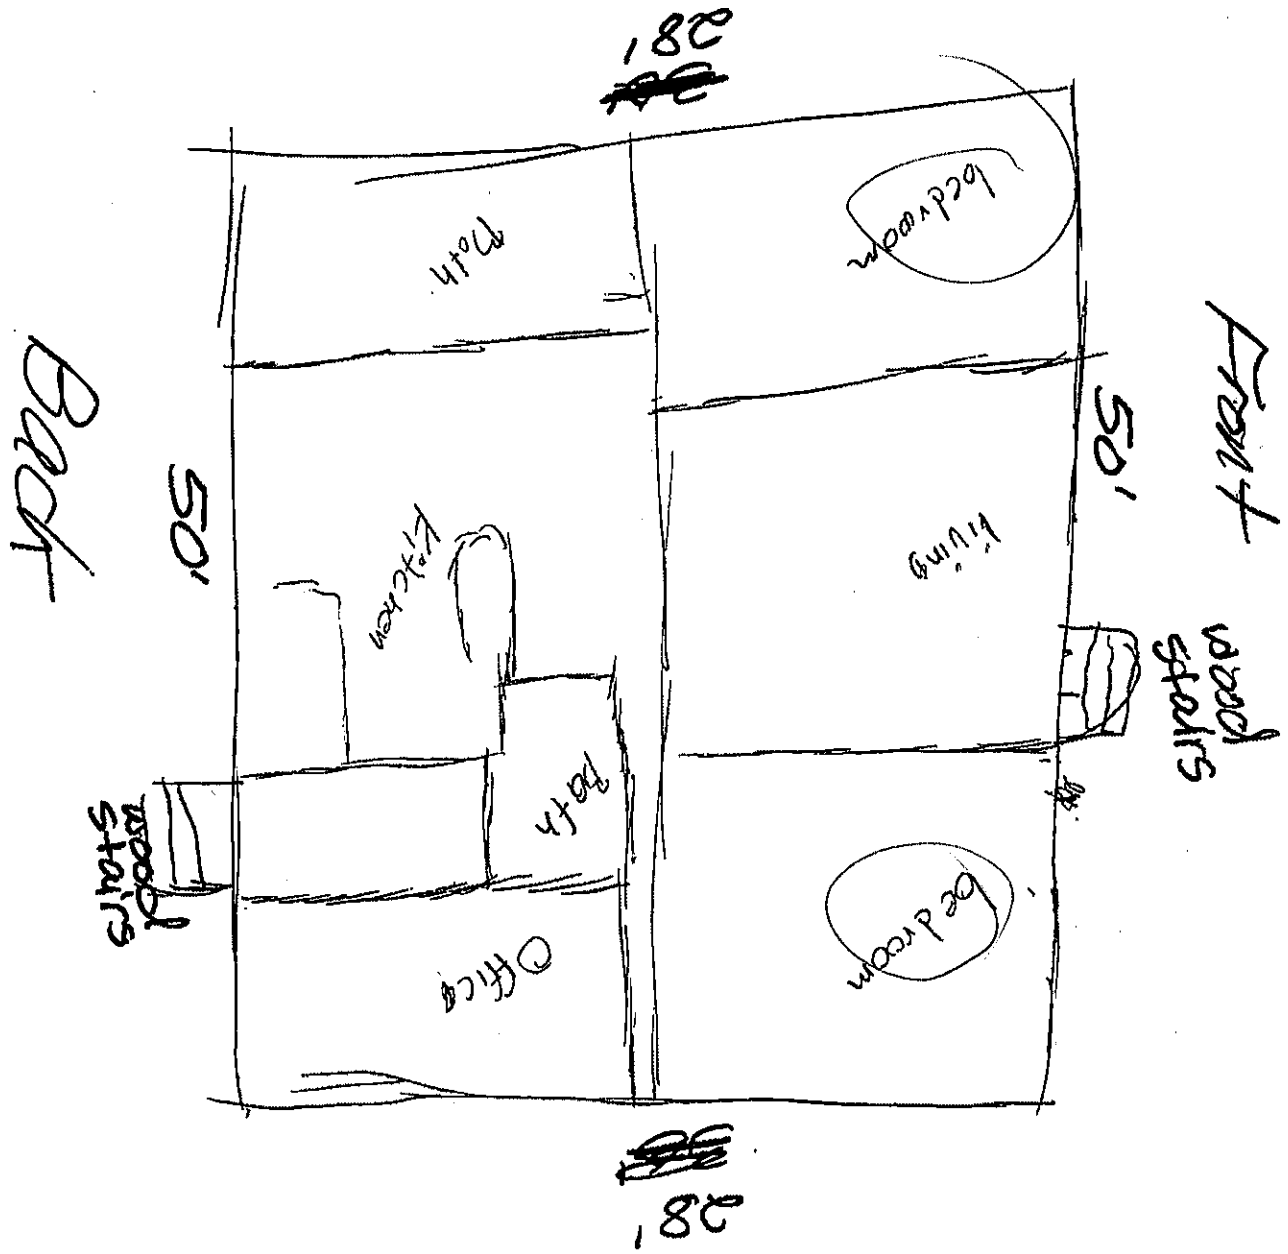

IREDELL COUNTY
PO Box 788
349 North Center St.
Statesville, NC 28677

APPLICATION NUMBER
327671
Issue Date:

Permit Type: ZONING

Parcel Number	Street Address	Jurisdiction
4861869245.000		Iredell County

Owner Information	Applicant Information
Name: MORRISON VIRGINIA L ETAL	Name: ANTONIA BRAVO SAMITIZ
Address:	Address: 352 NABORS RD
	STATESVILLE, NC 28677
Phone:	Phone: (336)488-0614

Use Requested	Zone Code
Single Family Dwelling	RA

Lot Acreage	F Setback	B Setback	L Setback	R Setback	Watershed	Flood Zone
1.24	35	35	15	15	N/A	NO

Remarks

SFD 625 W MEMORIAL

REQUIREMENTS FOR ALL MULTI -SECTIONAL MOBILE HOMES Must meet requirement R9 of the LDC. Minimum size of main body is at least 22 feet by 40 feet; Must have standard residential shingles; Minimum of 3/12 roof pitch; Must have continuous masonry underpinning; Must have minimum roof eave and raker projections of 6 inches; Must have a 36 square foot deck or porch at all front entrances; Exterior siding must consist of vinyl or aluminum lap siding, wood, or hardboard, comparable in composition, appearance and durability to residential siding; Must remove towing apparatus; Must face front property line and be no less than 20 degrees from parallel to the front property line. Original mobile home must be removed before Certificate of Occupancy can be approved.


The applicant certifies that there are no deed restrictions, contractual agreements or governmental regulations of any kind that interfere with or prohibit the use of the property or the use for which this permit is requested. The applicant further acknowledges that enforcement of deed restrictions, plat conditions and other contractual agreements will not be undertaken by Iredell County and is the sole responsibility of the affected parties.

Date: 04/13/2022

Signature of Owner/Contractor

Permit Number	327671	TOTAL FEES:	$77.25

ZONING DISCLAIMER

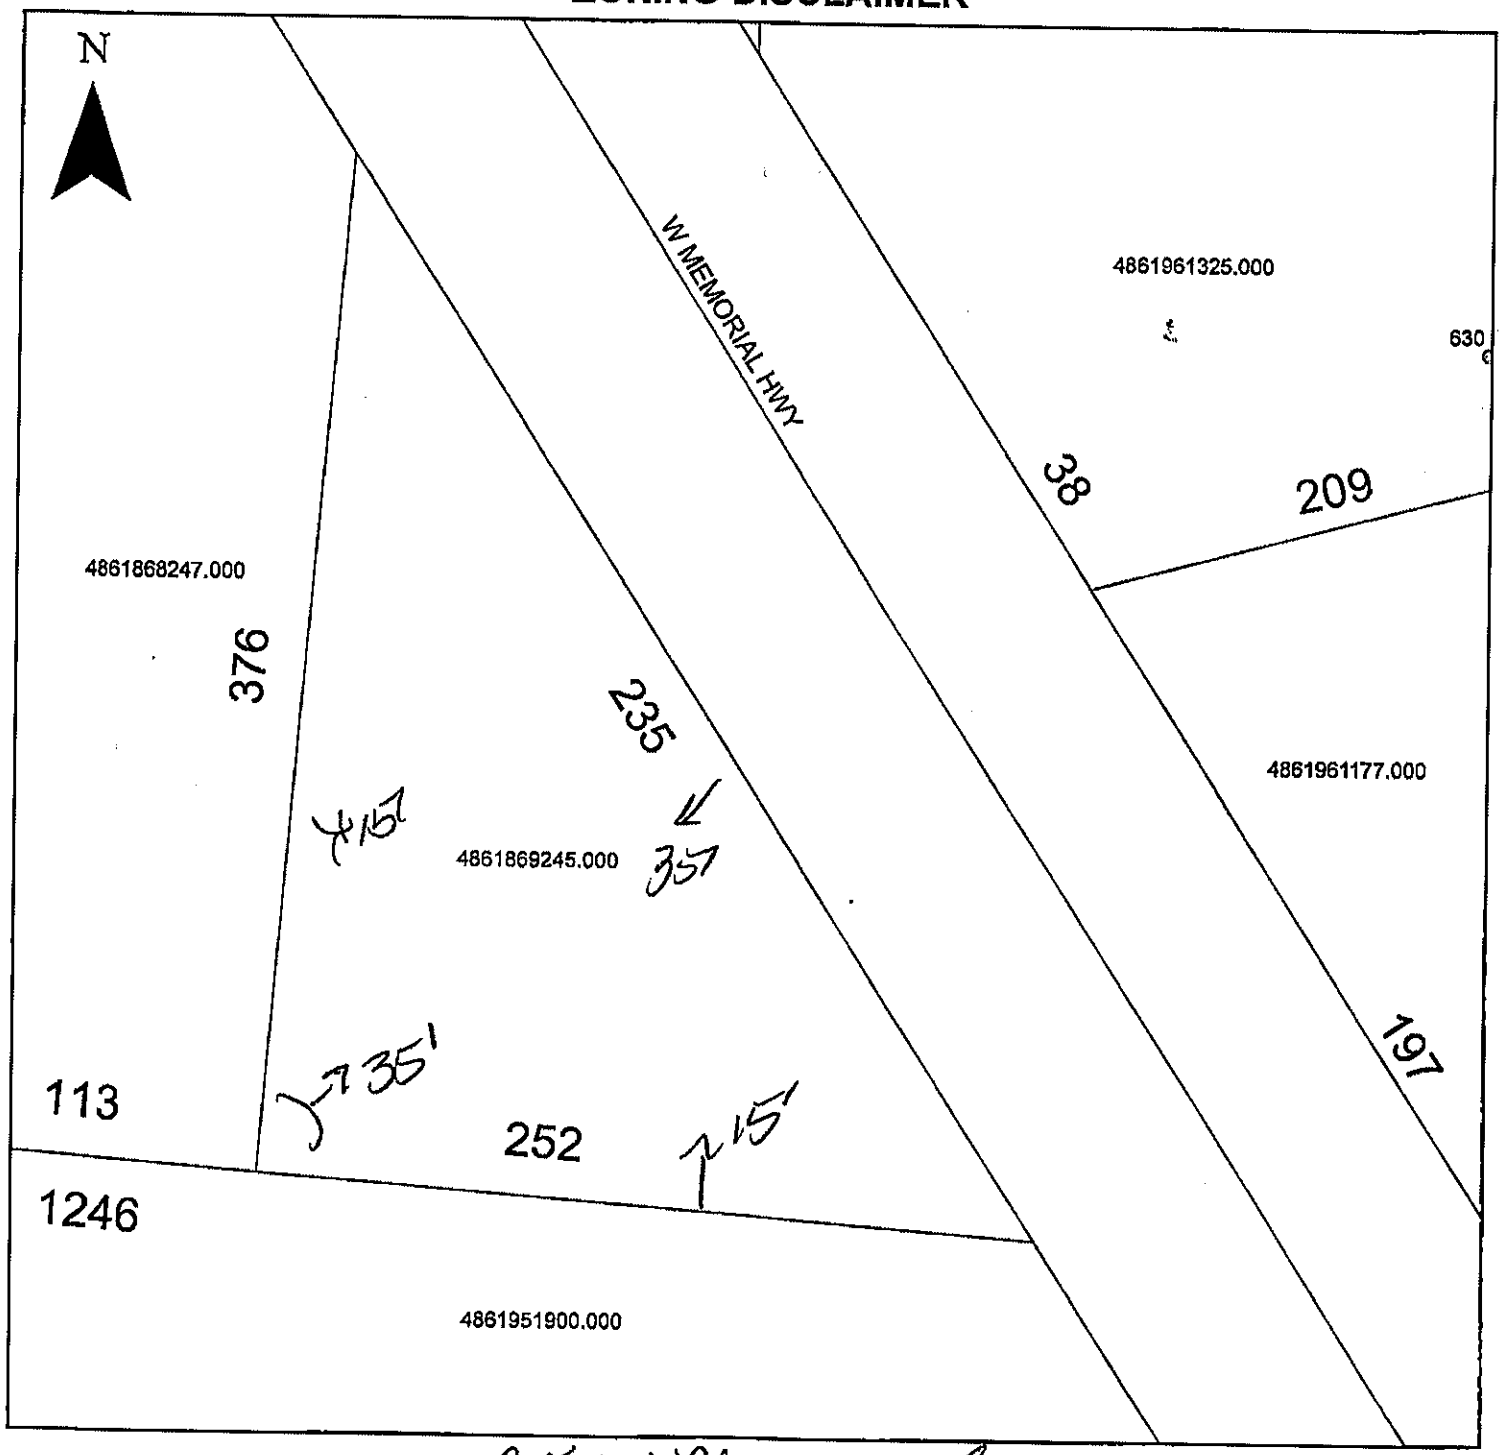

Property Address 625 W Memorial

The applicant certifies that there are no deed restrictions, contractual agreements or governmental regulations of any kind that interfere with or prohibit the use of the property or the use for which this permit is requested. Applicant further acknowledges that the enforcement of deed restrictions, plat conditions, and other contractual agreements will not be undertaken by Iredell County and is the sole responsibility of the affected parties.

Applicant

4-13-2022