Paid 125.00 DT 3:00

IREDELL COUNTY HEALTH DEPARTMENT

STATESVILLE 704-878-5305 MOORESVILLE 704-664-5281

IMPROVEMENT PERMIT / AUTHORIZATION TO CONSTRUCT / OPERATION PERMIT / EXISTING SYSTEM INSPECTION

PERMIT# 91049 PIN# 4861876258 DATE 8/31/00

OWNER OR CONTRACTOR Jimmy Steele PHONE: Business Home

ADDRESS PO Box 345 Harmony NC 28634

LOCATION 77N, R901, 4 miles on Lt, 1st MH Past Dumpsters

SUBDIVISION — BLOCK / SECTION — LOT — LOT AREA 1.1 Ac. SITE CLASS PS DESIGN FLOW 600 L.T.A.R. 0.25

Septic Tank: 1500 Gallons; STB 934 Date 8/1/00

Pump Tank: Gallons; PT Date

Pump Make: Model Serial No.

Nitrification Field: No Fields 1 Square Feet 1800 Linear Feet 600

No Lines 5 @ 120' Trench Width 36" Max Trench Bottom Depth 36" Gravel Depth —

[X] New System [ ] Repair System Type: I, II, (III), IV, V, VI

System Description: Gravity 25% Reduction

Repair System Description: Gravity PP B5

Maintenance Agreement Required: [ ] Yes [X] No

[ ] House/Mod. Home [X] Mobile Home [ ] Business [ ] Other

No. Bedrooms 5 No. Bathrooms 2 No. Employees

[ ] Slab [X] Crawl Space [ ] Basement w/plumbing [ ] Basement wo/plumbing


Water Supply: [X] Individual [ ] Public [ ] Community

Comments/Conditions:

Not To Scale

Comments/Conditions: Tanks checked 9/18/00 -GM
1st Line checked 9/18/00 -GM

INITIAL SITE SKETCH

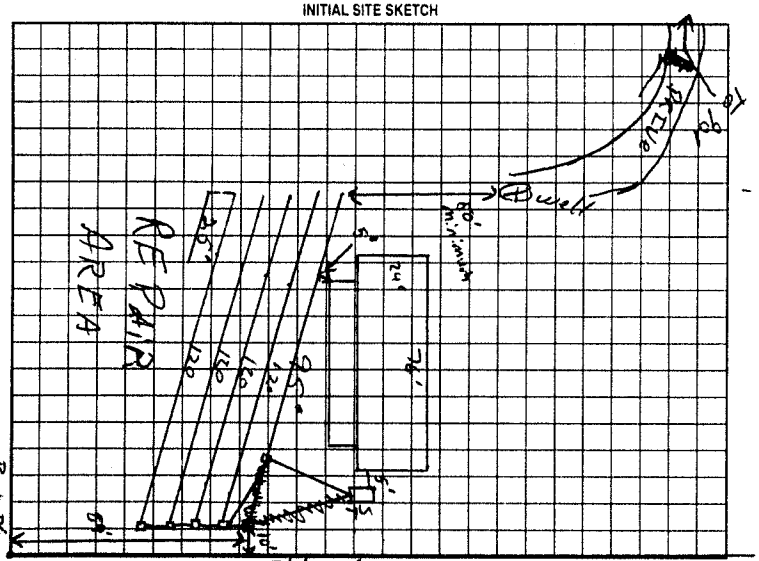

AS BUILT SKETCH

Permit can be suspended or revoked if any false information is supplied toward securing the permit/any unauthorized changes are made to the site/any unauthorized changes are made in the installation of the system. Improvement Permit with plat valid without expiration. Improvement Permit with site plan valid for sixty months. Authorization to Construct is valid for a period equal to that of Improvement Permit – not to exceed sixty months.

Signed: date 9/5/00 Installed by: Salmen's Concrete

Improvement Permit by: RSF date 8/31/00 Operation Permit by: RSI date 9/21/00

Authorization to Construct by: RSF date 8/31/00 Existing System Inspection by: date

HEALTH DEPT. COPY WHITE OWNER COPY (FINAL) YELLOW OWNER COPY (INITIAL) PINK