pd. $175.00 VP

THIS PERMIT VOIDS PREVIOUS ISSUED 9-19-2000

IREDELL COUNTY HEALTH DEPARTMENT

STATESVILLE 704-878-5305 MOORESVILLE 704-664-5281

IMPROVEMENT PERMIT / AUTHORIZATION TO CONSTRUCT / OPERATION PERMIT / EXISTING SYSTEM INSPECTION

PERMIT# 091915 PIN# 4861 87 7044 DATE 12-12-00

OWNER OR CONTRACTOR JIMMY STEELE PHONE: Business Home 539-4169

ADDRESS 143 YORKTOWN ROAD, HAMPTONVILLE, NC 27020

LOCATION I-77 N, TR NC 901, 2ND LOT ON LEFT PAST ALLEN ROAD

SUBDIVISION BLOCK / SECTION LOT LOT AREA 3.51 ACRES SITE CLASS PS DESIGN FLOW 480 L.T.A.R. 0.30 GPD/FT

Septic Tank: 1000 Gallons; STB 319 Date 5-11-00

Pump Tank: Gallons; PT Date

Pump Make: Model Serial No.

Nitrification Field: No Fields 1 Square Feet 1600 Linear Feet 533

No Lines FOUR Trench Width 36" Max Trench Bottom Depth 36" Gravel Depth 12"

☑ New System ☐ Repair System Type: I (II) III IV V VI

System Description: CONVENTIONAL GRAVITY

Repair System Description: CONV. GRAVITY

Maintenance Agreement Required: ☐ Yes ☑ No

☐ House/Mod. Home ☑ Mobile Home ☐ Business ☐ Other

No. Bedrooms 4 No. Bathrooms No. Employees


☐ Slab ☑ Crawl Space ☐ Basement w/plumbing ☐ Basement wo/plumbing

Water Supply: ☑ Individual ☐ Public ☐ Community WELL NEXT DOOR

Comments/Conditions:

Comments/Conditions: SEPTIC TANK WITH MARKER INSTALLED USING "TUFFTITE" FILTER

INITIAL SITE SKETCH

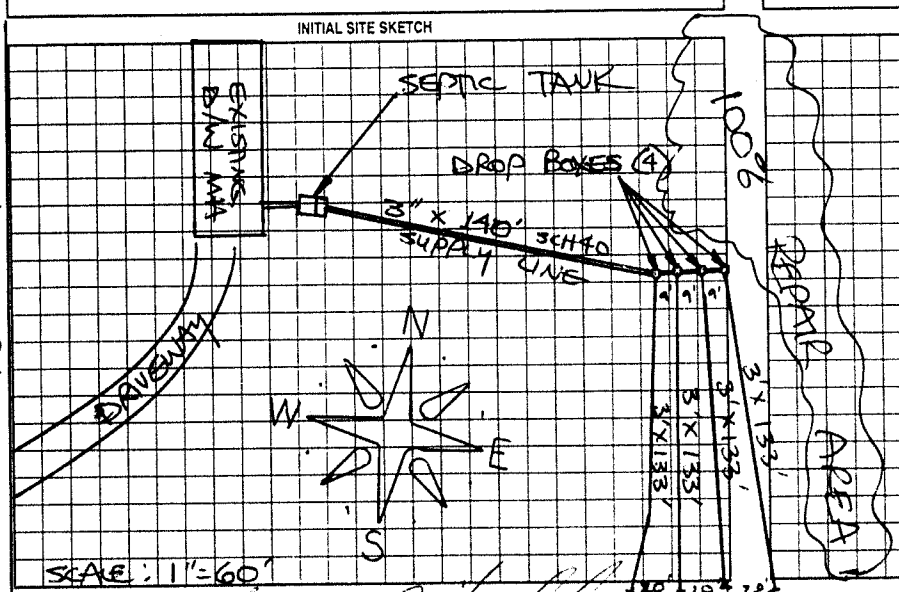

AS BUILT SKETCH

SYSTEM INSTALLED ACCORDING TO INITIAL SITE SKETCH

TO NC 901

Permit can be suspended or revoked if any false information is supplied toward securing the permit/any unauthorized changes are made to the site/any unauthorized changes are made in the installation of the system. Improvement Permit with plat valid without expiration. Improvement Permit with site plan valid for sixty months. Authorization to Construct is valid for a period equal to that of Improvement Permit – not to exceed sixty months.

Signed: date 12/13/00 Installed by: DAVID UMBARGER

Improvement Permit by: STEVE HEDRICK date 12-12-00 Operation Permit by: STEVE HEDRICK date 12-22-00

Authorization to Construct by: STEVE HEDRICK date 12-12-00 Existing System Inspection by: date

HEALTH DEPT COPY WHITE OWNER COPY (FINAL) YELLOW OWNER COPY (INITIAL) PINK