47041

IREDELL COUNTY HEALTH DEPARTMENT

STATESVILLE 704-878-5305 MOORESVILLE 704-664-5281

IMPROVEMENT PERMIT / CERTIFICATE OF COMPLETION / OPERATION PERMIT / EXISTING SYSTEM INSPECTION

PROPERTY DESCRIPTION NO. 16243 DATE 8-21-96 TAX MAP NO. 17F-A-127 Watershed: ☐ Yes ☑ No

OWNER OR CONTRACTOR DONNA ELAINE NICHOLS PHONE: Business Home 596-7450

ADDRESS RT 2 BOX 32 HARMONY NC 28634

LOCATION I-77 N, TR NC 901, TR DUTCHMAN ROAD, ON LEFT BEFORE NEBO ROAD

SUBDIVISION BLOCK / SECTION LOT LOT AREA 1 ACRE SITE CLASS PS DESIGN FLOW 360 L.T.A.R. 0.35 GPD/FT²

Septic Tank: 1000 Gallons; STB 1012 Date 5/24/96

Pump Tank: Gallons; PT Date

Pump Make: Model Serial No.

Nitrification Field: No Fields 1 Square Feet 1035 Linear Feet 345

No Lines 4 Trench Width 36" Max Trench Bottom Depth 18-36" Gravel Depth 12"

☑ New System ☐ Repair System Type: I, II, III, IV, V, VI

System Description: CONV, GRAVITY

Repair System Description: CONV, PUMP

Maintenance Agreement Required: ☐ Yes ☐ No

☑ House/Mod. Home No. Bedrooms 3

☐ Mobile Home No. Bathrooms 2

☐ Business No. Employees

☐ Other


☐ Slab ☑ Crawl Space ☐ Basement w/plumbing ☐ Basement wo/plumbing

Water Supply: ☐ Individual ☐ Community ☑ Public


Comments:

Comments: SYSTEM ALTERED TO ACCOMMODATE FUTURE GARAGE SITE

INITIAL SITE SKETCH

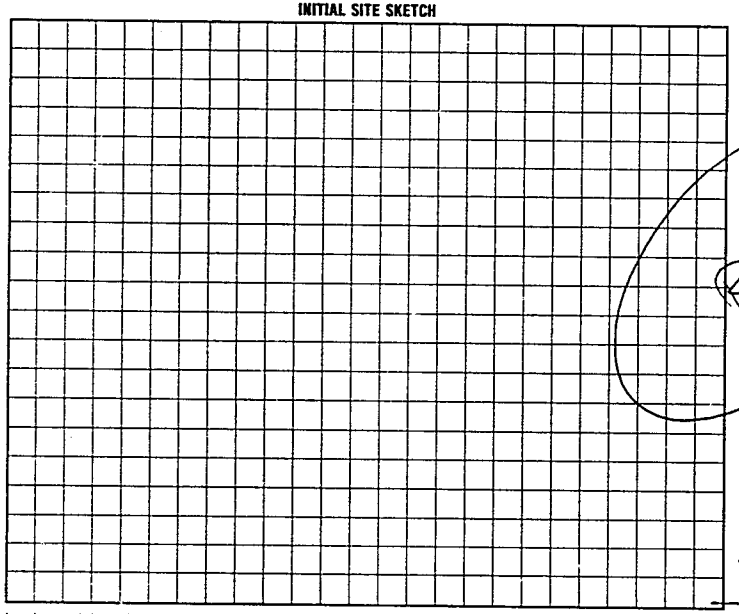

AS BUILT SKETCH

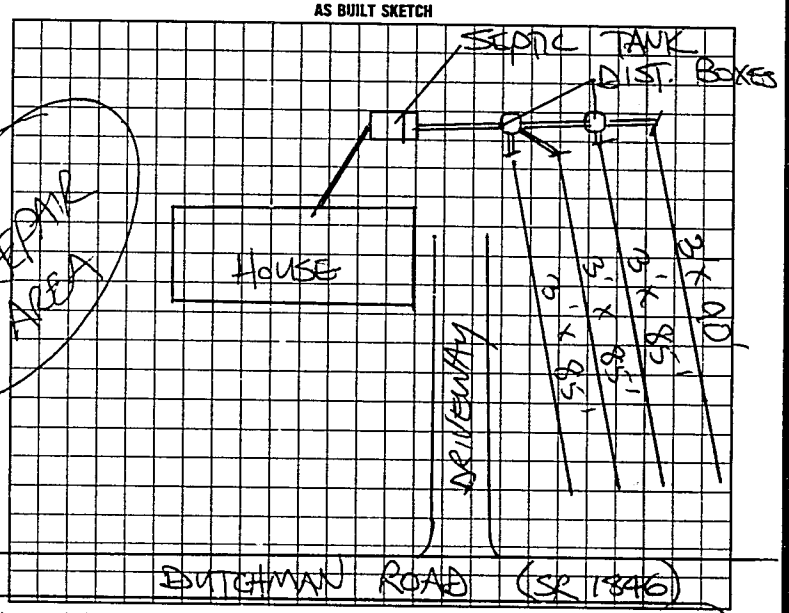

I understand that this permit can be suspended or revoked if any false information is supplied toward securing the permit/any unauthorized changes are made to the site/any unauthorized changes are made in the installation of the system.

Signed:

Improvement Permit by: STEVE HEDRICK date 4/26/93

Existing System Inspection by: date

Installed by: KENNY MADISON

~~Certificate of Completion by:~~ date

Operation Permit by: STEVE HEDRICK date 8-21-96

HEALTH DEPT. COPY: WHITE INSPECTION COPY (FINAL): GREEN OWNER COPY (FINAL): YELLOW INSPECTION COPY (INITIAL): PINK OWNER COPY (INITIAL): GOLD