IREDELL COUNTY HEALTH DEPARTMENT

STATESVILLE 704-878-5305 MOORESVILLE 704-664-5281

IMPROVEMENT PERMIT / AUTHORIZATION TO CONSTRUCT / OPERATION PERMIT / EXISTING SYSTEM INSPECTION

PERMIT# REPAIR PIN# 4861-94-1076 DATE 8-19-05

OWNER OR CONTRACTOR KATIE HOLMES PHONE: Business Home 704-546-2784

ADDRESS 171 DUTCHMAN ROAD, HARMONY, NC 28634

LOCATION I-77 NORTH, TR NC 901, TR DUTCHMAN ROAD, ON LEFT AT STACK ROAD (BOX #171)

SUBDIVISION BLOCK / SECTION LOT LOT AREA 0.8 ACRE SITE CLASS. PS DESIGN FLOW 360 L.T.A.R. 0.30 GPD/FT²

Septic Tank: EXISTING Gallons; STB Date

Pump Tank: Gallons; PT Date

Pump Make: Model Serial No.

Nitrification Field: No Fields 1 Square Feet 720 Linear Feet 240

No Lines FOUR Trench Width 36" Max Trench Bottom Depth 36" ± Gravel Depth (18")

☐ New System ☑ Repair System Type: I, II, III, IV, V, VI

System Description: CONVENTIONAL, GRAVITY

Repair System Description: CONVENTIONAL GRAVITY

Maintenance Agreement Required: ☐ Yes ☑ No

☑ House/Mod. Home No. Bedrooms 3

☐ Mobile Home No. Bathrooms 1

☐ Business No. Employees

☐ Other


☐ Slab ☑ Crawl Space ☐ Basement w/plumbing ☐ Basement wo/plumbing

Water Supply: ☐ Individual ☑ Public ☐ Community


Comments:/Conditions: ① INSTALL NEW DROP BOXES AS SHOWN FEEDING BOTH OLD & NEW DRAINLINES ② INSTALL NEW SANITARY TEE IN SEPTIC TANK ③ INSTALL LINES AS FLAGGED USING 18" STONE

Comments:/Conditions: THIS PERMIT SERVES AS "NOTICE of VIOLATION" SYSTEM TO BE REPAIRED BY SEPTEMBER 20, 2005

INITIAL SITE SKETCH ~ SCALE : 1" = 50'

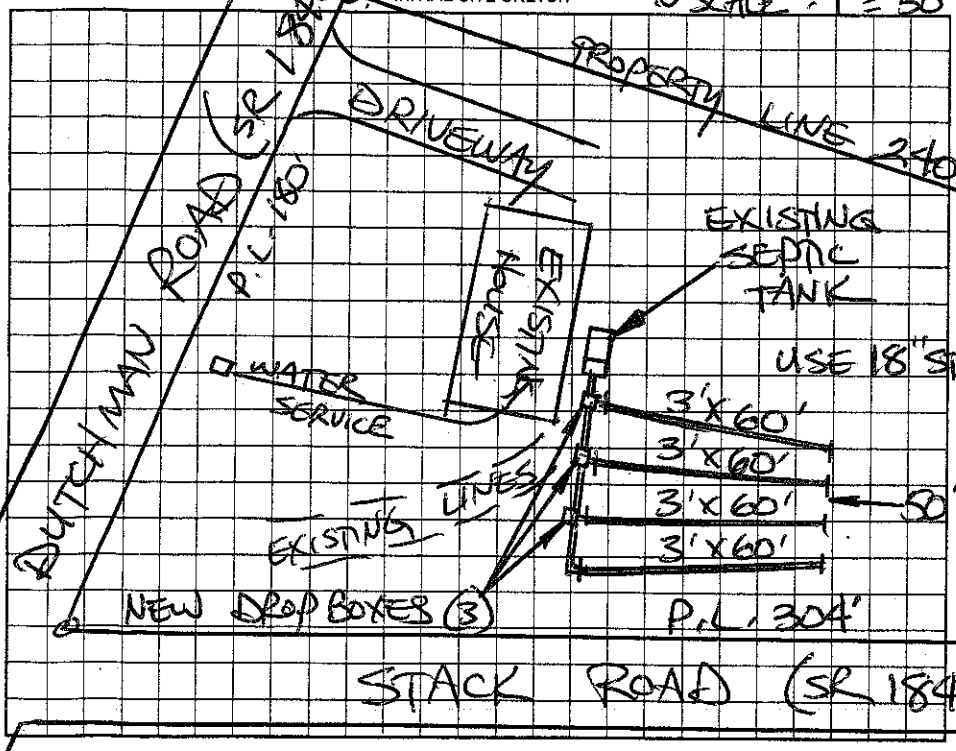

AS BUILT SKETCH

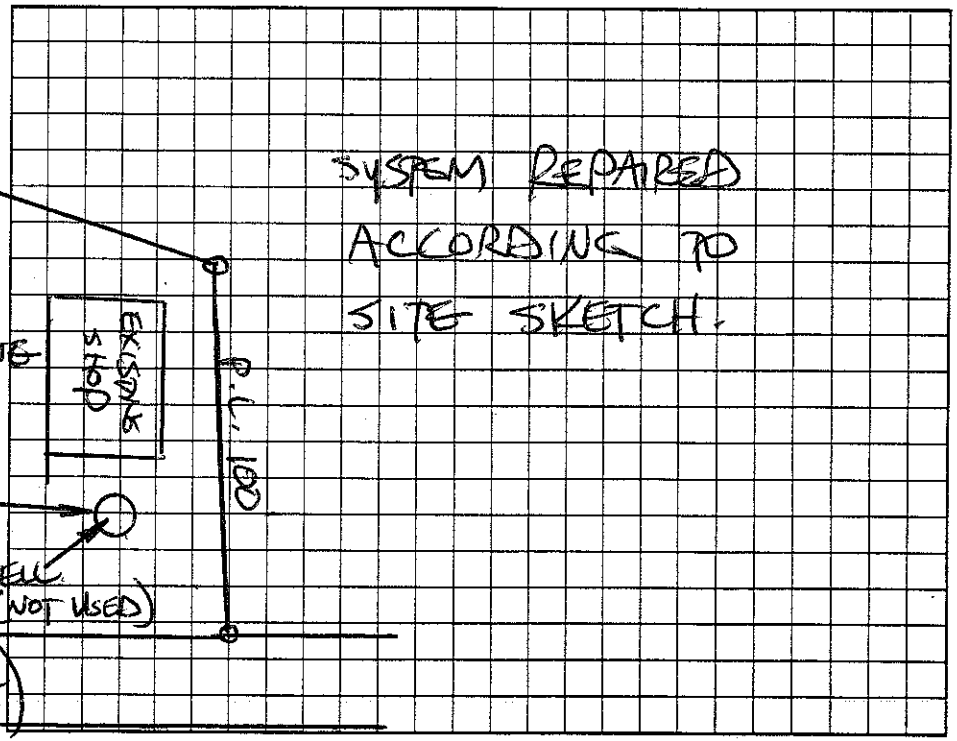

Permit can be suspended or revoked if any false information is supplied toward securing the permit/any unauthorized changes are made to the site/any unauthorized changes are made in the installation of the system. Improvement Permit with plat valid without expiration. Improvement Permit with site plan valid for sixty months. Authorization to Construct is valid for a period equal to that of Improvement Permit – not to exceed sixty months.

Signed: Katie Holmes date 8-19-05 Installed by: A-1 BACKHOE

Improvement Permit by: STEVE HEDRICK date 8-19-05 Operation Permit by: STEVE HEDRICK date 9-19-05

Authorization to Construct by: STEVE HEDRICK date 8-19-05 Existing System Inspection by: date

HEALTH DEPT. COPY: WHITE OWNER COPY (FINAL): YELLOW OWNER COPY (INITIAL): PINK