IREDELL COUNTY HEALTH DEPARTMENT

STATESVILLE 704-878-5305 MOORESVILLE 704-664-5281

IMPROVEMENT PERMIT / AUTHORIZATION TO CONSTRUCT / OPERATION PERMIT / EXISTING SYSTEM INSPECTION

PERMIT# 081211 PIN# 4871 04 8125 DATE 5-19-99

OWNER OR CONTRACTOR OSCAR TURBIVILLE PHONE: Business Home (941) 665-8119

ADDRESS 2009 POE STREET, LAKELAND, FLORIDA, 33801

LOCATION US 21 N, TL NC 901, TL DUTCHMAN ROAD, LOG HOME BEHIND FIRST HOUSE ON RIGHT

SUBDIVISION BLOCK / SECTION LOT LOT AREA 55.5 ACRES SITE CLASS PS DESIGN FLOW 360 L.T.A.R. 0.30 GPD/FT2

Septic Tank: 1000 Gallons; STB 620 Date 2-6-2000
Pump Tank: Gallons; PT Date
Pump Make: Model Serial No.
Nitrification Field: No Fields 1 Square Feet 1200 Linear Feet 400
No Lines FIVE Trench Width 36" Max Trench Bottom Depth 36"

☑ New System ☐ Repair System Type: I, II, III, IV, V, VI
System Description: CONVENTIONAL GRAVITY
Repair System Description: CONV. GRAVITY
Maintenance Agreement Required: ☐ Yes ☑ No
Gravel Depth 12"
☐ Slab ☐ Crawl Space ☑ Basement w/plumbing ☐ Basement wo/plumbing


☑ House/Mod. Home No. Bedrooms 3
☐ Mobile Home No. Bathrooms 2
☐ Business No. Employees
☐ Other

Water Supply: ☐ Individual ☑ Public ☐ Community


Comments/Conditions: ① NO VEHICULAR TRAFFIC ALLOWED OVER SEPTIC SYSTEM ② USE SEWAGE PUMP IN BASEMENT PLUMBING TO LIFT SEWAGE TO FIRST FLOOR ELEVATION

Comments/Conditions: SEPTIC TANK W/ RISERS INSTALLED USING "TUFTITE" FILTER

INITIAL SITE SKETCH

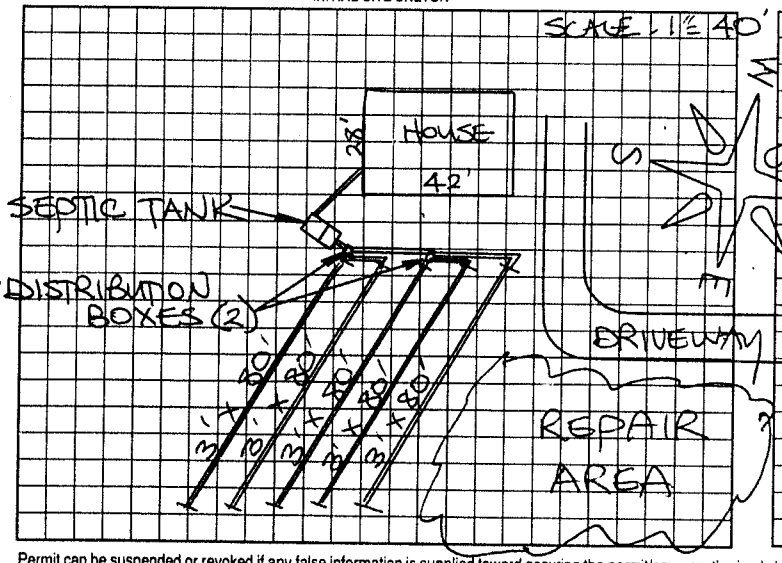

AS BUILT SKETCH

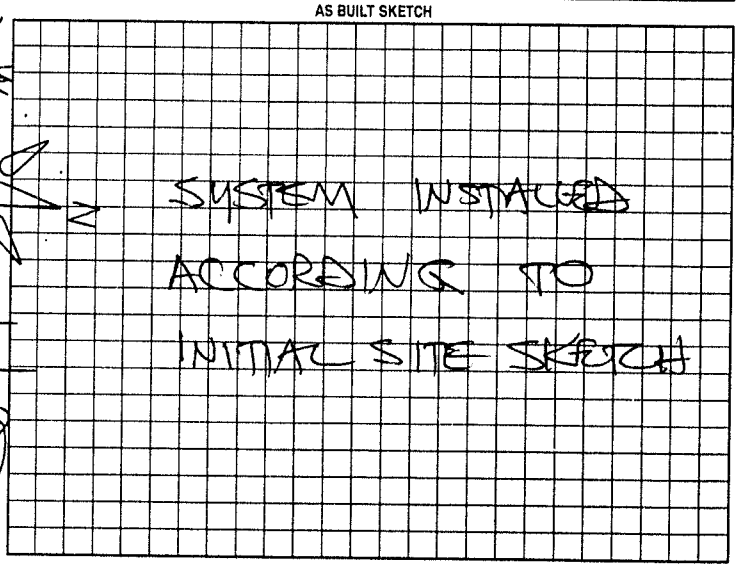

Permit can be suspended or revoked if any false information is supplied toward securing the permit/any unauthorized changes are made to the site/any unauthorized changes are made in the installation of the system. Improvement Permit with plat valid without expiration. Improvement Permit with site plan valid for sixty months. Authorization to Construct is valid for a period equal to that of Improvement Permit – not to exceed sixty months.

Signed: [signature] date 5/19/99 Installed by: SAMMY REVIS

Improvement Permit by: STEVE HENDRICK date 5-19-99 Operation Permit by: STEVE HENDRICK date 5-12-00

Authorization to Construct by: STEVE HENDRICK date 5-19-99 Existing System Inspection by: date

HEALTH DEPT COPY WHITE OWNER COPY (FINAL) YELLOW OWNER COPY (INITIAL) PINK