IREDELL COUNTY HEALTH DEPARTMENT

Statesville Office (704) 878-5305 Mooresville Office (704) 660-3625 PERMIT # 17843

IMPROVEMENT PERMIT / AUTHORIZATION TO CONSTRUCT / OPERATION PERMIT / EXISTING SYSTEM

PIN # 4861959045

APPLICANT: David Cline APPLICANT ADDRESS: 312 Old Stubbs Rd.

SITE ADDRESS: 552 N. Memorial Hwy PHONE: 704-297-5597 ALT. PHONE: N/A

SITE DIRECTIONS: Hwy 21 N Th W. Memorial Hwy Sit on R at corner of W Memorial & McMahon Farm Ln

SUBDIVISION: N/A SECTION: N/A LOT # N/A LOT AREA: 2.49 acres DESIGN FLOW: 360gpd L.T.A.R.: Existing

Septic Tank	Existing (gal)	STB	Date	☐ New System ☐ Repair ☐ Expansion	System Type: I (II) III IV V VI	☑ Residence	No. Bedrooms 3
Pump Tank	(gal)	PT	Date	System Description:	Conv Bed system	☐ Business	No. Persons
Pump Make	Model		Serial #	Repair System Description:		☐ Other	No. Employees
# Nitrification Fields	1 # Lines	Ex	Linear Ft: Ex	Maintenance Agreement Required:	☐ YES ☑ NO	☐ Slab	☑ Crawl Space
Trench Width	Ex Max. Trench Bottom Depth	Ex	Gravel Depth Ex		☑ GRAVITY ☐ PRESSURE	☐ Basement w/plumbing	☐ Basement w/o plumbing


Water Supply: ☐ Private ☑ Public ☐ Community

Comments / Conditions:

- Maintain a minimum of 5' between building foundation & all components of septic tank system

INITIAL SITE SKETCH

AS BUILT SKETCH

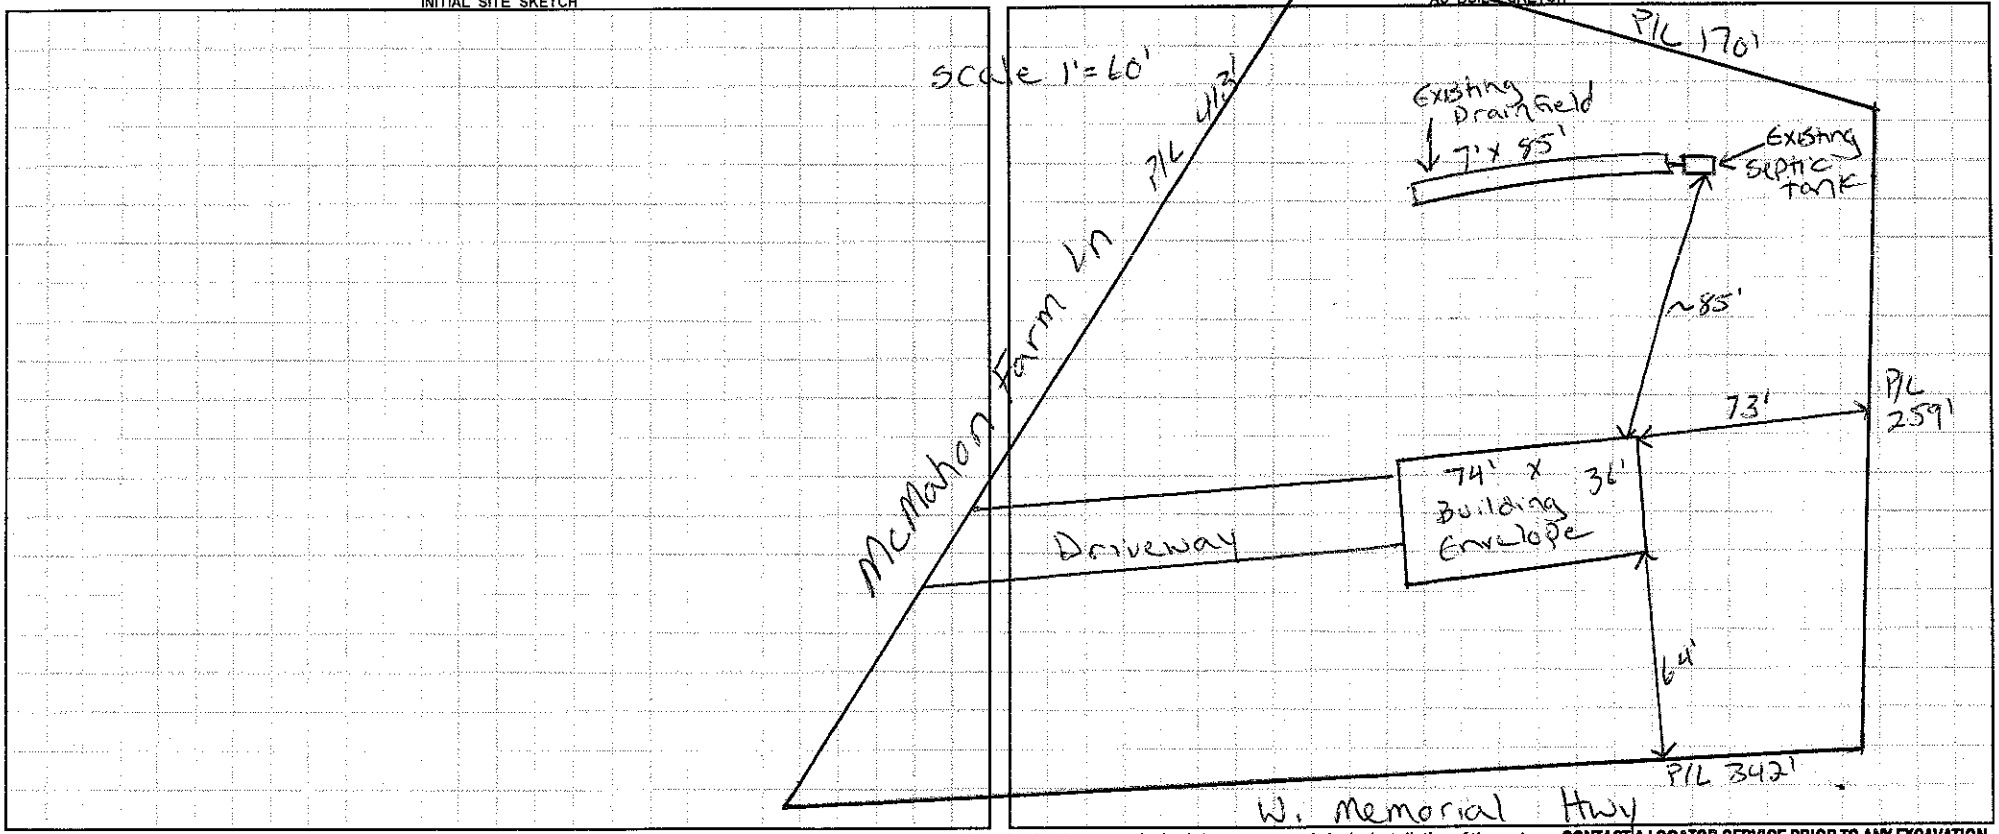

Permit can be suspended or revoked if any false information is supplied toward securing the permit / any unauthorized changes are made to the site / any unauthorized changes are made in the installation of the system. **CONTACT A LOCATOR SERVICE PRIOR TO ANY EXCAVATION**

☐ **IMPROVEMENT PERMIT** ***with plat*** *valid without expiration.* ☐ **IMPROVEMENT PERMIT** ***with site plan*** *valid for 60 mos.* ☐ **AUTHORIZATION TO CONSTRUCT** *valid for period equal to IMPROVEMENT PERMIT--not to exceed 60 mo.*

Owner / Applicant Signature: David M. Cline Date: 5/29/2013 Installed by:

IMPROVEMENT PERMIT by: Date: OPERATION PERMIT by: Date:

AUTHORIZATION TO CONSTRUCT by: Date: Existing System Inspected by: Justin Henderson Date: 5-21-13

Health Dept. Copy - WHITE Applicant (Final Approval) - YELLOW Applicant (Conditional Approval) - PINK