# IREDELL COUNTY HEALTH DEPARTMENT

STATESVILLE 704-878-5305 CI MOORESVILLE 704-664-5281

## IMPROVEMENT PERMIT / AUTHORIZATION TO CONSTRUCT / OPERATION PERMIT / EXISTING SYSTEM INSPECTION

PERMIT# 13646 PIN# 4861-96-7332 1325 DATE 9-9-03

OWNER OR CONTRACTOR TARRELL STEELE PHONE: Business 704-532-0848 Home

ADDRESS 631 WEST MOORESVILLE HWY HARMONY, NC 28634

LOCATION 77 NORTH @ 901 (L) BESIDE BOX # 618

SUBDIVISION BLOCK / SECTION LOT 2 LOT AREA .981AC SITE CLASS. PS DESIGN FLOW 360 L.T.A.R. 1.3

Septic Tank: 1000 Gallons; STB 825 Date 6-4-03

Pump Tank: Gallons; PT Date

Pump Make: Model Serial No.

Nitrification Field: No Fields 1 Square Feet EQ=1200' Linear Feet 300'

No Lines 4 Trench Width 36" Max Trench Bottom Depth 36" Gravel Depth N/A

☒ New System ☐ Repair System Type: I, II, III, IV, V, VI

System Description: GRAV 25% RED

Repair System Description: LO PRESS

Maintenance Agreement Required: ☐ Yes ☒ No

☐ House/Mod. Home ☒ Mobile Home ☐ Business ☐ Other

No. Bedrooms 3 No. Bathrooms 2 No. Employees


☐ Slab ☒ Crawl Space ☐ Basement w/plumbing ☐ Basement wo/plumbing

Water Supply: ☐ Individual ☒ Public ☐ Community

Comments:/Conditions: ① SYSTEM & HOUSE IS FLAGGED W/ ② MATCHED SETBACKS ③ INSTALL LINER ON LOW LOOKERS

Comments:/Conditions: POLYLOK FILTER & MARKER HOUSE NOT SET UP @ TIME OF CHECK

INITIAL SITE SKETCH

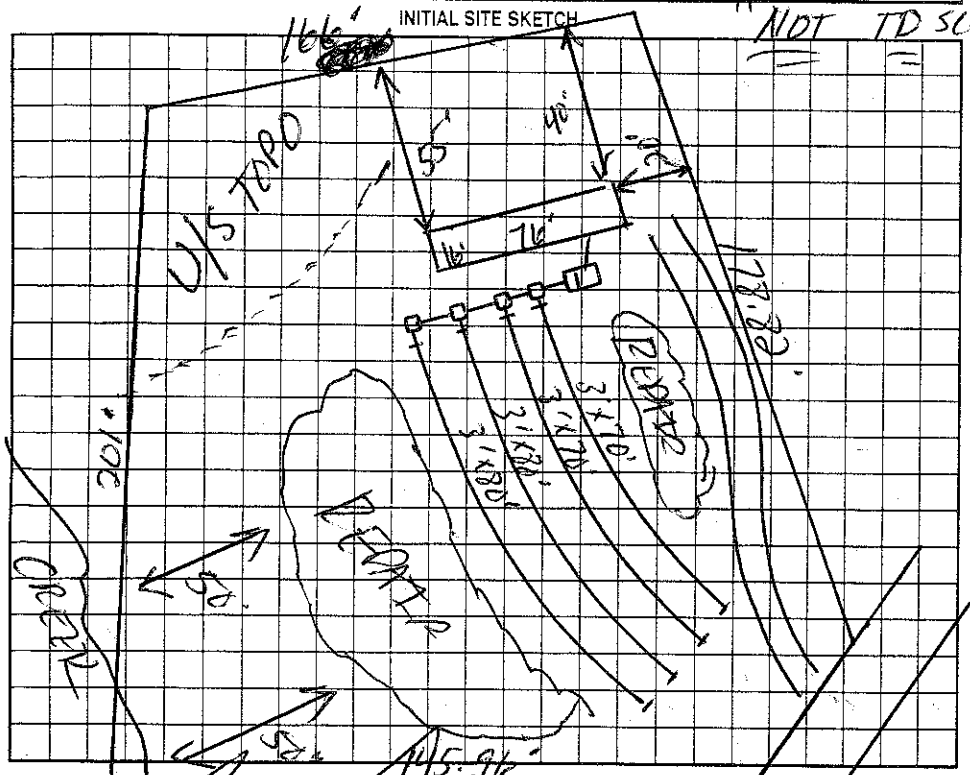


AS BUILT SKETCH

INSTALLED AS DRAWN

Permit can be suspended or revoked if any false information is supplied toward securing the permit/any unauthorized changes are made to the site/any unauthorized changes are made in the installation of the system. Improvement Permit with plat valid without expiration. Improvement Permit with site plan valid for sixty months. Authorization to Construct is valid for a period equal to that of Improvement Permit – not to exceed sixty months.

Signed: date 9-9-03 Installed by: ANDY DAVIS

Improvement Permit by: date 9-9-03 Operation Permit by: date 9-12-03

Authorization to Construct by: date 9-9-03 Existing System Inspection by: date

HEALTH DEPT. COPY: WHITE OWNER COPY (FINAL): YELLOW OWNER COPY (INITIAL): PINK