# IREDELL COUNTY HEALTH DEPARTMENT

STATESVILLE 704-878-5305 (C1) MOORESVILLE 704-664-5281

## IMPROVEMENT PERMIT / AUTHORIZATION TO CONSTRUCT / OPERATION PERMIT / EXISTING SYSTEM INSPECTION

PERMIT# 109820 PIN# 4861-96-2964 DATE 12-13-02

OWNER OR CONTRACTOR FREEDOM HOMES PHONE: Business 704-528-9449 Home

ADDRESS 1018 CHARLOTTE HWY, TROUTMAN, NC 28625

LOCATION US 21 N, TL NC 901, TR, KIMMON (NEBO) ROAD LONG DRIVE ON LEFT BEFORE INTERSECTION

SUBDIVISION BLOCK / SECTION LOT LOT AREA 145' x 200' SITE CLASS. PS DESIGN FLOW 480 L.T.A.R. 0.30 GPD/FT²

Septic Tank: EXISTING Gallons; STB Date

Pump Tank: Gallons; PT Date

Pump Make: Model Serial No.

Nitrification Field: No Fields 1 Square Feet EQ.TO 1200 Linear Feet 200

No Lines FOUR Trench Width 24" Max Trench Bottom Depth 36" ~~Gravel~~ Depth SAND 6"

☑ New System ☐ Repair System Type: I, II, (III), IV, V, VI

System Description: 50% REDUCTION, GRAVITY

Repair System Description: 50% REDUCTION LOW-PRESSURE

Maintenance Agreement Required: ☐ Yes ☑ No

☐ House/Mod. Home ☑ Mobile Home ☐ Business ☐ Other

No. Bedrooms 4 No. Bathrooms 2 No. Employees

☐ Slab ☑ Crawl Space ☐ Basement w/plumbing ☐ Basement wo/plumbing


Water Supply: ☑ Individual ☐ Public ☐ Community WELL

Comments:/Conditions: ① INSTALL 50% REDUCTION SYSTEM USING 44 PPBPS PANELS DISTRIBUTED AS SHOWN ② SEE ATTACHED EASEMENT (15A NCAC 18A .1938 (j))


Comments:/Conditions:

INITIAL SITE SKETCH

~SCALE: 1" = 40'

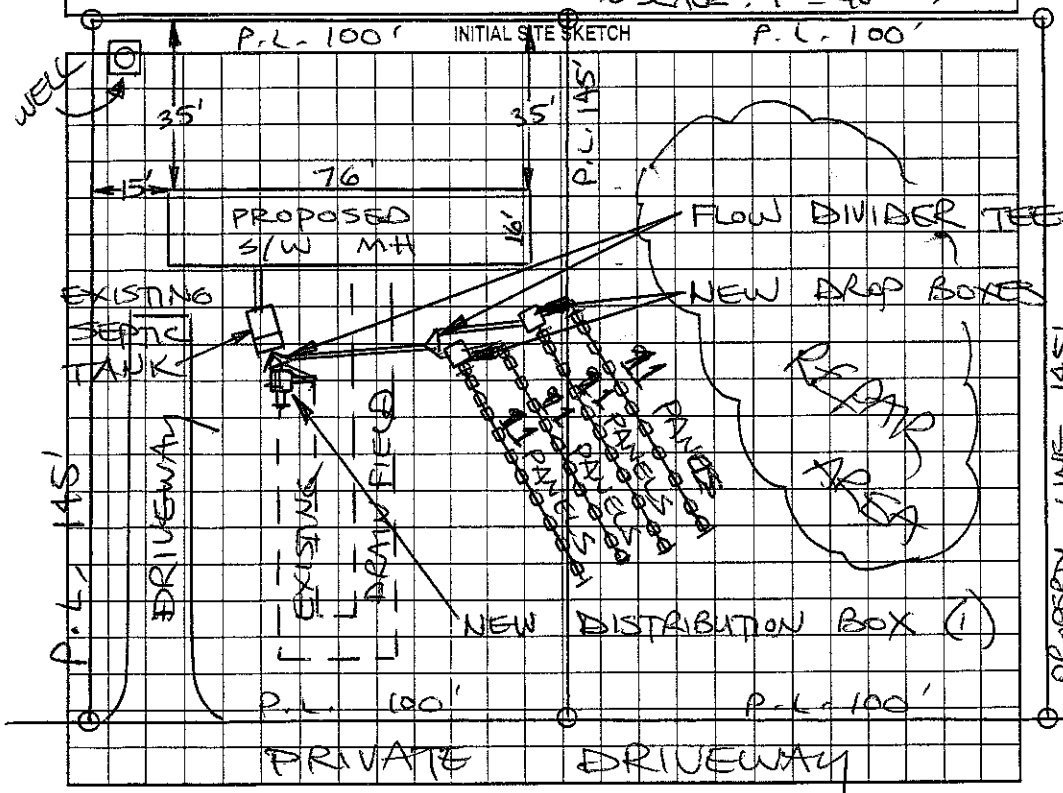


AS BUILT SKETCH

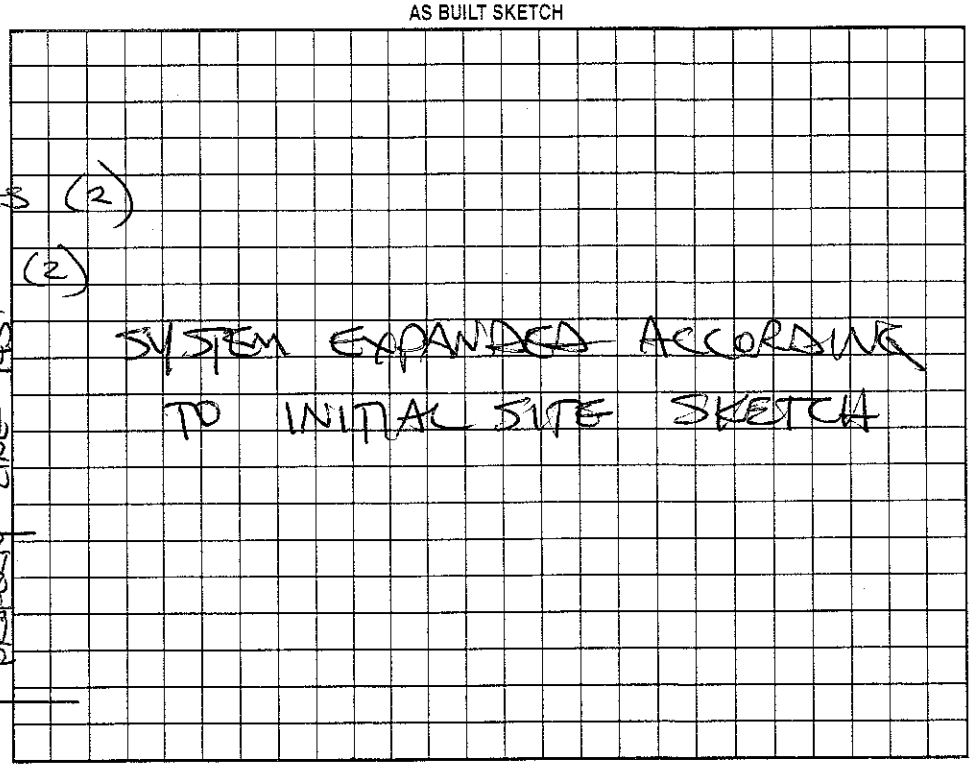


Permit can be suspended or revoked if any false information is supplied toward securing the permit/any unauthorized changes are made to the site/any unauthorized changes are made in the installation of the system. Improvement Permit with plat valid without expiration. Improvement Permit with site plan valid for sixty months. Authorization to Construct is valid for a period equal to that of Improvement Permit – not to exceed sixty months.

Signed: Janice S Graham date 12-23-02 Installed by: A-1 BACKHOE

Improvement Permit by: STEVE HEDRICK date 12-13-02 Operation Permit by: STEVE HEDRICK date 1-13-03

Authorization to Construct by: STEVE HEDRICK date 12-13-02 Existing System Inspection by: date

HEALTH DEPT. COPY: WHITE OWNER COPY (FINAL): YELLOW OWNER COPY (INITIAL): PINK