42572

# IREDELL COUNTY HEALTH DEPARTMENT

STATESVILLE 704-878-5305 MOORESVILLE 704-664-5281

## IMPROVEMENT PERMIT / CERTIFICATE OF COMPLETION / OPERATION PERMIT / EXISTING SYSTEM INSPECTION

PROPERTY DESCRIPTION NO. 14138 DATE 6-4-93 TAX MAP NO. 16J-A-56

OWNER OR CONTRACTOR Jimmy Wall PHONE: Business _____ Home _____

ADDRESS _____

LOCATION I-77 N TR N.C. 901 1ST MH ON LEFT

SUBDIVISION _____ BLOCK / SECTION _____ LOT _____ LOT AREA average SITE CLASS. _____ L.T.A.R. .3 gal/sq'/day

Water Supply: ☑ Individual ☐ Community ☐ Public

Septic Tank: 1000 Gallons: STB 358 Date 4-12-93

Pump Tank: _____ Gallons: PT _____ Date _____

Nitrification Field: No Fields 1 Square Feet 1075 Linear Feet 365

No Lines 3 Trench Width 36 Trench Depth 24 Gravel Depth 12

☑ New System ☐ Repair System Type: I, II, III, IV, V, VI

System Description: Conv. Gravity

Repair System Description: CONV, Pump

Maintenance Agreement Required: ☐ Yes ☑ No

☐ House/Mod. Home ☑ Mobile Home ☐ Business ☐ Other

No. Bedrooms 3 No. Bathrooms 2 No. Employees _____

Garbage Disposal: ☐ Yes ☑ No

Auto. Dishwasher: ☐ Yes ☐ No

Auto. Washing Machine: ☑ Yes ☐ No


Other _____

☐ Slab ☑ Crawl Space ☐ Basement w/plumbing ☐ Basement wo/plumbing

Comments ① ~~PERC~~ SUBSURFACE DIVERSION DRAINAGE DITCH CONSTRUCTED AT LOCATION SHOWN BEGINNING ~ 45" DEEP. ② GUTTER DRAINS ON EAST SIDE OF MH SHOULD BE PIPED INTO SUBSURFACE DIVERSION DITCH.

INITIAL SITE SKETCH

AS BUILT SKETCH

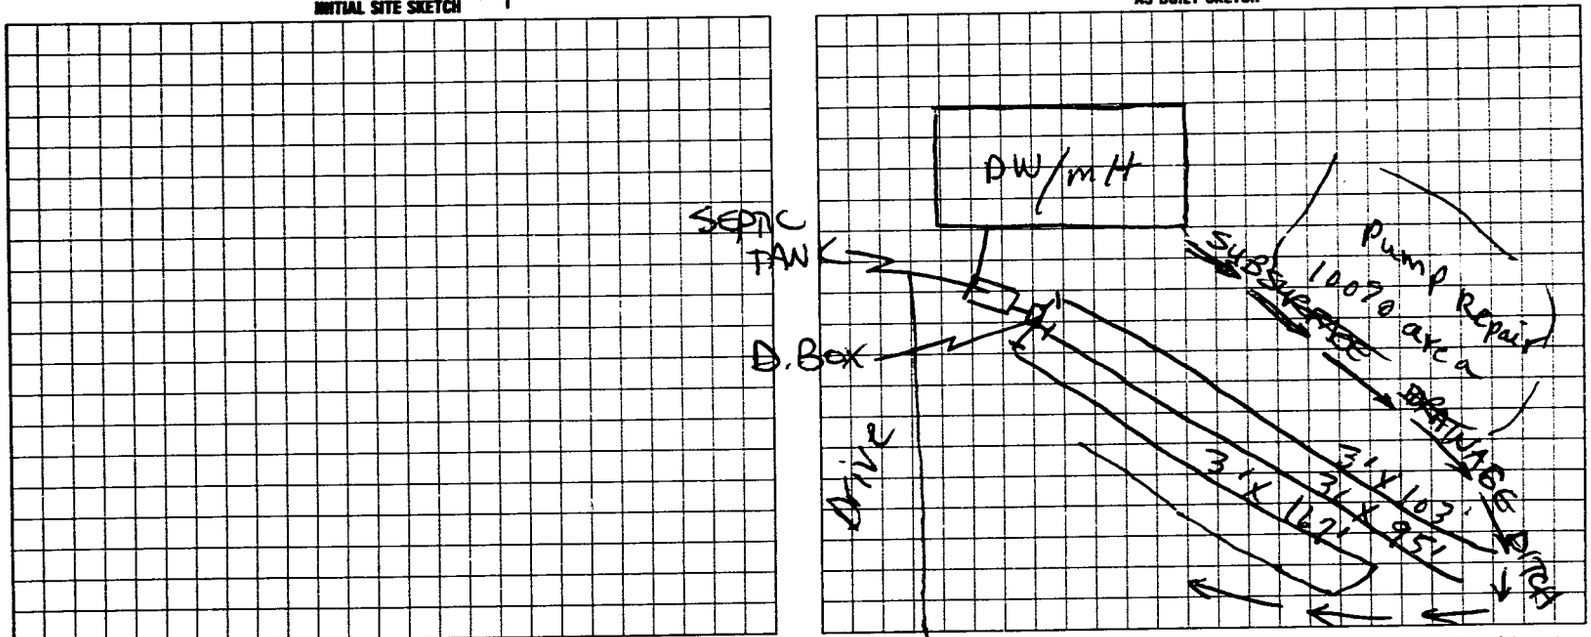


I understand that this permit can be suspended or revoked if any false information is supplied toward securing the permit/any unauthorized changes are made to the site/any unauthorized changes are made in the installation of the system. Improvement Permit is valid for 60 months from date of issuance.

Signed: _____

Improvement Permit by: STEVE HENDRICK date _____

Existing System Inspection by: _____ date _____

Installed by: A-1 BACKHOE

Certificate of Completion by: J.C. MOORE / STEVE HENDRICK date 6/25/93

Operation Permit by: _____ date _____

HEALTH DEPT. COPY: WHITE INSPECTION COPY (FINAL): GREEN OWNER COPY (FINAL): YELLOW INSPECTION COPY (INITIAL): PINK OWNER COPY (INITIAL): GOLD