IREDELL COUNTY HEALTH DEPARTMENT

STATESVILLE 704-878-5305 MOORESVILLE 704-664-5281

IMPROVEMENT PERMIT / AUTHORIZATION TO CONSTRUCT / OPERATION PERMIT / EXISTING SYSTEM INSPECTION

PERMIT# _____ PIN# _____ DATE 6-9-99

OWNER OR CONTRACTOR Winfield Snow PHONE: Business _____ Home 8763311

ADDRESS 188 Crater Rd Union Grove

LOCATION I-77 N TR 901 TL Winthrop TR Crater 2nt House left

SUBDIVISION _____ BLOCK / SECTION _____ LOT _____ LOT AREA acreage SITE CLASS PS DESIGN FLOW 240 L.T.A.R. .3

Septic Tank: 1000 Gallons; STB 620 Date 5-10-99

Pump Tank: _____ Gallons; PT _____ Date _____

Pump Make: _____ Model _____ Serial No. _____

Nitrification Field: No Fields ___ Square Feet 810 Linear Feet 270

No Lines 3 Trench Width 36" Max Trench Bottom Depth 36" Gravel Depth 12"

~~New System~~ ~~Repair~~ System Type: I (II) III, IV, V, VI

System Description: _____

Repair System Description: Conv. Gravity

Maintenance Agreement Required: Yes ~~No~~

Slab ~~Crawl Space~~ Basement w/plumbing Basement wo/plumbing

~~House~~/Mod. Home No. Bedrooms 2

Mobile Home No. Bathrooms 1

Business No. Employees _____

Other _____


Water Supply: ~~Individual~~ Public ☐ Community

Comments/Conditions:


Comments/Conditions:

Repair by abandoning Ex. System & installing New one as shown.

INITIAL SITE SKETCH

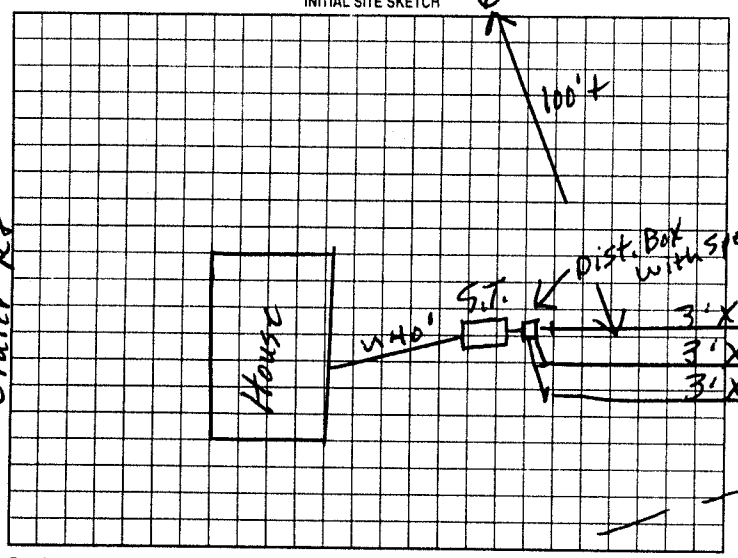

AS BUILT SKETCH

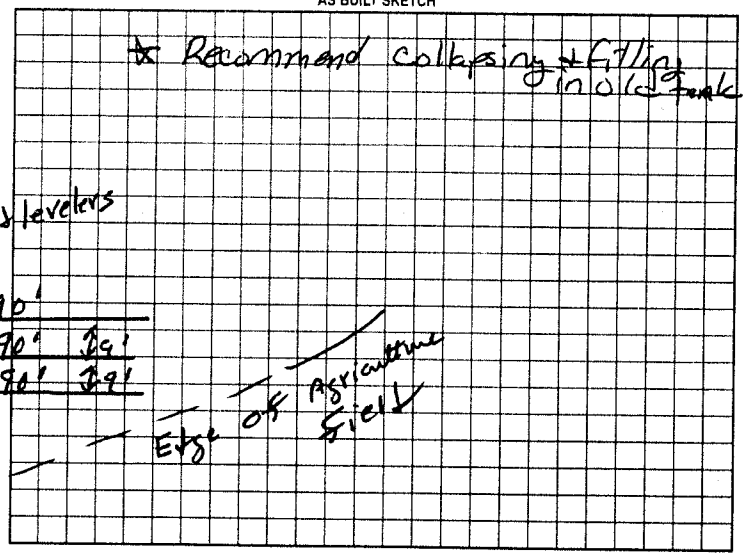

Permit can be suspended or revoked if any false information is supplied toward securing the permit/any unauthorized changes are made to the site/any unauthorized changes are made in the installation of the system. Improvement Permit with plat valid without expiration. Improvement Permit with site plan valid for sixty months. Authorization to Construct is valid for a period equal to that of Improvement Permit – not to exceed sixty months.

Signed: Cecile S. Howard date 6-10-99

Improvement Permit by: P. C. Moore date 6-9-99

Authorization to Construct by: P. C. Moore date 6-9-99

Installed by: Sammy Reavis

Operation Permit by: _____ date 7-2-99

Existing System Inspection by: _____ date _____

HEALTH DEPT COPY WHITE OWNER COPY (FINAL) YELLOW OWNER COPY (INITIAL) PINK