IREDELL COUNTY HEALTH DEPARTMENT

STATESVILLE 704-878-5305 MOORESVILLE 704-664-5281

IMPROVEMENT PERMIT / AUTHORIZATION TO CONSTRUCT / OPERATION PERMIT / EXISTING SYSTEM INSPECTION

PERMIT# 13787 PIN# ~~4862.3.2482~~ 4862382428 DATE 9-11-06

OWNER OR APPLICANT Habitat for Humanity (Robert Lunsford) PHONE: Business 704-880 3068 Home

ADDRESS 211 Cartwright Rd Statesville NC 28634

LOCATION 77N (R)901 (L) Winthrop (L) Carly (R) Cartwright property about 1 mile on Rt 4

SUBDIVISION BLOCK / SECTION LOT LOT AREA 2.6 SITE CLASS. R5 DESIGN FLOW 440 L.T.A.R. .13

Septic Tank: 1000 Gallons; STB 1012 Date 10-24

Pump Tank: Gallons; PT Date

Pump Make: Model Serial No.

Nitrification Field: No Fields Square Feet 1600 Linear Feet 700

No Lines 6 Trench Width 36" Max Trench Bottom Depth 36 Gravel Depth Gravity ☐ Pressure

☐ New System ☐ Repair ☑ Expansion System Type: I II III IV V VI

System Description: 25% - Conventional Gravity

Repair System Description:

Maintenance Agreement Required: ☐ Yes ☐ No

☑ House/Mod. Home No. Bedrooms 4

☐ Mobile Home No. Persons

☐ Business No. Employees

☐ Other

Water Supply: ☐ Individual ☐ Public ☐ Community

☐ Slab ☑ Crawl Space ☐ Basement w/plumbing ☐ Basement wo/plumbing

Comments:/Conditions:


add 2 100' lines at end of line - top add one drop box bottom add one drop BX come off each drop box add 100' of line each

Comments:/Conditions:

* ADVISE to get TANK pumped out!!!

BX mobile Home to be disconnected from system

INITIAL SITE SKETCH

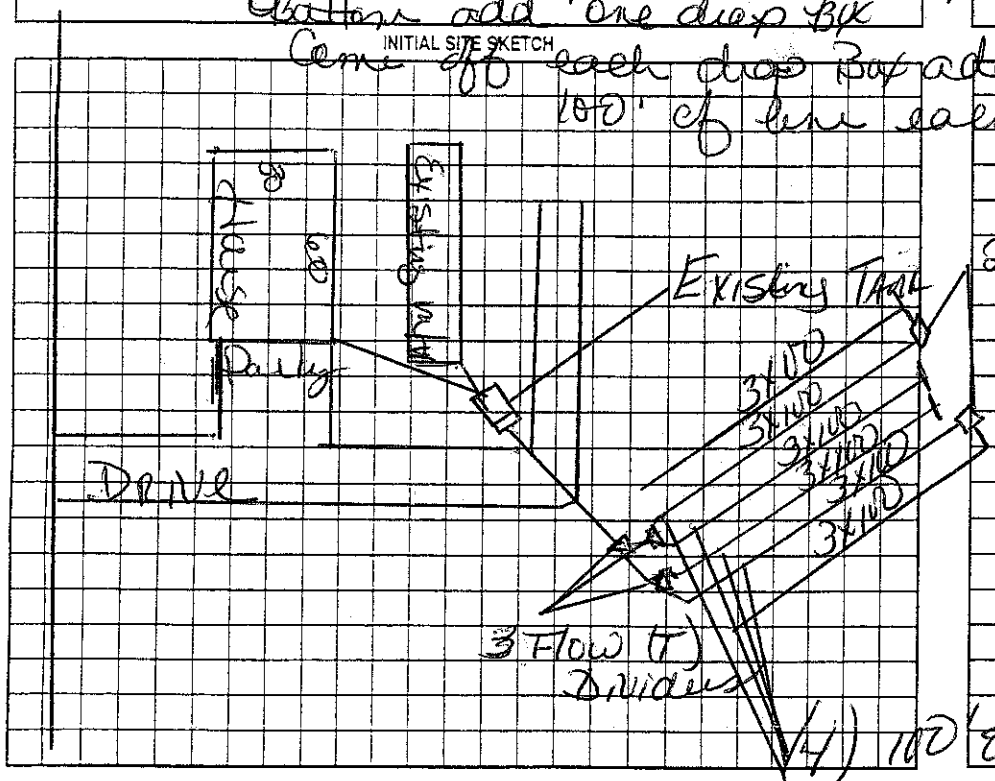

AS BUILT SKETCH

Permit can be suspended or revoked if any false information is supplied toward securing the permit/any unauthorized changes are made to the site/any unauthorized changes are made in the installation of the system. Improvement Permit with plat valid without expiration ☐ Improvement Permit with site plan valid for sixty months ☐ Authorization to Construct is valid for a period equal to that of Improvement Permit – not to exceed sixty months.

Signed: [signature] date 9-12-06 Installed by: J B Hickman

Improvement Permit by: Kelly Cook date 9-11-06 Operation Permit by: Kelly Cook date 11-6-06

Authorization to Construct by: Kelly Cook date 9-11-06 Existing System Inspection by: date

HEALTH DEPT. COPY: WHITE OWNER COPY (FINAL): YELLOW OWNER COPY (INITIAL): PINK