1-18-96 Paid #25 M. Burke 2.00 Dennis Gallihar

IREDELL COUNTY HEALTH DEPARTMENT

STATESVILLE 704-878-5305 MOORESVILLE 704-664-5281

IMPROVEMENT PERMIT / CERTIFICATE OF COMPLETION / OPERATION PERMIT / EXISTING SYSTEM INSPECTION

PROPERTY DESCRIPTION NO. 21872 DATE 1-16-96 TAX MAP NO. 16J-A-47 Watershed: ☐ Yes ☐ No

OWNER OR CONTRACTOR ROBERT E. TRIVETTE PHONE: Business Home 539-4846

ADDRESS 189 CARTWRIGHT RD HARMONY NC 28634

LOCATION I-77 N, TR NC901, TL CRATER RD, TR CARTWRIGHT 2ND DRIVEWAY ON (R) AT WOODED AREA

SUBDIVISION BLOCK / SECTION LOT LOT AREA 14 ACRES SITE CLASS. PS DESIGN FLOW 360 L.T.A.R. 0.30 GPD/FT²

Septic Tank: 1000 Gallons; STB 1012 Date 10/24

Pump Tank: Gallons; PT Date

Pump Make: Model Serial No.

Nitrification Field: No Fields 1 Square Feet 1200 Linear Feet 400

No Lines 4 Trench Width 36" Max Trench Bottom Depth 18-36" Gravel Depth 12"

☑ New System ☐ Repair System Type: I, II, III, IV, V, VI

System Description: CONVENTIONAL GRAVITY

Repair System Description: CONVENTIONAL GRAVITY

Maintenance Agreement Required: ☐ Yes ☑ No

☐ House/Mod. Home No. Bedrooms 3

☑ Mobile Home No. Bathrooms 2

☐ Business No. Employees

☐ Other TYPE 3 BR HOUSE


☐ Slab ☑ Crawl Space ☐ Basement w/plumbing ☐ Basement wo/plumbing

Water Supply: ☑ Individual ☐ Community ☐ Public WELL


Comments: ① USE THREE FLOW DIVIDER TEES TO ACHIEVE EQUAL DISTRIBUTION INTO EACH of FOUR LINES ② SUPPLY LINE > 30" DEEP OR USE SCH 80 PVC BENEATH VEHICULAR TRAFFIC ③ KEEP SYSTEM MINIMUM 100' FROM WELL

Comments: 78' of Solid Pipe

INITIAL SITE SKETCH

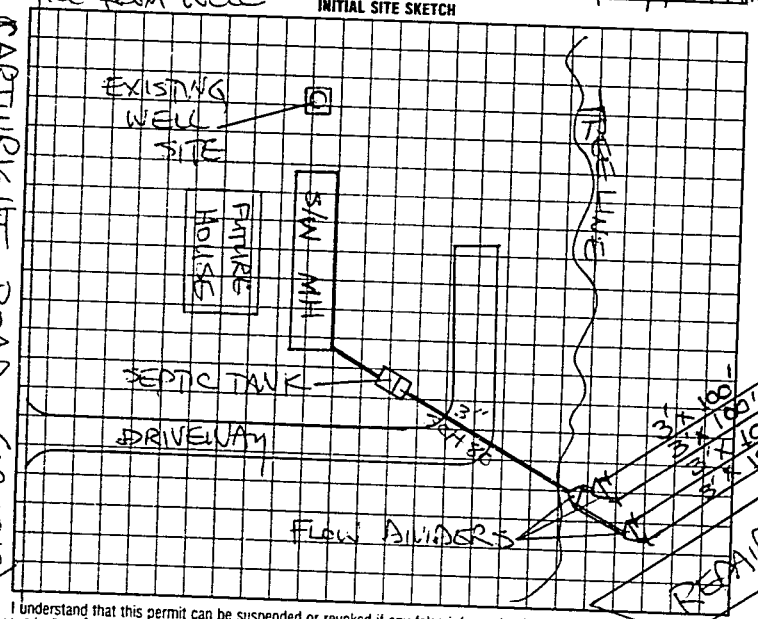

AS BUILT SKETCH

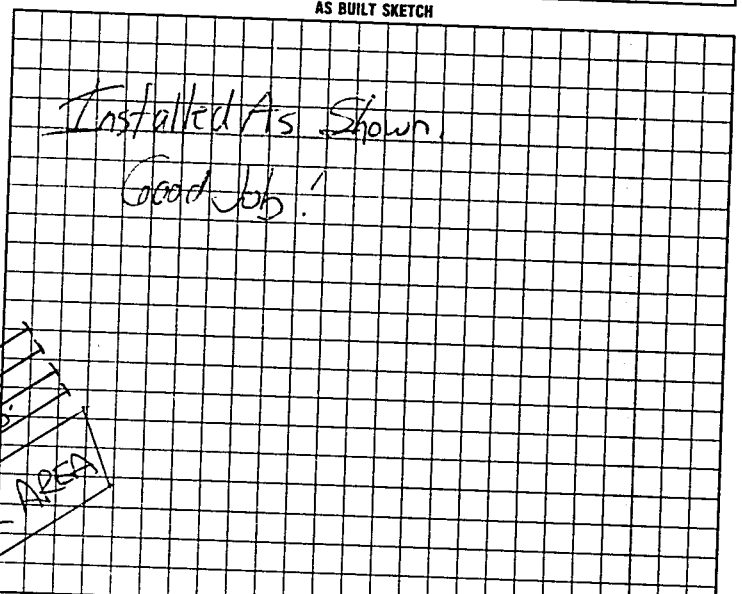

CARTWRIGHT ROAD (SR 1819)

I understand that this permit can be suspended or revoked if any false information is supplied toward securing the permit/any unauthorized changes are made to the site/any unauthorized changes are made in the installation of the system.

AUTHORIZATION TO CONSTRUCT IS VALID FIVE (5) YEARS FROM DATE OF ISSUANCE. IMPROVEMENT PERMIT HAS NO EXPIRATION DATE

Signed: X Robert D. Trivette

Improvement Permit by: STEVE HERRICK date 1-16-96

AUTHORIZATION TO CONSTRUCT

Existing System Inspection by: STEVE HERRICK date 1-16-96

Installed by: Dennis Gallihar

~~Certificate of Completion by:~~ date

Operation Permit by: date 2/1/96

HEALTH DEPT. COPY: WHITE INSPECTION COPY (FINAL) GREEN OWNER COPY (FINAL) YELLOW INSPECTION COPY (INITIAL) PINK OWNER COPY (INITIAL) GOLD