IREDELL COUNTY HEALTH DEPARTMENT

STATESVILLE 704-878-5305 MOORESVILLE 704-664-5281

IMPROVEMENT PERMIT / AUTHORIZATION TO CONSTRUCT / OPERATION PERMIT / EXISTING SYSTEM INSPECTION

PERMIT# 117179 PIN# 4862-39-2665 DATE 12/15/03

OWNER OR CONTRACTOR American Land Corporation PHONE: Business _____ Home 704-450-4817

ADDRESS 3126 Milton Rd Suite 227 Charlotte, NC 28215

LOCATION I-77N to Exit 65 (R) NC 901 (L) Winthrop (L) Crater (R) Cartwright (L) Cheshire Lot on left

SUBDIVISION Cheshire Ridge BLOCK / SECTION 2 LOT 26 LOT AREA 1.66 ac SITE CLASS. PS DESIGN FLOW 360 L.T.A.R. 0.3 gpd/ft²

Septic Tank: 1000 Gallons; STB 1012 Date 6-22-03
Pump Tank: _____ Gallons; PT _____ Date _____
Pump Make: _____ Model _____ Serial No. _____
Nitrification Field: No Fields 1 Square Feet EQ to 1600 Linear Feet 400
No Lines 4 Trench Width 36" Max Trench Bottom Depth 24" Gravel Depth 6"+12"

☑ New System ☐ Repair System Type: I (II) III, IV, V, VI
System Description: Gravity Conventional
Repair System Description: Gravity, 25% reduction
Maintenance Agreement Required: ☐ Yes ☑ No


☐ House/Mod. Home No. Bedrooms 3
☑ Mobile Home No. Bathrooms 2
☐ Business No. Employees _____
☐ Other _____
☐ Slab ☑ Crawl Space ☐ Basement w/plumbing ☐ Basement wo/plumbing

Water Supply: ☑ Individual ☐ Public ☐ Community WELL


Comments:/Conditions: (1) MUST MEET INSTALLER PRIOR TO START OF SYSTEM*
(2) Must maintain all setbacks (3) Install lines on contour
(4) Elevation of house site and plumbing critical or will have to pump
(5) Must divert surface water around system

Comments:/Conditions: Tuff-Tite Filter, #57 stone
* Some slight modifications made to sketch

INITIAL SITE SKETCH 1"=50'

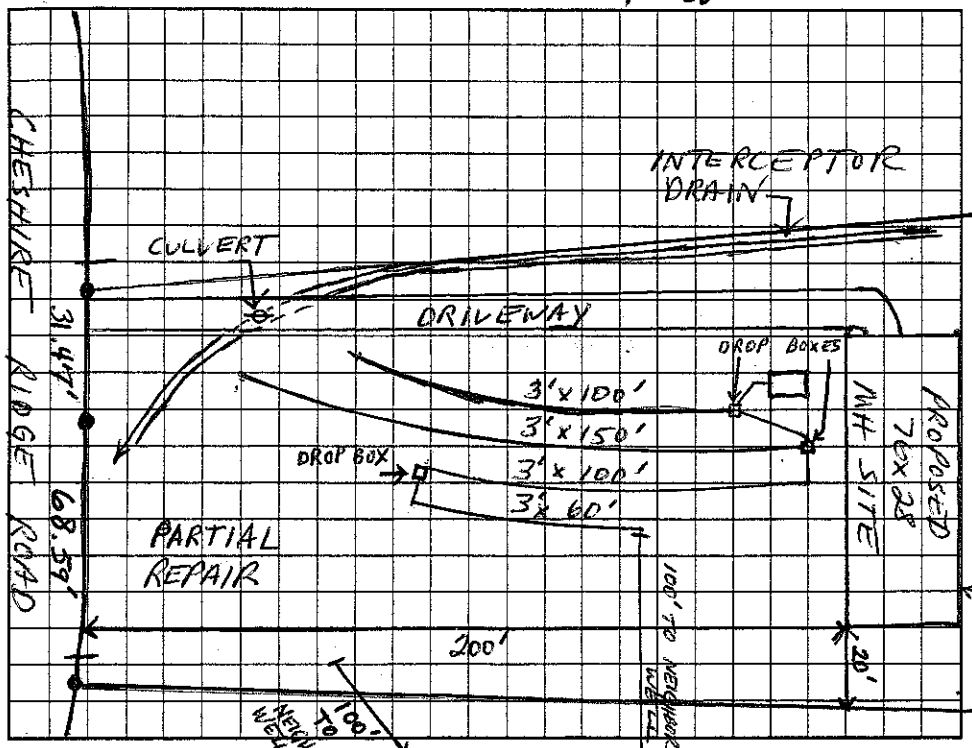

AS BUILT SKETCH

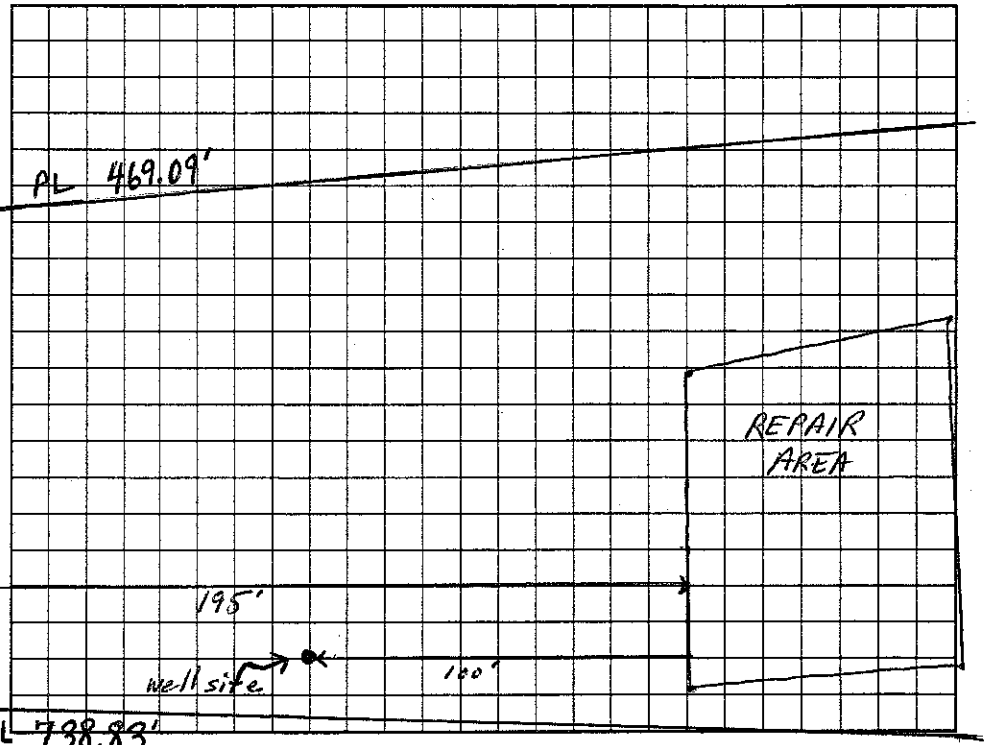

Permit can be suspended or revoked if any false information is supplied toward securing the permit/any unauthorized changes are made to the site/any unauthorized changes are made in the installation of the system. Improvement Permit with plat valid without expiration. Improvement Permit with site plan valid for sixty months. Authorization to Construct is valid for a period equal to that of Improvement Permit – not to exceed sixty months.

Signed: _____ date 12/15/03 Installed by: A-1 Backhoe

Improvement Permit by: Christopher M. Sherrill, R.S. date 12-15-03 Operation Permit by: Christopher M. Sherrill, RS date 12-19-03

Authorization to Construct by: Christopher M. Sherrill, R.S. date 12-15-03 Existing System Inspection by: _____ date _____

HEALTH DEPT. COPY: WHITE OWNER COPY (FINAL): YELLOW OWNER COPY (INITIAL): PINK