IREDELL COUNTY HEALTH DEPARTMENT

STATESVILLE 704-878-5305 MOORESVILLE 704-664-5281 (C1)

IMPROVEMENT PERMIT / AUTHORIZATION TO CONSTRUCT / OPERATION PERMIT / EXISTING SYSTEM INSPECTION

PERMIT# 119762 PIN# 4862-39-3465 DATE 5-3-09

OWNER OR CONTRACTOR EUGENE NORMAN PHONE: Business Home 704-539-5707

ADDRESS 984 BARNARD MILL RD HAMPTONVILLE NC 27020

LOCATION I-77 N TR NC 901, TL CRATER RD, TR CARTWRIGHT RD, TL CHESHIRE RIDGE RD, 3RD on LEFT

SUBDIVISION CHESHIRE RIDGE BLOCK / SECTION II LOT 24 LOT AREA 1.71 ACRES SITE CLASS. PS' DESIGN FLOW 360 L.T.A.R. 0.30 GPD/FT²

Septic Tank: 1000 Gallons; STB ____ Date ____

Pump Tank: ____ Gallons; PT ____ Date ____

Pump Make: ____ Model ____ Serial No. ____

Nitrification Field: No Fields 1 Square Feet 1200 Linear Feet 300

No Lines PUE Trench Width 36" Max Trench Bottom Depth 36" Gravel Depth N/A

☐ New System ☐ Repair System Type: I, II, (III), IV, V, VI

System Description: 252 REDUCTION, GRAVITY

Repair System Description: ____

Maintenance Agreement Required: ☐ Yes ☐ NO

☐ House/Mod. Home ☑ Mobile Home ☐ Business ☐ Other


No. Bedrooms 2 No. Bathrooms 2 No. Employees ____

☐ Slab ☑ Crawl Space ☐ Basement w/plumbing ☐ Basement wo/plumbing

Water Supply: ☑ Individual ☐ Public ☐ Community


Comments:/Conditions:

INITIAL SITE SKETCH

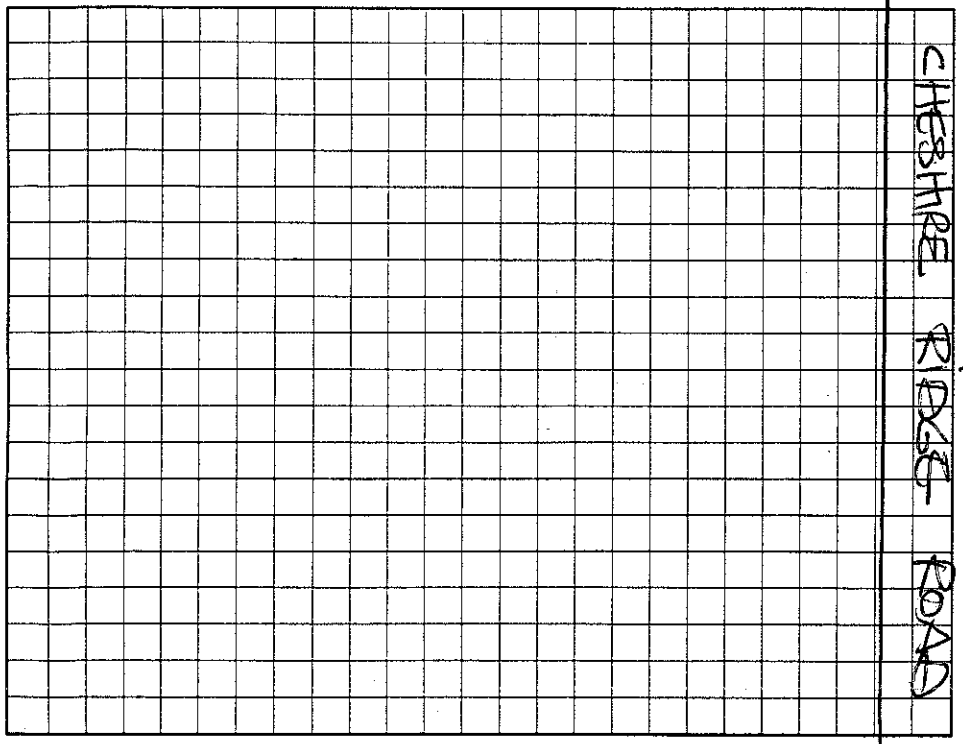

Comments:/Conditions:

AS BUILT SKETCH ~ SCALE : 1"=50'

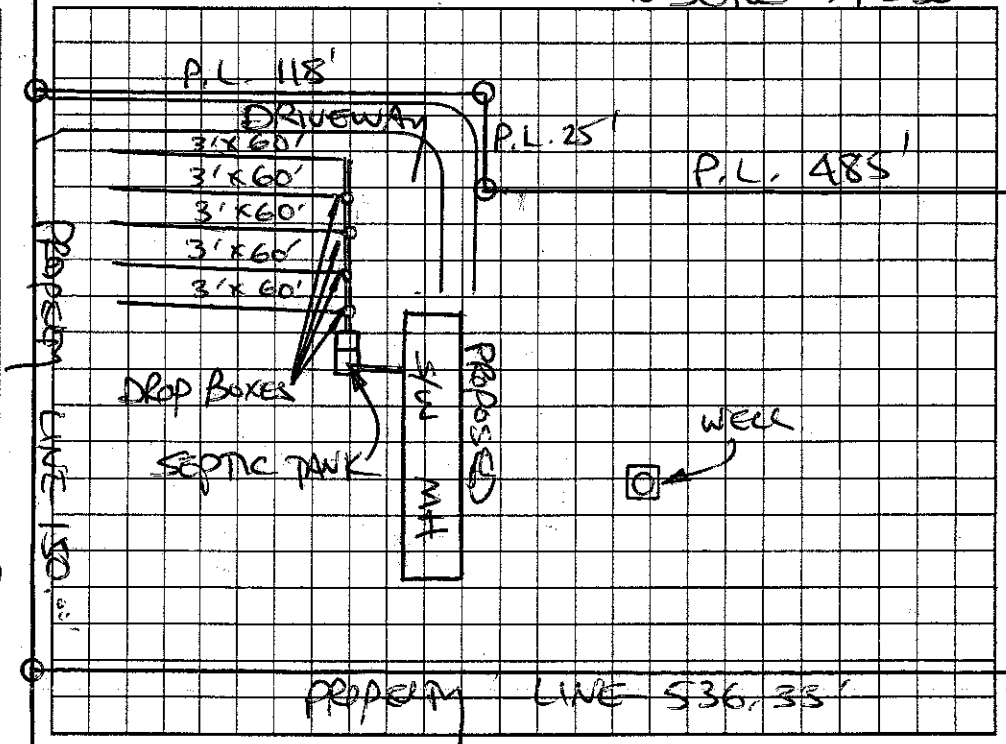

Permit can be suspended or revoked if any false information is supplied toward securing the permit/any unauthorized changes are made to the site/any unauthorized changes are made in the installation of the system. Improvement Permit with plat valid without expiration. Improvement Permit with site plan valid for sixty months. Authorization to Construct is valid for a period equal to that of Improvement Permit – not to exceed sixty months.

Signed: ____ date ____

Improvement Permit by: ____ date ____

Authorization to Construct by: ____ date ____

Installed by: ____

Operation Permit by: ____ date ____

Existing System Inspection by: STEVE HENDRICK date 5-3-09

HEALTH DEPT. COPY: WHITE OWNER COPY (FINAL): YELLOW OWNER COPY (INITIAL): PINK