IREDELL COUNTY HEALTH DEPARTMENT - *ENVIRONMENTAL HEALTH* ☐ STATESVILLE OFFICE 704-878-5305 ☐ MOORESVILLE OFFICE 704-664-5281

IMPROVEMENT PERMIT / AUTHORIZATION TO CONSTRUCT / OPERATION PERMIT / EXISTING SYSTEM INSPECTION

PERMIT # 166000 PIN # 4862-39-3545 DATE 5 Apr. 2011

OWNER Tony & Alisha Jones APPLICANT: PHONE: Home/Cell # (336) 492-2089 Business #

SITE ADDRESS 131 Cheshire Ridge Rd OWNER / APPLICANT ADDRESS


SITE DIRECTIONS I-77 N TR 90A TL Winthrop Rd. TL Crater Rd. TR Courtwright · TL Cheshire - 6th Left.

SUBDIVISION Cheshire Ridge BLOCK / SECTION II LOT # 25 LOT AREA 1.44 Ac. DESIGN FLOW 480 gpd L.T.A.R. 0.3 gpd/ft²


Septic Tank Existing	Gallons: STB	Date	☐ New System ☐ Repair ☑ Expansion System Type I II III IV V VI	☑ Residence	No. Bedrooms 4	Water Supply
Pump Tank	Gallons: PT	Date	System Description: 25% Reduction	☐ Business	No. Persons	☑ Private
Pump Make	Model	Serial #	Repair System Description: 25% Reduction	☐ Other	No. Employees	☐ Public
No. Nitrification Fields: 1	No. Lines 1	Linear Feet 100'	Maintenance Agreement Required ☐ YES ☑ NO	☐ Slab	☑ Crawl Space	☐ Community
Trench Width 36"	Max. Trench Bottom Depth 36"	Gravel Depth NA	☑ GRAVITY ☐ PRESSURE	☐ Basement w/plumbing	☐ Basement w/o plumbing	

Comments / Conditions: Replace flow divider tees with drop-boxes. Add 100' of 25% Reduction system.

INITIAL SITE SKETCH

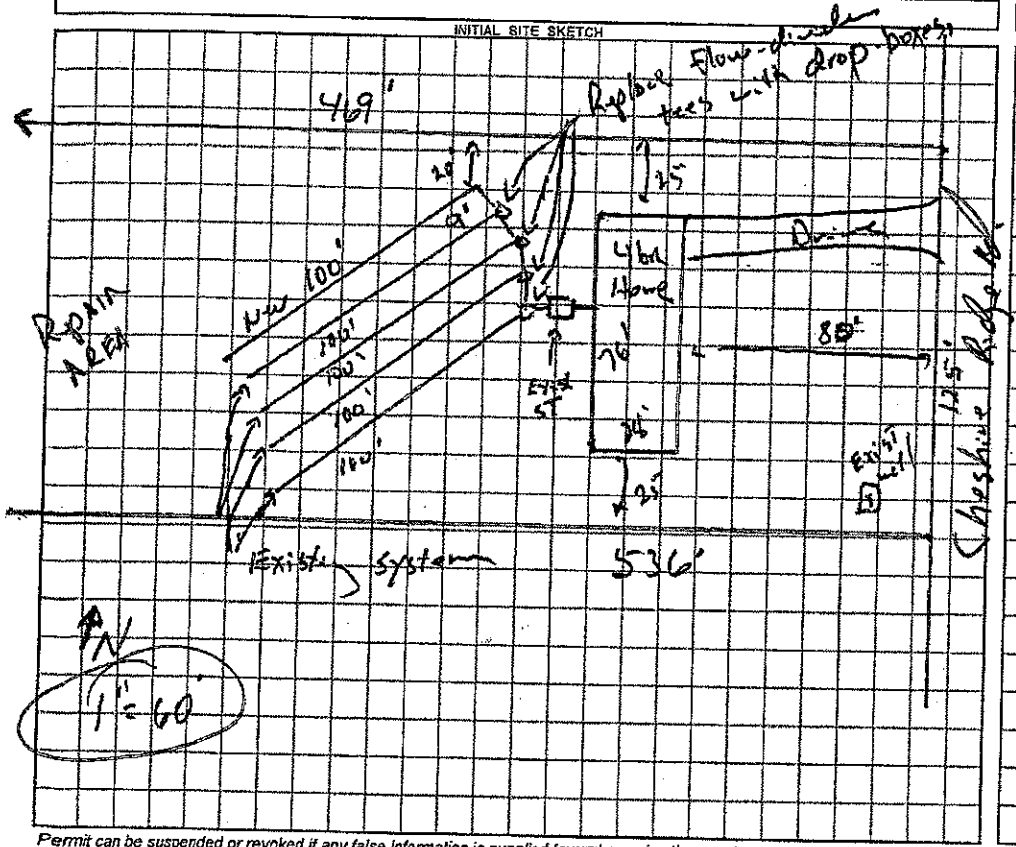

AS BUILT SKETCH

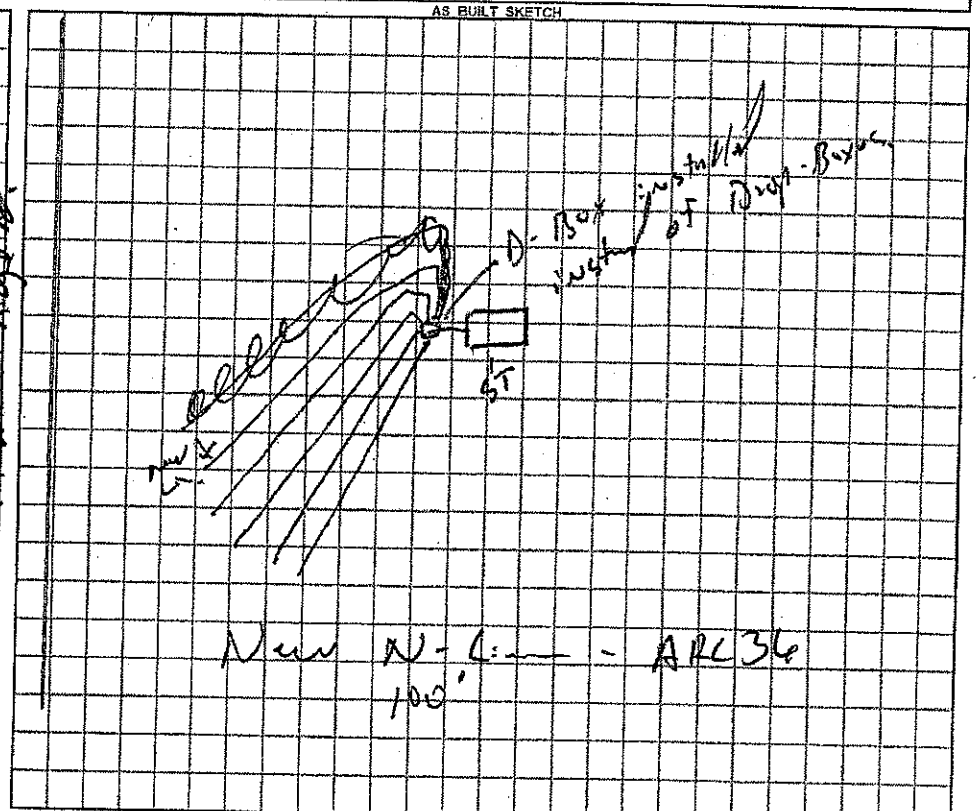

Permit can be suspended or revoked if any false information is supplied toward securing the permit / any unauthorized changes are made to the site / any unauthorized changes are made in the installation of the system.

☐ *IMPROVEMENT PERMIT with plat valid without expiration* ☑ *IMPROVEMENT PERMIT with ~~plat valid without expiration~~ site plan valid 60 mo.* ☑ *AUTHORIZATION TO CONSTRUCT* valid for period equal to IMPROVEMENT PERMIT–not to exceed 60 mo.

Owner / Applicant Signature: Tony Abee Date 4/6/11

IMPROVEMENT PERMIT by: REHS Date 5 Apr. 11

AUTHORIZATION TO CONSTRUCT by: REHS Date 5 Apr. 11

YOU SHOULD CONTACT A LOCATOR SERVICE PRIOR TO ANY EXCAVATION

Installed by: Tony Abee

OPERATION PERMIT by: REHS Date 14 Apr. 11

Existing System Inspected by: REHS Date

White Copy – Environmental Health YELLOW COPY (Final) Owner / Applicant PINK COPY (Initial) Owner / Applicant