IREDELL COUNTY HEALTH DEPARTMENT

STATESVILLE 704-878-5305 MOORESVILLE 704-664-5281

(C1)

IMPROVEMENT PERMIT / AUTHORIZATION TO CONSTRUCT / OPERATION PERMIT / EXISTING SYSTEM INSPECTION

PERMIT# 106630 PIN# 4862-39-4066 DATE 6-6-02

OWNER OR CONTRACTOR BRAD CROAKMAN PHONE Business Home 704-539-5630

ADDRESS 168 WHISPERING DR HARMONY NC 28634

LOCATION I-77 N TR NC 901 TL CRATER RD TR CARTWRIGHT 3RD LOT ON LEFT BEFORE CHESHIRE RIDGE RD.

SUBDIVISION CHESHIRE RIDGE BLOCK / SECTION 1 LOT 3 LOT AREA 1.10 ACRES SITE CLASS PST DESIGN FLOW 480 L.T.A.R. 0.30 GPD/FT²

Septic Tank: 1000 Gallons: STB Date

Pump Tank: Gallons; PT Date

Pump Make: Model Serial No.

Nitrification Field: No Fields 1 Square Feet 1600 Linear Feet 533

No Lines FIVE Trench Width 36" Max Trench Bottom Depth 36" Gravel Depth 12"

☐ New System ☐ Repair System Type: I II III IV V VI

System Description: CONVENTIONAL, GRAVITY

Repair System Description: CONV. PUMP

Maintenance Agreement Required: ☐ Yes ☑ No

☐ Slab ☑ Crawl Space ☐ Basement w/plumbing ☐ Basement wo/plumbing

☑ House/Mod. Home No. Bedrooms 3

☐ Mobile Home No. Bathrooms 2

☐ Business No. Employees


☐ Other

Water Supply: ☐ Individual ☐ Public ☐ Community WELL


Comments./Conditions:

Comments./Conditions.

INITIAL SITE SKETCH

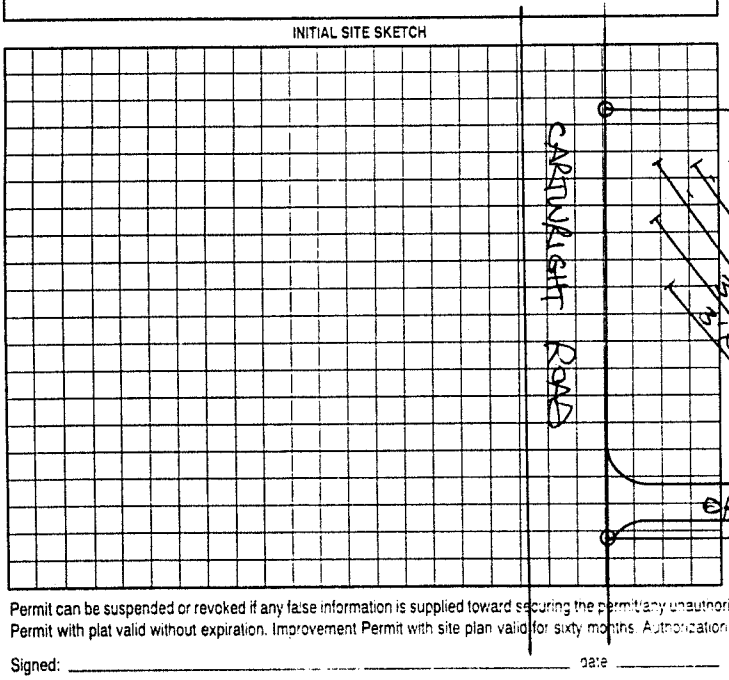

AS BUILT SKETCH SCALE: 1" = 50'

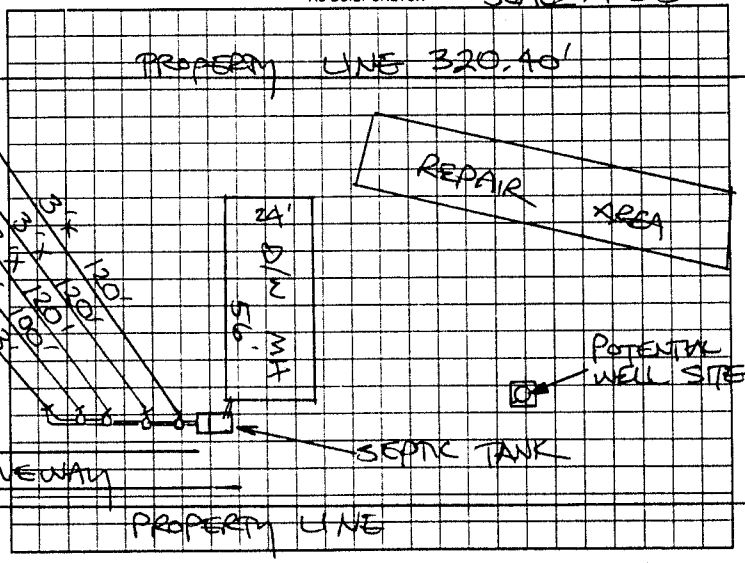

Permit can be suspended or revoked if any false information is supplied toward securing the permit any unauthorized changes are made to the site any unauthorized changes are made in the installation of the system. Improvement Permit with plat valid without expiration. Improvement Permit with site plan valid for sixty months. Authorization to Construct is valid for a period equal to that of Improvement Permit – not to exceed sixty months

Signed: date Installed by

Improvement Permit by: date Operation Permit by date

Authorization to Construct by: date Existing System Inspection by: STEVE HEDRICK date 6-6-02

HEALTH DEPT COPY: WHITE OWNER COPY (FINAL) YELLOW OWNER COPY (INITIAL) PINK