IREDELL COUNTY HEALTH DEPARTMENT

STATESVILLE 704-878-5305 MOORESVILLE 704-664-5281

IMPROVEMENT PERMIT / AUTHORIZATION TO CONSTRUCT / OPERATION PERMIT / EXISTING SYSTEM INSPECTION

PERMIT# 14 7969 PIN# 4862 39 7119 DATE 1-25-08

OWNER OR APPLICANT Ricky Mitchell PHONE: Business _____ Home 704-539-4450

ADDRESS 215 Private Rd Harmony NC 28634

LOCATION 72N (R) 901 (L) Winthrop (R) Crater (R) Courtwright (R) Cheshire Ridge 1st on left

SUBDIVISION Cheshire Ridge BLOCK / SECTION 1 LOT 5 LOT AREA 1.08 AC SITE CLASS. PS DESIGN FLOW 360 L.T.A.R. 3

Septic Tank: 1000 Gallons: STB 794 Date 7-9-98

Pump Tank: _____ Gallons: PT _____ Date _____

Pump Make: _____ Model _____ Serial No. _____

Nitrification Field: No Fields ___ Square Feet 1200 Linear Feet 400

No Lines 4 Trench Width 36 Max Trench Bottom Depth 36

☐ New System ☐ Repair ☐ Expansion System Type: I (II) III IV V VI

System Description: Exist Conven - Gravity

Repair System Description: Capped - Gravity / Pump

Maintenance Agreement Required: ☐ Yes ☑ No

Gravel Depth 12" ☐ Gravity ☐ Pressure

☐ House/Mod. Home ☑ Mobile Home ☐ Business ☐ Other

No. Bedrooms 3 No. Persons ___ No. Employees ___

☐ Slab ☑ Crawl Space ☐ Basement w/plumbing ☐ Basement wo/plumbing


Water Supply: ☑ Individual ☐ Public ☐ Community

Comments:/Conditions:


Comments:/Conditions:

NO signs of failure at time of inspection

INITIAL SITE SKETCH

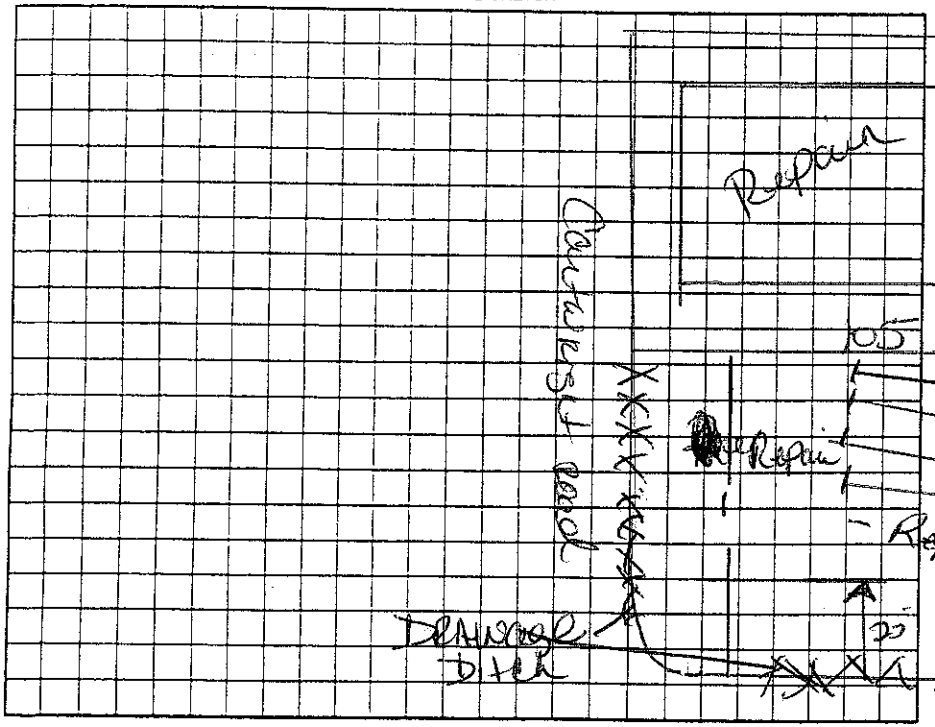

AS BUILT SKETCH

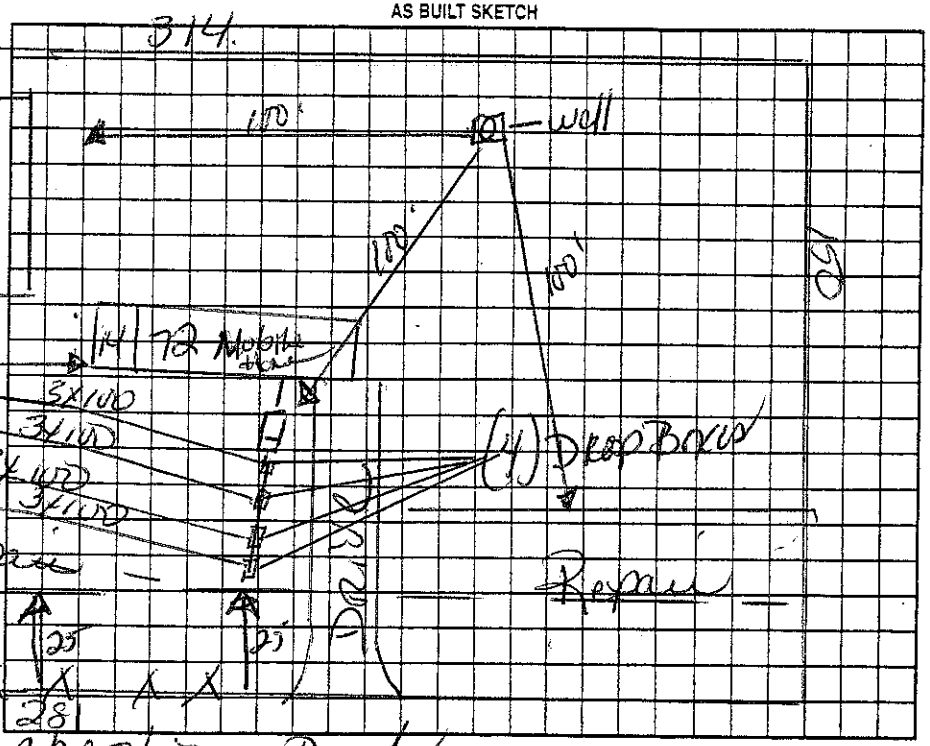

Permit can be suspended or revoked if any false information is supplied toward securing the permit/any unauthorized changes are made to the site/any unauthorized changes are made in the installation of the system. Improvement Permit with plat valid without expiration ☐ Improvement Permit with site plan valid for sixty months ☑ Authorization to Construct is valid for a period equal to that of Improvement Permit – not to exceed sixty months.

Signed: _____ date _____

Improvement Permit by: _____ date _____

Authorization to Construct by: _____ date _____

Installed by: _____

Operation Permit by: _____ date _____

Existing System Inspection by: Kenny Cook date 1-25-08

HEALTH DEPT. COPY: WHITE OWNER COPY (FINAL): YELLOW OWNER COPY (INITIAL): PINK