IREDELL COUNTY HEALTH DEPARTMENT

STATESVILLE 704-878-5305 MOORESVILLE 704-664-5281

IMPROVEMENT PERMIT / AUTHORIZATION TO CONSTRUCT / OPERATION PERMIT / EXISTING SYSTEM INSPECTION

PERMIT# 074504 PIN# 4862 39 8289 DATE 6-19-98

OWNER OR CONTRACTOR PAUL DOUGLAS WATTS PHONE: Business Home 872-4905

ADDRESS 324 SOUTH MILLER AVENUE, STATESVILLE, NC 28677

LOCATION I-77 N, TR NC 901, TL WINTHROP, TL CRATER, TR CARTWRIGHT, TL CHESHIRE RIDGE, 1ST LOT ON RIGHT

SUBDIVISION CHESHIRE RIDGE BLOCK / SECTION 1 LOT 6 LOT AREA 1.06 ACRES SITE CLASS. PS DESIGN FLOW 360 L.T.A.R. 0.25 GPD/FT²

Septic Tank: 1000 Gallons; STB 1012 Date 4-26-98
Pump Tank: ____ Gallons; PT ____ Date ____
Pump Make: ____ Model ____ Serial No. ____
Nitrification Field: No Fields 1 Square Feet 1470 Linear Feet 480
No Lines FOUR Trench Width 36" Max Trench Bottom Depth 24" Gravel Depth 12"

☑ New System ☐ Repair System Type: I, II, III, IV, V, VI
System Description: CONVENTIONAL GRAVITY
Repair System Description: CONVENTIONAL GRAVITY
Maintenance Agreement Required: ☐ Yes ☑ No
☐ Slab ☑ Crawl Space ☐ Basement w/plumbing ☐ Basement wo/plumbing


☐ House/Mod. Home No. Bedrooms 3
☑ Mobile Home No. Bathrooms 2
☐ Business No. Employees ____
☐ Other ____

Water Supply: ☑ Individual ☐ Public ☐ Community
WELL


Comments:/Conditions: ① KEEP SYSTEM MINIMUM 100' FROM WELL ② CONSTRUCT SUBSURFACE INTERCEPT DRAINAGE DITCH AT LOCATION SHOWN BEGINNING 42" DEEP AND OUT TO DAYLIGHT

Comments:/Conditions:

INITIAL SITE SKETCH SCALE: 1"=50'

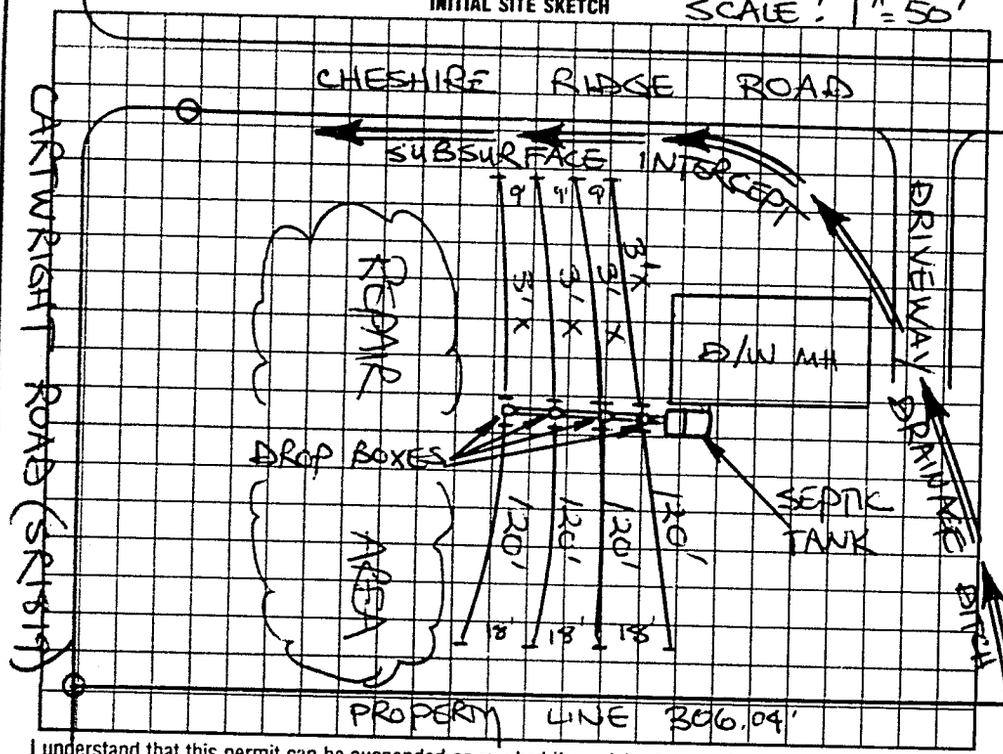

AS BUILT SKETCH

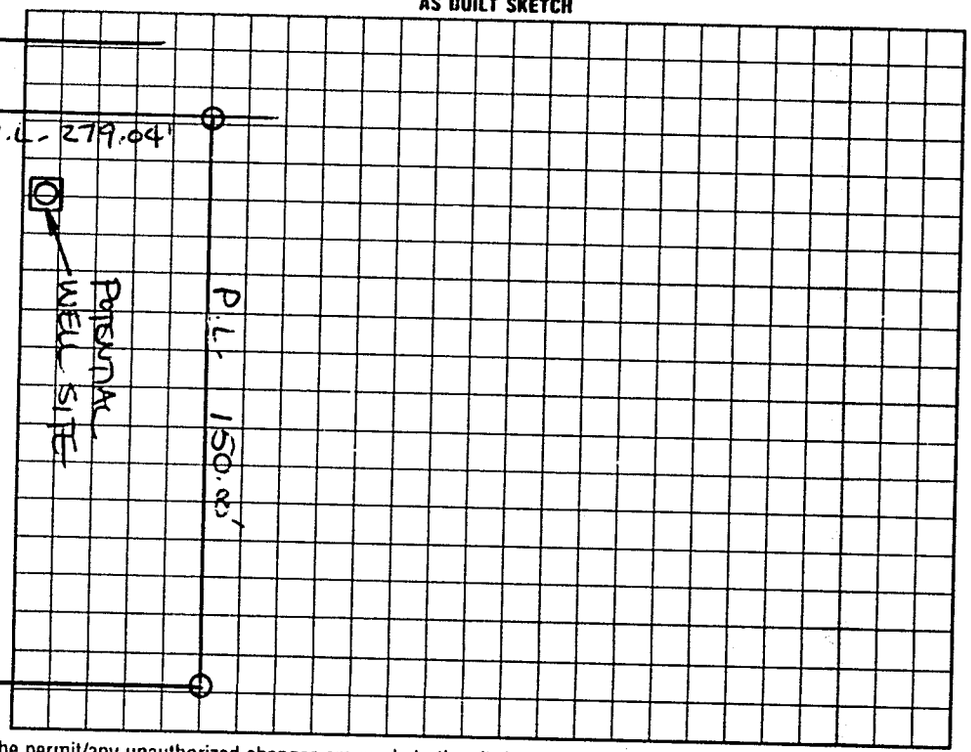

I understand that this permit can be suspended or revoked if any false information is supplied toward securing the permit/any unauthorized changes are made to the site/any unauthorized changes are made in the installation of the system. Improvement Permit with plat valid without expiration. Improvement Permit with site plan valid for sixty months. Authorization to Construct is valid for a period equal to that of Improvement Permit – not to exceed sixty months.

Signed: Claudette Ballard date 6/22/98

Improvement Permit by: STEVE HEDRICK date 6-19-98

Authorization to Construct by: STEVE HEDRICK date 6-19-98

Installed by: A-1 Backhoe

Operation Permit by: [illegible] date 6-26-98

Existing System Inspection by: ____ date ____

HEALTH DEPT COPY WHITE INSPECTION COPY (FINAL) GREEN OWNER COPY (FINAL) YELLOW INSPECTION COPY (INITIAL) PINK OWNER COPY (INITIAL) GOLD