IREDELL COUNTY HEALTH DEPARTMENT

STATESVILLE 704-878-5305 MOORESVILLE 704-664-5281

IMPROVEMENT PERMIT / AUTHORIZATION TO CONSTRUCT / OPERATION PERMIT / EXISTING SYSTEM INSPECTION

PERMIT# 077999 PIN# 4862 39 8840 DATE 12-8-98

OWNER OR CONTRACTOR AMERICAN LAND PHONE: Business 878-9595 Home

ADDRESS 1281 GARNER BAGNA BLVD, STATESVILLE, NC 28677

LOCATION I-77 N, TR NC 901, TL CRATER, TR CARTWRIGHT, TL CHESHIRE RIDGE ROAD, LOT ON RIGHT

SUBDIVISION CHESHIRE RIDGE BLOCK / SECTION II LOT 40 LOT AREA 1.51 ACRES SITE CLASS PS DESIGN FLOW 360' L.T.A.R 0.33 gpd/ft²

Septic Tank: 1000 Gallons; STB 1012 Date 7-11-99
Pump Tank: Gallons; PT Date
Pump Make: Model: Serial No.
Nitrification Field: No Fields 1 Square Feet 1080 Linear Feet 360
No Lines THREE Trench Width: 36" Max Trench Bottom Depth 30" Gravel Depth 12"

✓ New System Repair System Type: CONV. (I, II, III, IV)
System Description: CONVENTIONAL GRAVITY
Repair System Description: CONV, GRAVITY
Maintenance Agreement Required: Yes / No
Slab / Crawl Space / Basement w/plumbing / Basement w/o plumbing


Home/Mod. Home: No. Bedrooms 3
✓ Mobile Home: No. Bathrooms 2
Business: No. Employees
Other:

Water Supply: ✓ Individual / Public / Community
WELL


Comments/Conditions: KEEP SYSTEM MINIMUM 100 FEET FROM WELL

Comments/Conditions: SEPTIC TANK WITH RISERS INSTALLED USING "POLYLOK" FILTER

INITIAL SITE SKETCH - SCALE: 1"=50'

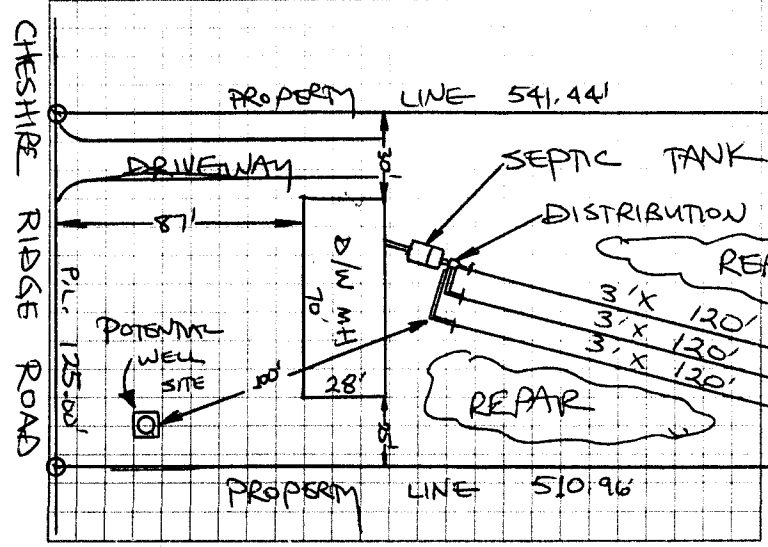

AS BUILT SKETCH

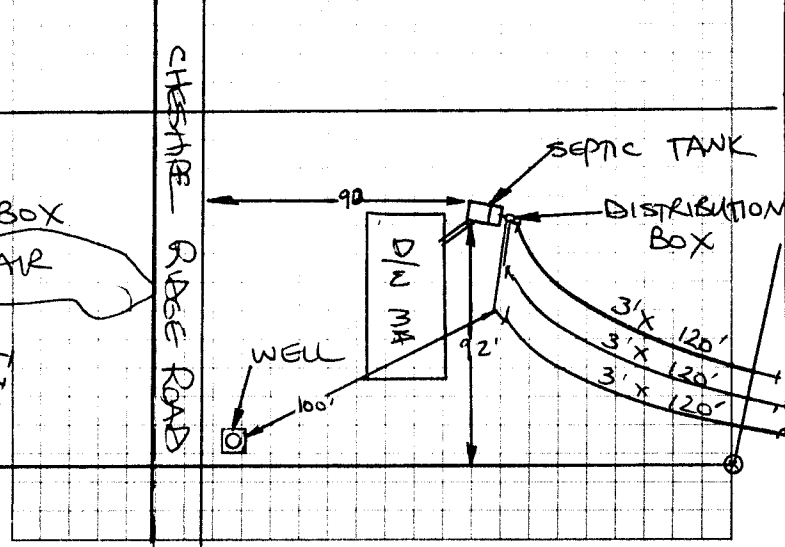

I understand that this permit can be suspended or revoked if any false information is supplied toward securing the permit/any unauthorized changes are made to the site/any unauthorized changes are made in the installation of the system. Improvement Permit with plat valid without expiration. Improvement Permit with site plan valid for sixty months. Authorization to Construct is valid for a period equal to that of Improvement Permit – not to exceed sixty months.

Signed: Claudette Bellard date 12-10-98
Improvement Permit by: STEVE HEDRICK date 12-8-98
Authorization to Construct by: STEVE HEDRICK date 12-8-98

Installed by: [redacted] KENNY MADISON
Operation Permit by: STEVE HEDRICK date 9-22-99
Existing System Inspection by: date

HEALTH DEPT. COPY: WHITE INSPECTION COPY (FINAL): GREEN OWNER COPY (FINAL): YELLOW INSPECTION COPY (INITIAL): PINK OWNER COPY (INITIAL): GOLD