IREDELL COUNTY HEALTH DEPARTMENT

Statesville Office (704) 878-5305 Mooresville Office (704) 660-3625

BP

IMPROVEMENT PERMIT / AUTHORIZATION TO CONSTRUCT / OPERATION PERMIT / EXISTING SYSTEM

PERMIT # 20300l

PIN # 4862425446

APPLICANT: John Bonner

APPLICANT ADDRESS: 979 W. Memorial Hwy

SITE ADDRESS: 979 W. Memorial Hwy

PHONE: 336-618-0037 ALT. PHONE: N/A

SITE DIRECTIONS: Hwy 21 N TL W. Memorial Hwy Property on left just past Tabor Rd.

SUBDIVISION: N/A

SECTION: N/A LOT # N/A LOT AREA: 12.34 acres DESIGN FLOW: 100gpd L.T.A.R.: Existing

Septic Tank Existing (gal) STB Date

Pump Tank (gal) PT Date

Pump Make Model Serial #

Nitrification Fields Ex # Lines Ex Linear Ft: Ex

Trench Width Ex Max. Trench Bottom Depth Ex Gravel Depth Ex

☐ New System ☐ Repair ☐ Expansion System Type: I (II) III IV V VI

System Description: Conventional

Repair System Description:

Maintenance Agreement Required: ☐ YES ☑ NO

☑ GRAVITY ☐ PRESSURE

☐ Residence ☑ Business ☐ Other ☐ Slab ☐ Basement w/plumbing

No. Bedrooms No. Persons No. Employees 4 ☐ Crawl Space ☐ Basement w/o plumbing

Water Supply: ☑ Private ☑ Public ☐ Community


Comments / Conditions:

- Maintain a minimum of 5' between septic system & store foundation. System approved for 4 or less employees only.

INITIAL SITE SKETCH

Could not issue ~~order~~ Existing bc lower level permit is not issue

AS BUILT SKETCH

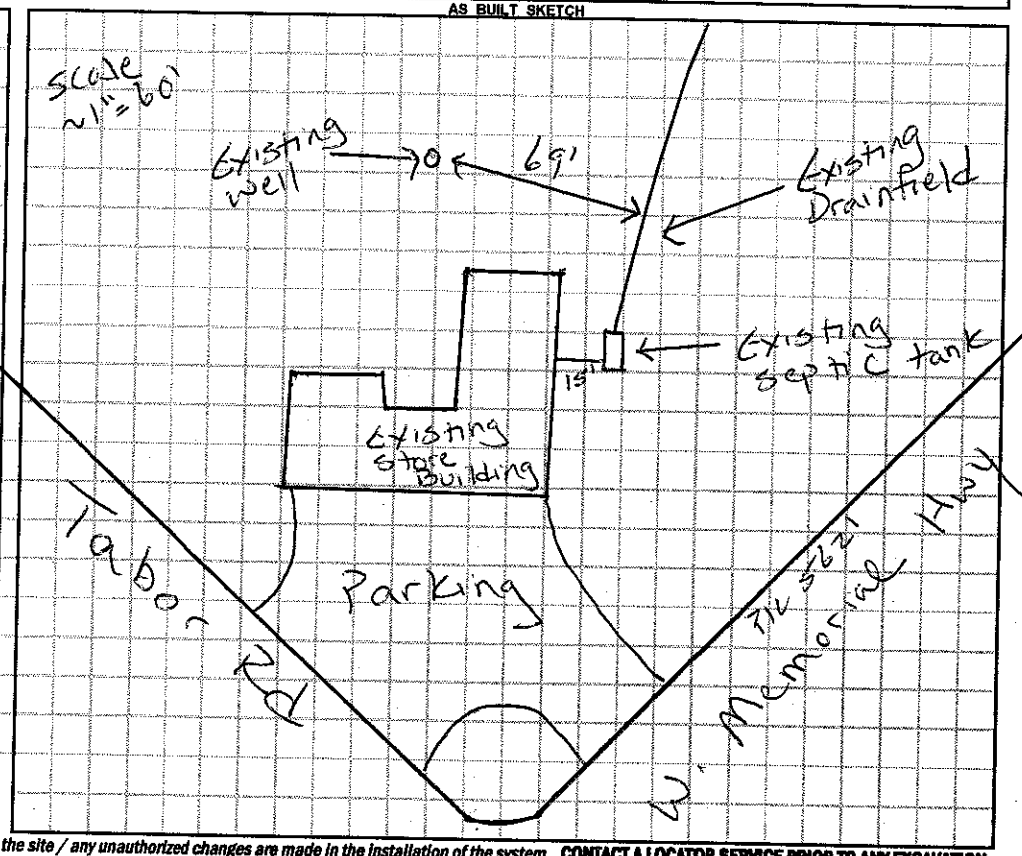

Permit can be suspended or revoked if any false information is supplied toward securing the permit / any unauthorized changes are made to the site / any unauthorized changes are made in the installation of the system. **CONTACT A LOCATOR SERVICE PRIOR TO ANY EXCAVATION**

☐ **IMPROVEMENT PERMIT** *with plat valid without expiration.* ☐ **IMPROVEMENT PERMIT** *with site plan valid for 60 mos.* ☐ **AUTHORIZATION TO CONSTRUCT** *valid for period equal to IMPROVEMENT PERMIT--not to exceed 60 mo.*

Owner / Applicant Signature: Date: Installed by:

IMPROVEMENT PERMIT by: Date: OPERATION PERMIT by: Date:

AUTHORIZATION TO CONSTRUCT by: Date: Existing System Inspected by: Justin O'Rodenaur Date: 5-15-14

Health Dept. Copy - WHITE Applicant (Final Approval) - YELLOW Applicant (Conditional Approval) - PINK