IREDELL COUNTY HEALTH DEPARTMENT

STATESVILLE 704-878-5305 MOORESVILLE 704-664-5281

CI

(1)

IMPROVEMENT PERMIT / AUTHORIZATION TO CONSTRUCT / OPERATION PERMIT / EXISTING SYSTEM INSPECTION

PERMIT# 112186 PIN# ~~4862-44-0638~~ 4862-43-1704 DATE 4-24-03

OWNER OR CONTRACTOR JUDY RITTER PHONE: Business 704-873-2554 Home 704-539-5435

ADDRESS 114 CRATER ROAD, HARMONY, NC 28634

LOCATION I-77 NORTH, TR NC901, 1ST DRIVE ON LEFT PAST CRATER ROAD

SUBDIVISION _____ BLOCK / SECTION _____ LOT _____ LOT AREA 4.6 ACRES SITE CLASS. RS DESIGN FLOW 480 L.T.A.R. 0.30 GPD/FT²

Septic Tank: 1000 Gallons; STB 1012 Date 4-1-03

Pump Tank: _____ Gallons; PT _____ Date _____

Pump Make: _____ Model _____ Serial No. _____

Nitrification Field: No Fields 1 Square Feet 1600 Linear Feet 540

No Lines SIX Trench Width 36" Max Trench Bottom Depth 30" Gravel Depth 12"

☑ New System ☐ Repair System Type: I, II, III, IV, V, VI

System Description: CONVENTIONAL, GRAVITY

Repair System Description: CONVENTIONAL, GRAVITY

Maintenance Agreement Required: ☐ Yes ☑ No

☐ House/Mod. Home ☑ Mobile Home ☐ Business ☐ Other

No. Bedrooms 4 No. Bathrooms 2 No. Employees ____


☐ Slab ☑ Crawl Space ☐ Basement w/plumbing ☐ Basement wo/plumbing

Water Supply: ☐ Individual ☑ Public ☐ Community


Comments:/Conditions: (1) CONTACT HEALTH DEPT. PRIOR TO INSTALLATION TO FLAG-OUT SYSTEM (2) USE ONE FLOW DIVIDER TEE TO ACHIEVE EQUAL DISTRIBUTION INTO TWO SETS OF DROP BOXES.

Comments:/Conditions: TUFFTITE I FILTER MARKER OWNER ROY RITTER APPROVED CHANGES & SYSTEM IS STILL 18'+ OFF P/L THAT HE WILL SURVEY OFF APPROVAL ATTACHED

INITIAL SITE SKETCH

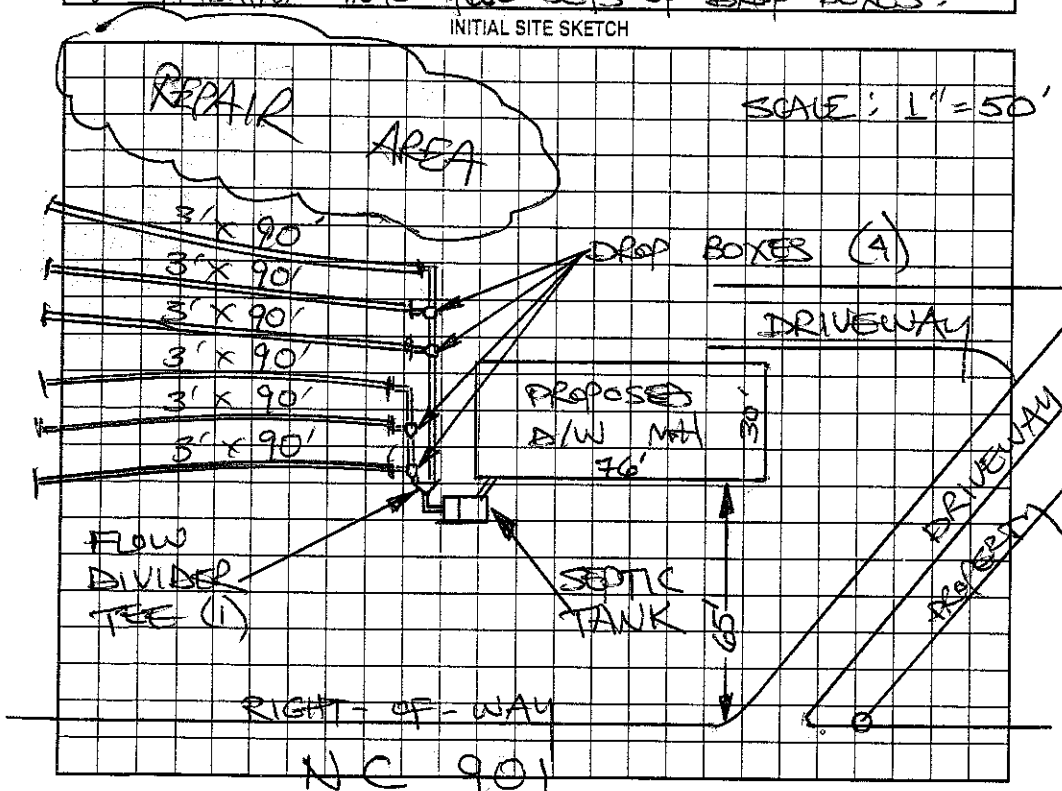

AS BUILT SKETCH

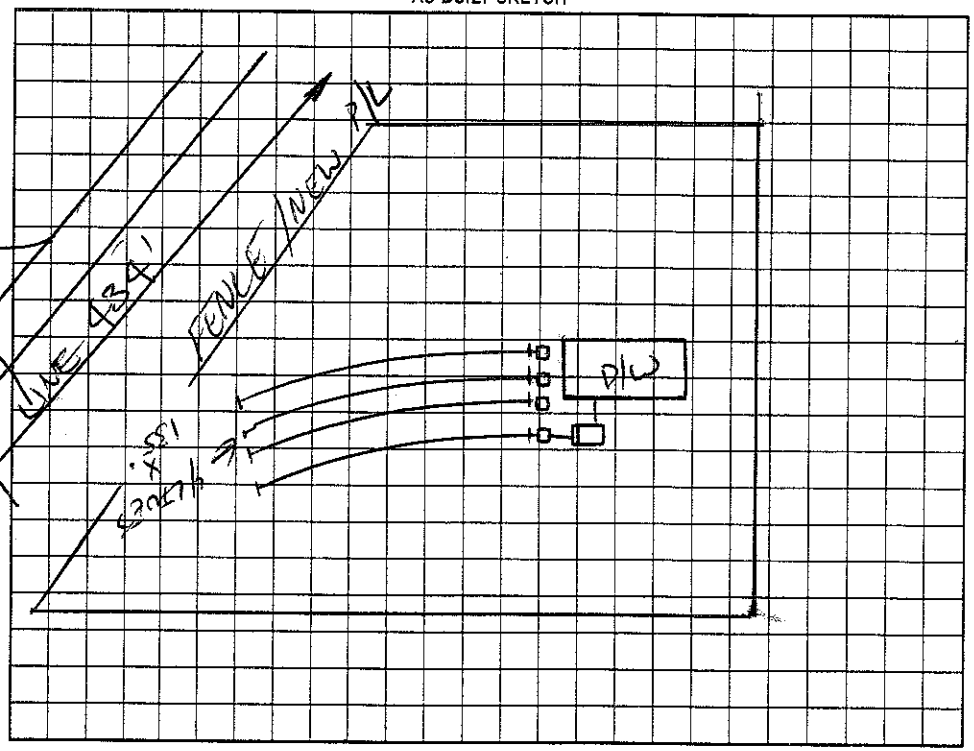

Permit can be suspended or revoked if any false information is supplied toward securing the permit/any unauthorized changes are made to the site/any unauthorized changes are made in the installation of the system. Improvement Permit with plat valid without expiration. Improvement Permit with site plan valid for sixty months. Authorization to Construct is valid for a period equal to that of Improvement Permit – not to exceed sixty months.

Signed: Roy W. Ritter date 4-24-03 Installed by: A-1 BACKHOE

Improvement Permit by: STEVE HEDRICK date 4-24-03 Operation Permit by: _____ date 10-24-03

Authorization to Construct by: STEVE HEDRICK date 4-24-03 Existing System Inspection by: _____ date _____

HEALTH DEPT. COPY: WHITE OWNER COPY (FINAL): YELLOW OWNER COPY (INITIAL): PINK