IREDELL COUNTY HEALTH DEPARTMENT

STATESVILLE 704-878-5305 MOORESVILLE 704-664-5281

IMPROVEMENT PERMIT / AUTHORIZATION TO CONSTRUCT / OPERATION PERMIT / EXISTING SYSTEM INSPECTION

PERMIT# 077498 PIN# 4862 378927 (PART DATE 11-10-98

OWNER OR CONTRACTOR ROBERT E. TRIVETTE PHONE: Business Home 539-4380

ADDRESS 189 CARTWRIGHT ROAD, HARMONY, NC 28634

LOCATION I-77 N, TR NC 901, TL CRATER RD, TR CARTWRIGHT ROAD, DN RIGHT AT BOX # 189

SUBDIVISION BLOCK / SECTION LOT LOT AREA 75 ACRES SITE CLASS. PS DESIGN FLOW 360 L.T.A.R. 0.40 GPD/FT²

Septic Tank: 1000 Gallons; STB 620 Date 10-2-98

Pump Tank: Gallons; PT Date

Pump Make: Model Serial No.

Nitrification Field: No Fields 1 Square Feet 900 Linear Feet 300

No Lines THREE Trench Width 36" Max Trench Bottom Depth 28" Gravel Depth 12"

☑ New System ☐ Repair System Type: I, II, III, IV, V, VI

System Description: CONVENTIONAL GRAVITY

Repair System Description: CONV. GRAVITY

Maintenance Agreement Required: ☐ Yes ☑ No

☐ House/Mod. Home ☑ Mobile Home ☐ Business ☐ Other

No. Bedrooms 3 No. Bathrooms 2 No. Employees


☐ Slab ☑ Crawl Space ☐ Basement w/plumbing ☐ Basement wo/plumbing

Water Supply: ☑ Individual ☐ Public ☐ Community WELL

Comments:/Conditions:

Comments:/Conditions:

INITIAL SITE SKETCH (SCALE: 1" = 40')

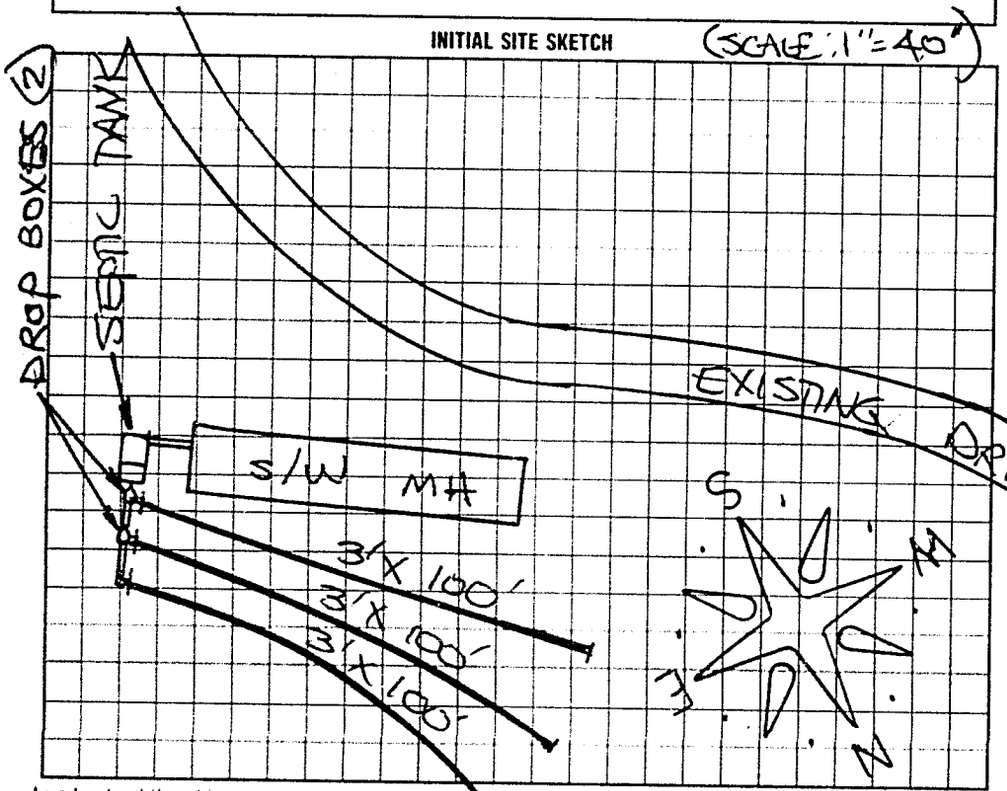

AS BUILT SKETCH

SYSTEM INSTALLED ACCORDING TO INITAL SITE SKETCH

I understand that this permit can be suspended or revoked if any false information is supplied toward securing the permit/any unauthorized changes are made to the site/any unauthorized changes are made in the installation of the system. Improvement Permit with plat valid without expiration. Improvement Permit with site plan valid for sixty months. Authorization to Construct is valid for a period equal to that of Improvement Permit – not to exceed sixty months.

Signed: +Robert E Trivette date 11-10-98 Installed by: SAMMY REAVIS

Improvement Permit by: STEVE HEDRICK date 11-10-98 Operation Permit by: STEVE HEDRICK date 11-25-98

Authorization to Construct by: STEVE HEDRICK date 11-10-98 Existing System Inspection by: date

HEALTH DEPT. COPY WHITE INSPECTION COPY (FINAL) GREEN OWNER COPY (FINAL) YELLOW INSPECTION COPY (INITIAL) PINK OWNER COPY (INITIAL) GOLD

7 0 9 0 0