IREDELL COUNTY HEALTH DEPARTMENT

STATESVILLE 704-878-5305 MOORESVILLE 704-664-5281

IMPROVEMENT PERMIT / AUTHORIZATION TO CONSTRUCT / OPERATION PERMIT / EXISTING SYSTEM INSPECTION

PERMIT# 077774 PIN# 4862 49 0326 DATE 1-5-99

OWNER OR CONTRACTOR ALLEN JAYES PHONE: Business Home 876-2183

ADDRESS P.O. BOX 354, MOORESVILLE, NC 28115

LOCATION I-77N, TR NC 901, TL CRATER, TR CARTWRIGHT, 2ND LOT ON LEFT PAST CHESHIRE RIDGE RD

SUBDIVISION CHESHIRE RIDGE BLOCK / SECTION LOT 7 LOT AREA 1.05 ACRES SITE CLASS. PS DESIGN FLOW 360 L.T.A.R. 0.25 GPD/FT²

Septic Tank: 1000 Gallons; STB 825 Date 10-21-99
Pump Tank: Gallons; PT Date
Pump Make: Model Serial No.
Nitrification Field: No Fields 1 Square Feet 1440 Linear Feet 480
No Lines SIX Trench Width 36" Max Trench Bottom Depth 36" Gravel Depth 12"

[✓] New System [ ] Repair System Type: I (II) III, IV, V, VI
System Description: CONVENTIONAL GRAV'TY
Repair System Description: PPBPS GRAV/PUMP
Maintenance Agreement Required: [ ] Yes [✓] No
[ ] Slab [✓] Crawl Space [ ] Basement w/plumbing [ ] Basement wo/plumbing


[✓] House/Mod. Home No. Bedrooms 3
[✓] Mobile Home No. Bathrooms 2
[ ] Business No. Employees
[ ] Other

Water Supply:
[✓] Individual
[ ] Public
[ ] Community
WELL


Comments:/Conditions: ① SCOUR TRENCH SIDEWALLS & APPLY A LIGHT DUSTING OF LIME PRIOR TO INSTALLING STONE. ② KEEP SYSTEM MINIMUM 100 FEET FROM WELL

Comments:/Conditions: SEPTIC TANK WITH RISERS INSTALLED USING "POLYLOK" FILTER

INITIAL SITE SKETCH

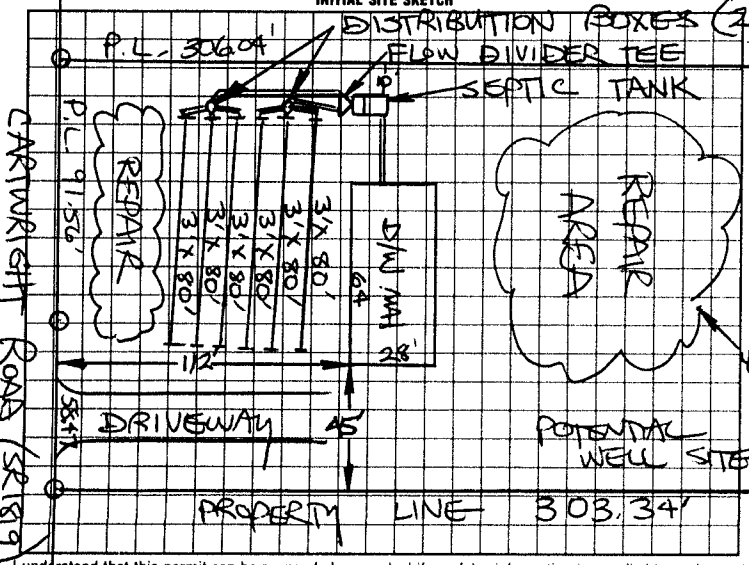

AS BUILT SKETCH

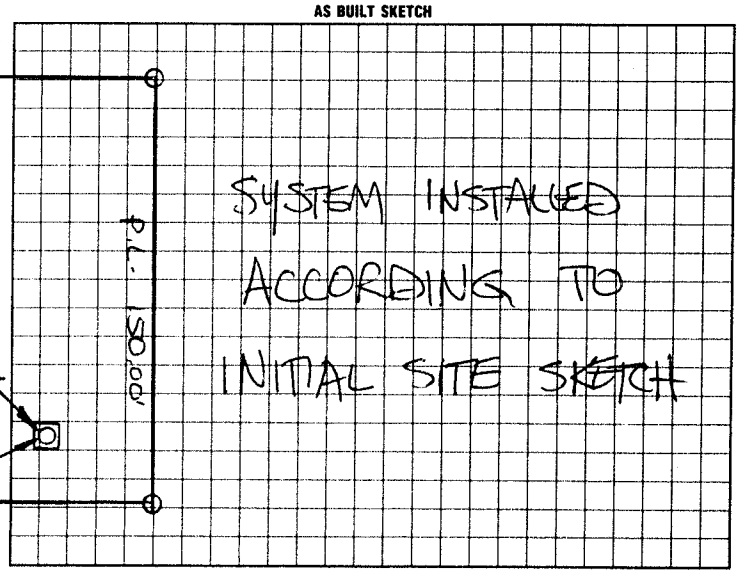

I understand that this permit can be suspended or revoked if any false information is supplied toward securing the permit/any unauthorized changes are made to the site/any unauthorized changes are made in the installation of the system. Improvement Permit with plat valid without expiration. Improvement Permit with site plan valid for sixty months. Authorization to Construct is valid for a period equal to that of Improvement Permit – not to exceed sixty months.

Signed: Jim Beeler date 1-6-99 Installed by: ANDY DANIELS

Improvement Permit by: STEVE HEDRICK date 1-5-99 Operation Permit by: STEVE HEDRICK date 12-9-99

Authorization to Construct by: STEVE HEDRICK date 1-5-99 Existing System Inspection by: date

HEALTH DEPT. COPY: WHITE INSPECTION COPY (FINAL): GREEN OWNER COPY (FINAL): YELLOW INSPECTION COPY (INITIAL): PINK OWNER COPY (INITIAL): GOLD