IREDELL COUNTY HEALTH DEPARTMENT

STATESVILLE 704-878-5305 MOORESVILLE 704-664-5281

IMPROVEMENT PERMIT / AUTHORIZATION TO CONSTRUCT / OPERATION PERMIT / EXISTING SYSTEM INSPECTION

PERMIT# 105524 PIN# 4862-49-1462 DATE 4-10-02

OWNER OR CONTRACTOR CHRIS DILLOW PHONE: Business Home 704-873-0929

ADDRESS P.O. BOX 6883, STATESVILLE, NC 28687

LOCATION I-77 N, TR NC 901, TL CRATER RD, TR CARTWRIGHT RD, THIRD LOT ON LEFT PAST CHESTHIRE RIDGE RD.

SUBDIVISION CHESTHIRE RIDGE BLOCK / SECTION I LOT 8 LOT AREA 1.04 ACRES SITE CLASS. PS DESIGN FLOW 360 L.T.A.R. 0.30 GPD/FT²

Septic Tank: 1000 Gallons; STB 760 Date 11-14-05

Pump Tank: ____ Gallons; PT ____ Date ____

Pump Make: ____ Model EQ.10 Serial No. 300

Nitrification Field: No Fields 1 Square Feet 1200 Linear Feet ~~400~~

No Lines ~~Four~~ 3 Trench Width 36" Max Trench Bottom Depth 36" Gravel Depth 12"

☒ New System ☐ Repair System Type: I, II, III, IV, V, VI

System Description: CONVENTIONAL GRAVITY

Repair System Description: ~~CONVENTIONAL~~ 502a REDUCTION & PUMP

Maintenance Agreement Required: ☐ Yes ☒ No

☐ House/Mod. Home ☒ Mobile Home ☐ Business ☐ Other

No. Bedrooms 3 No. Bathrooms 2 No. Employees ____


☐ Slab ☒ Crawl Space ☐ Basement w/plumbing ☐ Basement wo/plumbing

Water Supply: ~~☒~~ Individual ☐ Public ☐ Community WELL


Comments/Conditions: KEEP SYSTEM MINIMUM 100 FEET FROM WELL

Comments/Conditions: ① AN "ACCEPTED" SYSTEM WAS INSTALLED USING 75 "QUICK-4" INFILTRATOR CHAMBERS IN THREE LINES ② SEPTIC TANK WITH MARKER INSTALLED USING "RED POLYLOK" FIXER

INITIAL SITE SKETCH

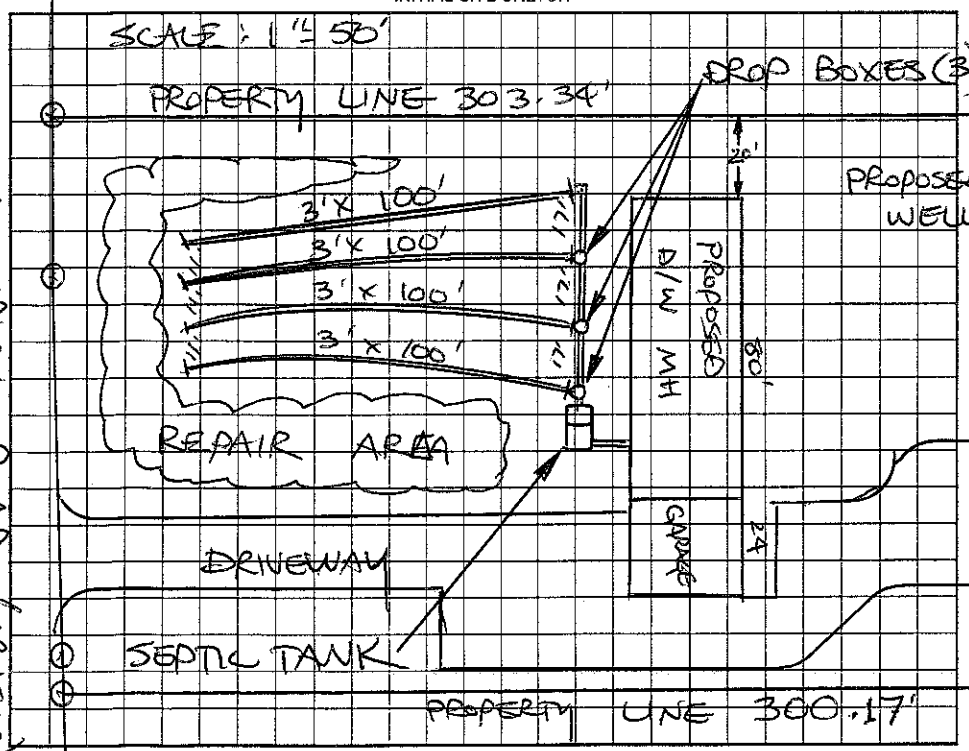

AS BUILT SKETCH

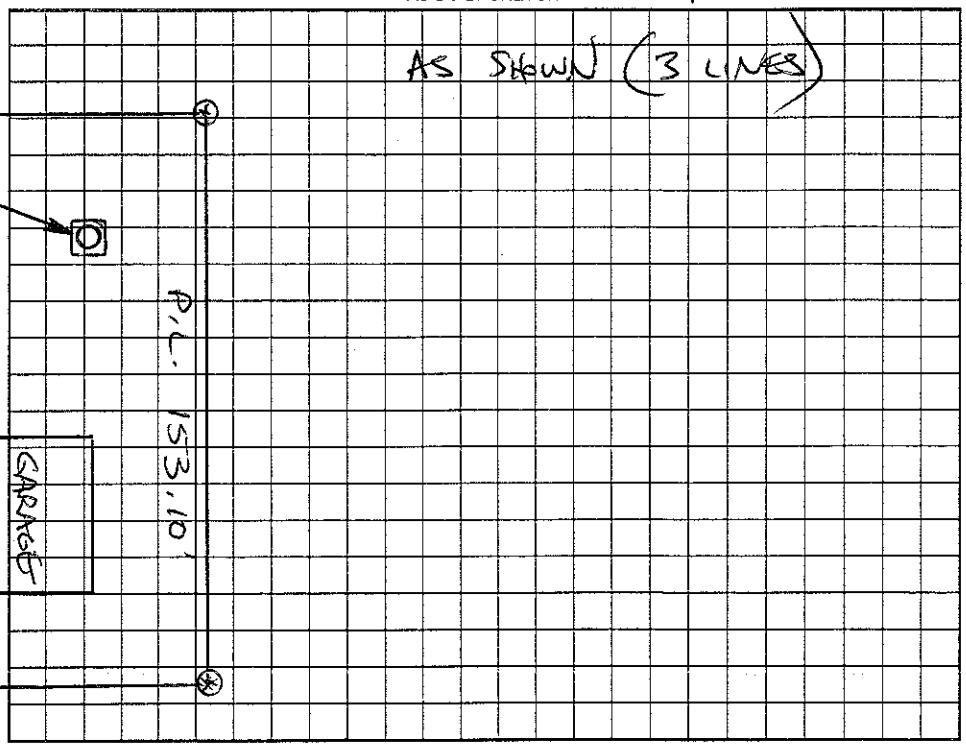

Permit can be suspended or revoked if any false information is supplied toward securing the permit/any unauthorized changes are made to the site/any unauthorized changes are made in the installation of the system. Improvement Permit with plat valid without expiration. Improvement Permit with site plan valid for sixty months. Authorization to Construct is valid for a period equal to that of Improvement Permit – not to exceed sixty months.

Signed: Chris Dillow date 4-10-02 Installed by: ABEES GRADING

Improvement Permit by: STEVE HEDRICK date 4-10-02 Operation Permit by: STEVE HEDRICK date MAR 29, 06

Authorization to Construct by: STEVE HEDRICK date 4-10-02 Existing System Inspection by: ____ date ____

HEALTH DEPT. COPY: WHITE OWNER COPY (FINAL): YELLOW OWNER COPY (INITIAL): PINK