IREDELL COUNTY HEALTH DEPARTMENT STATESVILLE 704-878-5305 MOORESVILLE 704-664-5281

IMPROVEMENT PERMIT / AUTHORIZATION TO CONSTRUCT / OPERATION PERMIT / EXISTING SYSTEM INSPECTION

PERMIT# 077997 PIN# 4862 49 2590 DATE 12-8-98

OWNER OR CONTRACTOR AMERICAN LAND PHONE: Business 878-9595 Home

ADDRESS 1281 GARNER BAGNAL BLVD, STATESVILLE, NC 28677

LOCATION I-77N, TR NC901, TL CRATER, TR CARTWRIGHT, LOT ON LEFT PAST CHESHIRE RIDGE ROAD

SUBDIVISION CHESHIRE RIDGE BLOCK / SECTION I LOT 9 LOT AREA 1.03 ACRES SITE CLASS. PS DESIGN FLOW 360 L.T.A.R. 0.30 GPD/FT²

Septic Tank: 1000 Gallons; STB 1012 Date 3-28-99
Pump Tank: Gallons; PT Date
Pump Make: Model Serial No.
Nitrification Field: No Fields 1 Square Feet 1200 Linear Feet 400
No Lines FIVE Trench Width 36" Max Trench Bottom Depth 30" Gravel Depth 12"

✓ New System Repair System Type I (II) III IV V VI
System Description: CONVENTIONAL GRAVITY
Repair System Description: CONV. GRAVITY
Maintenance Agreement Required Yes ✓ No
Slab ✓ Crawl Space Basement w/plumbing Basement wo/plumbing


House/Mod Home ✓ Mobile Home Business Other
No. Bedrooms 3 No. Bathrooms 2 No. Employees

Water Supply: ✓ Individual ☐ Public ☐ Community WELL

Comments/Conditions: KEEP SYSTEM MINIMUM 100 FEET FROM WELL

Comments/Conditions:

INITIAL SITE SKETCH SCALE: 1" = 50'

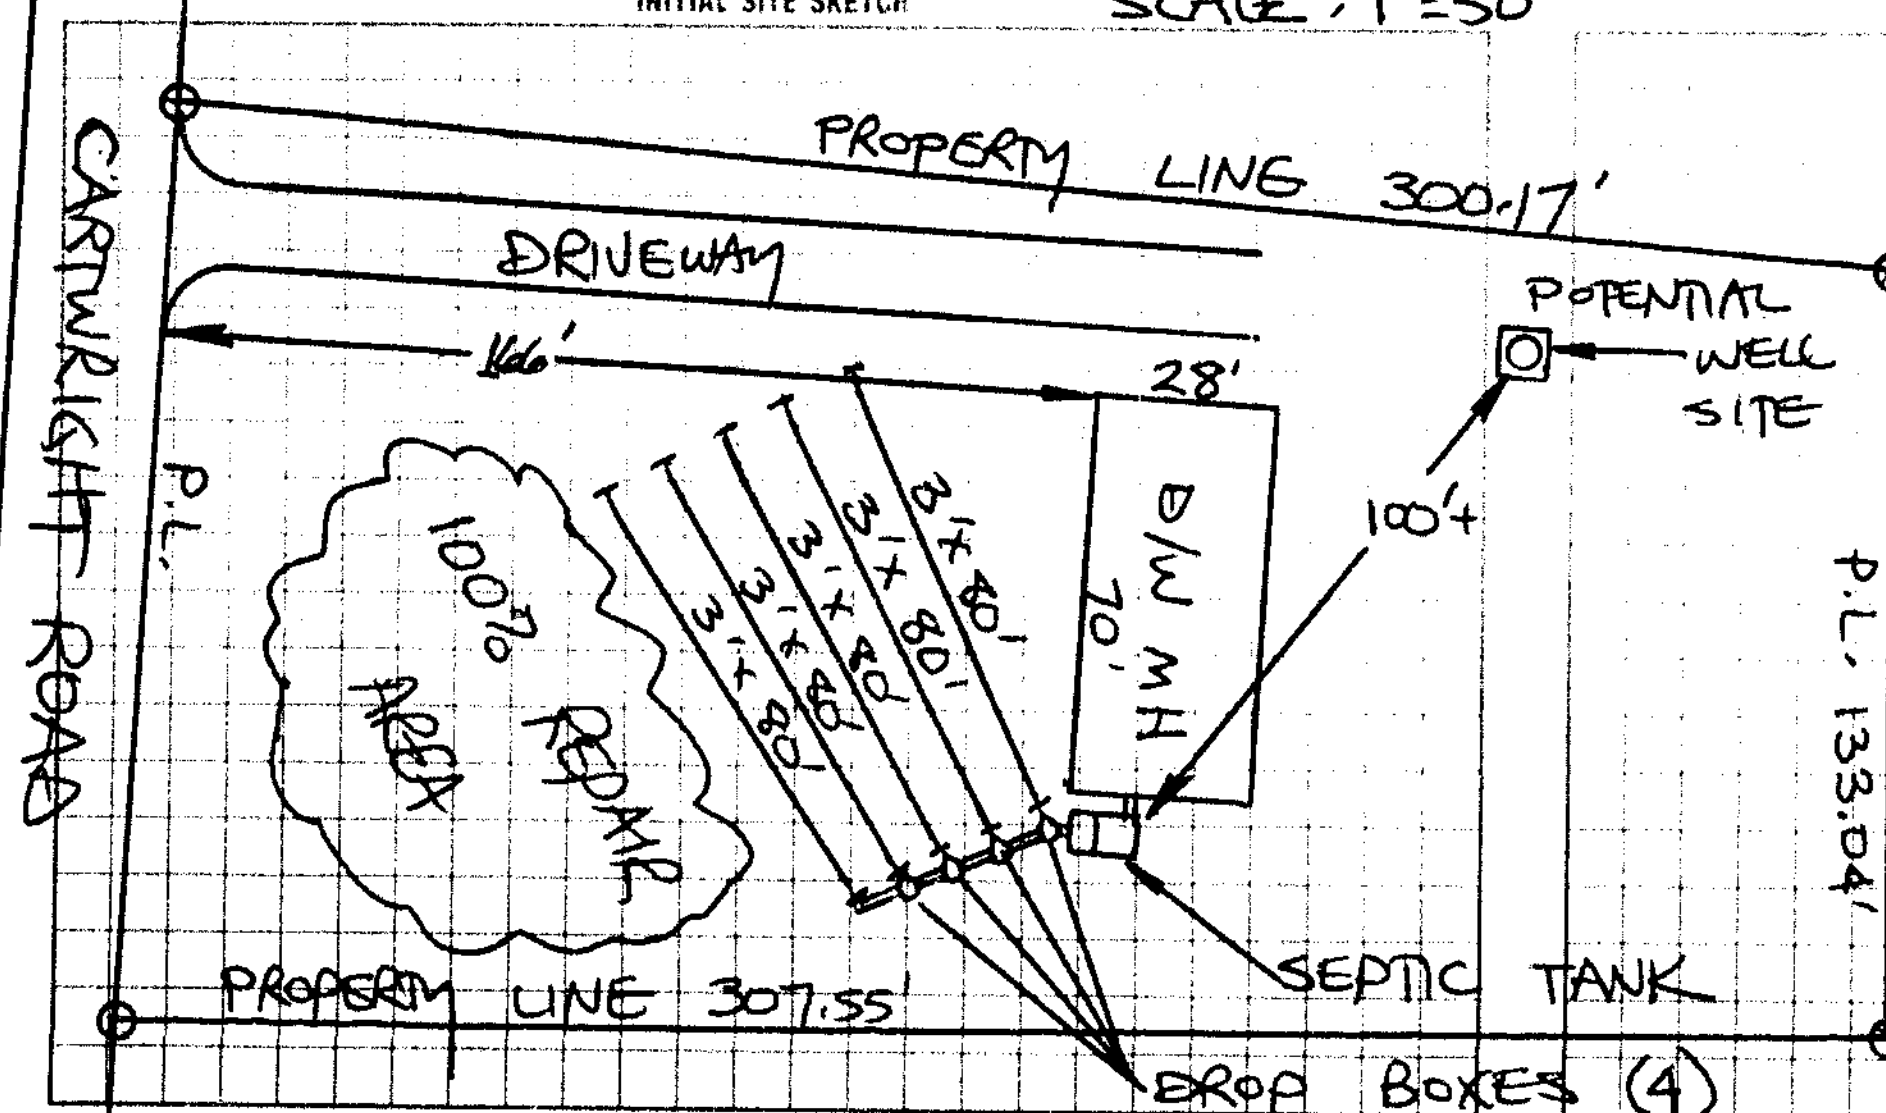

AS BUILT SKETCH

installed as shown

I understand that this permit can be suspended or revoked if any false information is supplied toward securing the permit/any unauthorized changes are made to the site/any unauthorized changes are made in the installation of the system. Improvement Permit with plat valid without expiration. Improvement Permit with site plan valid for sixty months. Authorization to Construct is valid for a period equal to that of Improvement Permit – not to exceed sixty months.

Signed: Claudette Ballard date 12-10-98
Improvement Permit by: STEVE HEDRICK date 12-8-98
Authorization to Construct by: STEVE HEDRICK date 12-8-98

Installed by: A-1 Backhoe
Operation Permit by: [signature] RS date 5-17-99
Existing System Inspection by: date

HEALTH DEPT. COPY WHITE INSPECTION COPY (FINAL) GREEN OWNER COPY (FINAL) YELLOW INSPECTION COPY (INITIAL) PINK OWNER COPY (INITIAL) GOLD