IREDELL COUNTY HEALTH DEPARTMENT

STATESVILLE 704-878-5305 MOORESVILLE 704-664-5281

IMPROVEMENT PERMIT / AUTHORIZATION TO CONSTRUCT / OPERATION PERMIT / EXISTING SYSTEM INSPECTION

PERMIT# 90037 PIN# 4862492997 DATE 6-22-00

OWNER OR CONTRACTOR Timothy wiles PHONE: Business Home 704 546 5145

ADDRESS PO Box 434 Harmony N.C.

LOCATION 1777 401 East TL Eagle mill TL Trivette on left after Cartwright Rd

SUBDIVISION Cheshire Hills BLOCK / SECTION 1 LOT 17 LOT AREA 1.50 acres SITE CLASS PS DESIGN FLOW 360 L.T.A.R. 0.33 gpd/ft²

Septic Tank: 1000 Gallons; STB 1012 Date 4-29-00
Pump Tank: Gallons; PT Date
Pump Make: Model Serial No.
Nitrification Field: No Fields 1 Square Feet 1080 Linear Feet 360
No Lines 3 Trench Width 36" Max Trench Bottom Depth 36" Gravel Depth 12"

☒ New System ☐ Repair System Type: I (II) III. IV. V. VI
System Description: conv. Gravity
Repair System Description:
Maintenance Agreement Required: ☐ Yes ☒ No


☐ House/Mod. Home No. Bedrooms 3
☒ Mobile Home No. Bathrooms 2
☐ Business No. Employees
☐ Other
☐ Slab ☐ Crawl Space ☐ Basement w/plumbing ☐ Basement wo/plumbing

Water Supply: ☒ Individual ☐ Public ☐ Community


Comments:/Conditions:

Comments:/Conditions: SEPTIC TANK W/ MARKER INSTALLED USING "POLY LOK" FILTER

INITIAL SITE SKETCH

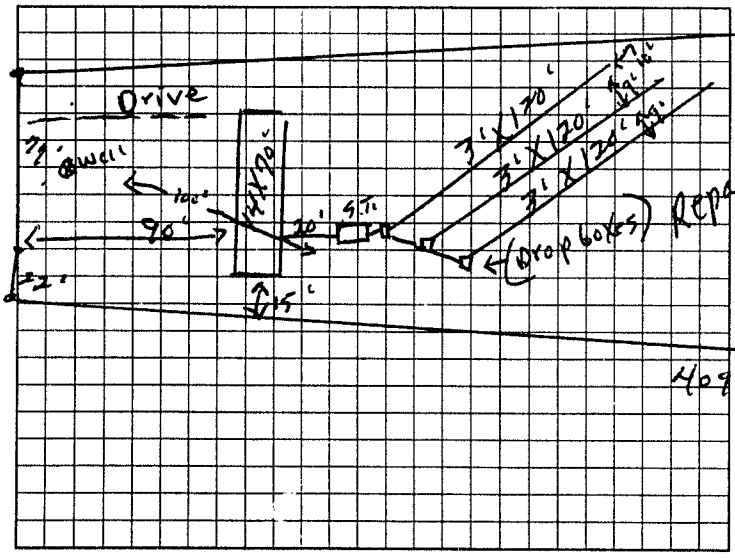

AS BUILT SKETCH

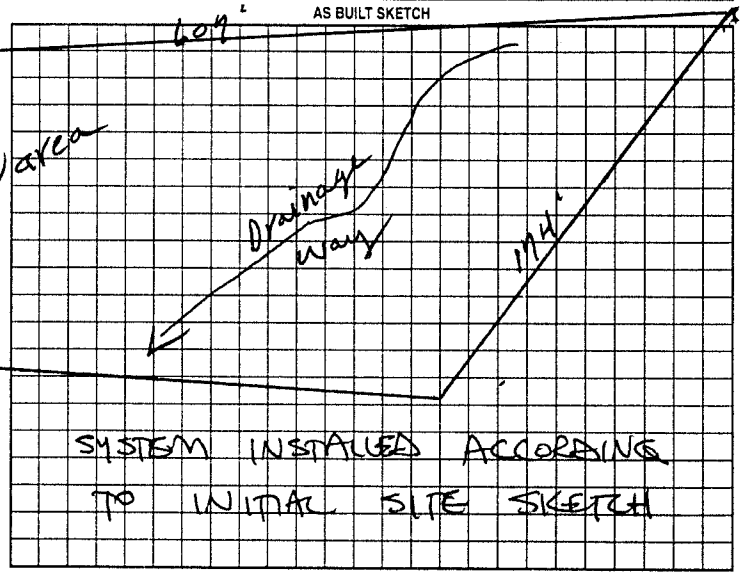

SYSTEM INSTALLED ACCORDING TO INITIAL SITE SKETCH

Permit can be suspended or revoked if any false information is supplied toward securing the permit/any unauthorized changes are made to the site/any unauthorized changes are made in the installation of the system. Improvement Permit with plat valid without expiration. Improvement Permit with site plan valid for sixty months. Authorization to Construct is valid for a period equal to that of Improvement Permit – not to exceed sixty months.

Signed: Y C Charles Reed date Installed by: A-1 BACKHOE

Improvement Permit by: C. C. Moore date 6-22-00 Operation Permit by: STEVE HEDRICK date 6-28-2000

Authorization to Construct by: C. C. Moore date 6-22-00 Existing System Inspection by: date

HEALTH DEPT. COPY: WHITE OWNER COPY (FINAL): YELLOW OWNER COPY (INITIAL): PINK