IREDELL COUNTY HEALTH DEPARTMENT - *ENVIRONMENTAL HEALTH* ☑ STATESVILLE OFFICE 704-878-5305 ☐ MOORESVILLE OFFICE 704-664-5281

IMPROVEMENT PERMIT / AUTHORIZATION TO CONSTRUCT / OPERATION PERMIT / EXISTING SYSTEM INSPECTION

PERMIT # 16411 PIN # 4862-49-3991 DATE DECEMBER 3, 2010

OWNER CECILIA CALVARIO APPLICANT: PHONE: Home/Cell # 704-657-1063 Business #

SITE ADDRESS 173 TRIVETTE ROAD OWNER / APPLICANT ADDRESS


SITE DIRECTIONS I-77 N, TR NC 901, TL WINTHROP RD, TR CRATER RD, TR CARTWRIGHT, TL TRIVETTE, 3RD LOT ON (L)

SUBDIVISION CHESHIRE RIDGE BLOCK / SECTION I LOT # 16 LOT AREA 1.5 ACRES DESIGN FLOW 480 L.T.A.R. 0.30 GAD/FT²


Septic Tank EX	Gallons: STB	Date	☐ New System ☐ Repair ☐ Expansion System Type I II (III) IV V VI	☑ Residence	No. Bedrooms 4	Water Supply
Pump Tank	Gallons: PT	Date	System Description: 25% REDUCTION, GRAVITY	☐ Business	No. Persons	☐ Private
Pump Make	Model	Serial #	Repair System Description: 25% REDUCTION, GRAVITY	☐ Other	No. Employees	☑ Public
No. Nitrification Fields: 1	No. Lines 2	Linear Feet 200	Maintenance Agreement Required ☐ YES ☑ NO	☐ Slab	☑ Crawl Space	☐ Community
Trench Width 36"	Max. Trench Bottom Depth 30"	Gravel Depth N/A	☑ GRAVITY ☐ PRESSURE	☐ Basement w/plumbing	☐ Basement w/o plumbing	

Comments / Conditions: INSTALL EXPANSION TO DRAINFIELD BY USING 25% REDUCTION SYSTEM ON CONTOUR, NO DEEPER THAN 30 INCHES.

INITIAL SITE SKETCH

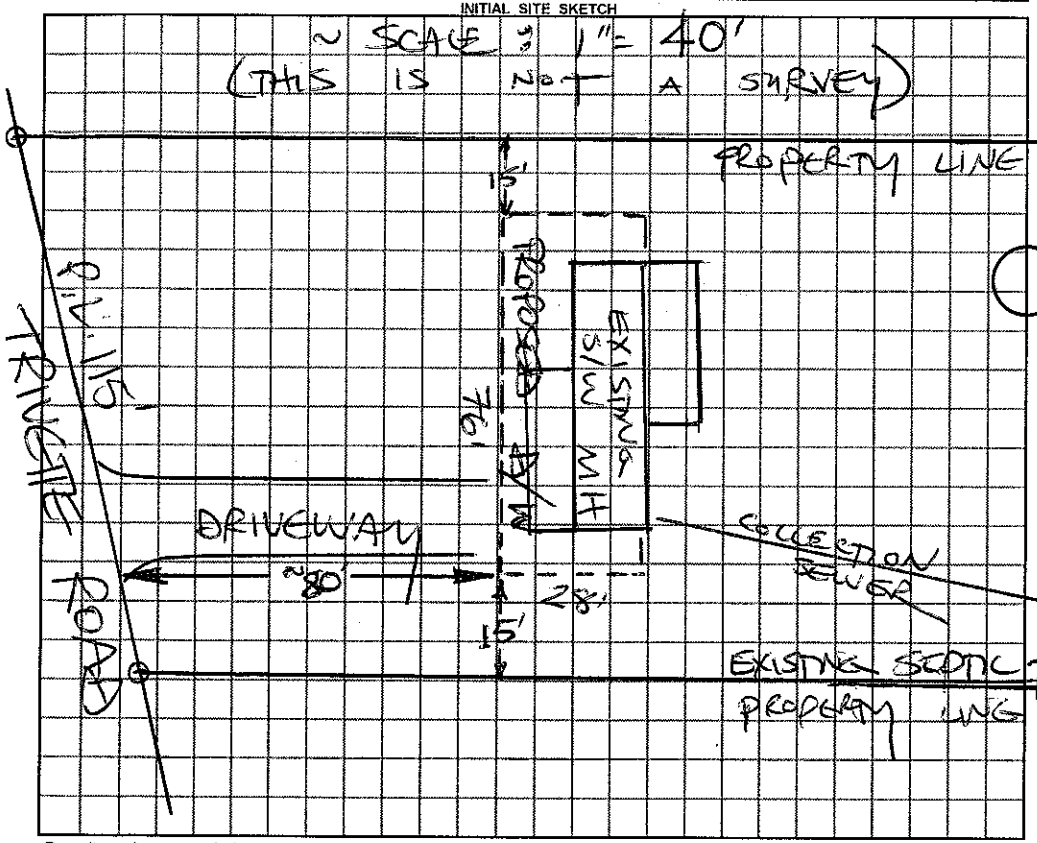

AS BUILT SKETCH

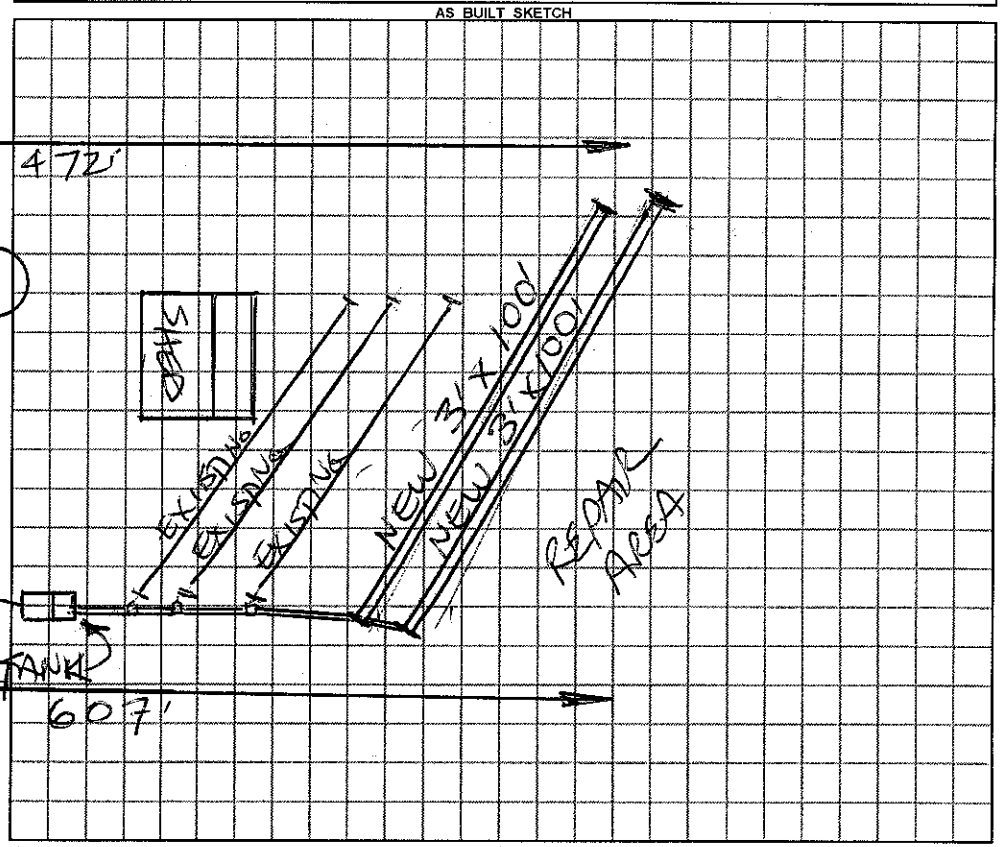

Permit can be suspended or revoked if any false information is supplied toward securing the permit / any unauthorized changes are made to the site / any unauthorized changes are made in the installation of the system.

☐ ***IMPROVEMENT PERMIT*** with plat valid without expiration. ☐ ***IMPROVEMENT PERMIT*** with plat valid without expiration. ☐ ***AUTHORIZATION TO CONSTRUCT*** valid for period equal to IMPROVEMENT PERMIT--not to exceed 60 mo.

Owner / Applicant Signature: Miguel Dionicio Date 12-3-2010 Installed by: Jackhoe

IMPROVEMENT PERMIT by: STEVE HEDRICK REHS Date 12-3-2010 OPERATION PERMIT by: REHS Date 12-7-10

AUTHORIZATION TO CONSTRUCT by: STEVE HEDRICK REHS Date 12-3-2010 Existing System Inspected by: REHS Date

YOU SHOULD CONTACT A LOCATOR SERVICE PRIOR TO ANY EXCAVATION

White Copy -- Environmental Health YELLOW COPY (Final) Owner / Applicant PINK COPY (Initial) Owner / Applicant