IREDELL COUNTY HEALTH DEPARTMENT

STATESVILLE 704-878-5305 MOORESVILLE 704-664-5281

IMPROVEMENT PERMIT / AUTHORIZATION TO CONSTRUCT / OPERATION PERMIT / EXISTING SYSTEM INSPECTION

PERMIT# 116499 PIN# 4862-52-~~6942~~ 0980 DATE 11-6-03

OWNER OR CONTRACTOR RYAN NAWROCKI PHONE: Business 764-902-9441 Home

ADDRESS 1085 TABOR RD OLIN NC 28660

LOCATION 77 NORTH (E) 901 ON LEFT AT CORNER OF 901 & EAGLEMILLS.

SUBDIVISION BLOCK / SECTION LOT LOT AREA 12.75 SITE CLASS. PS DESIGN FLOW 480 L.T.A.R. .3

Septic Tank: 1000 Gallons; STB 620 Date 8-9-04
Pump Tank: Gallons; PT Date
Pump Make: Model Serial No.
Nitrification Field: No Fields 1 Square Feet 1600 Linear Feet 533'
No Lines 4x133' Trench Width 36" Max Trench Bottom Depth 36" Gravel Depth 15"

☒ New System ☐ Repair System Type: I, (II), III, IV, V, VI
System Description: CONV LOAD
Repair System Description: SAME
Maintenance Agreement Required: ☐ Yes ☒ No


☒ House/Mod. Home No. Bedrooms 4
☐ Mobile Home No. Bathrooms 3.5
☐ Business No. Employees
☐ Other
☐ Slab ☒ Crawl Space ☐ Basement w/plumbing ☐ Basement wo/plumbing

Water Supply:
☐ Individual
☒ Public
☐ Community

Comments:/Conditions: ① SYSTEM & HOUSE IS COMPLETELY FLAGGED OUT ② INSTALL LINES ON CONTOURS ③ MAINTAIN SETBACKS

Comments:/Conditions: ① #5 ② RED POLYLOK

INITIAL SITE SKETCH "NOT TO SCALE"

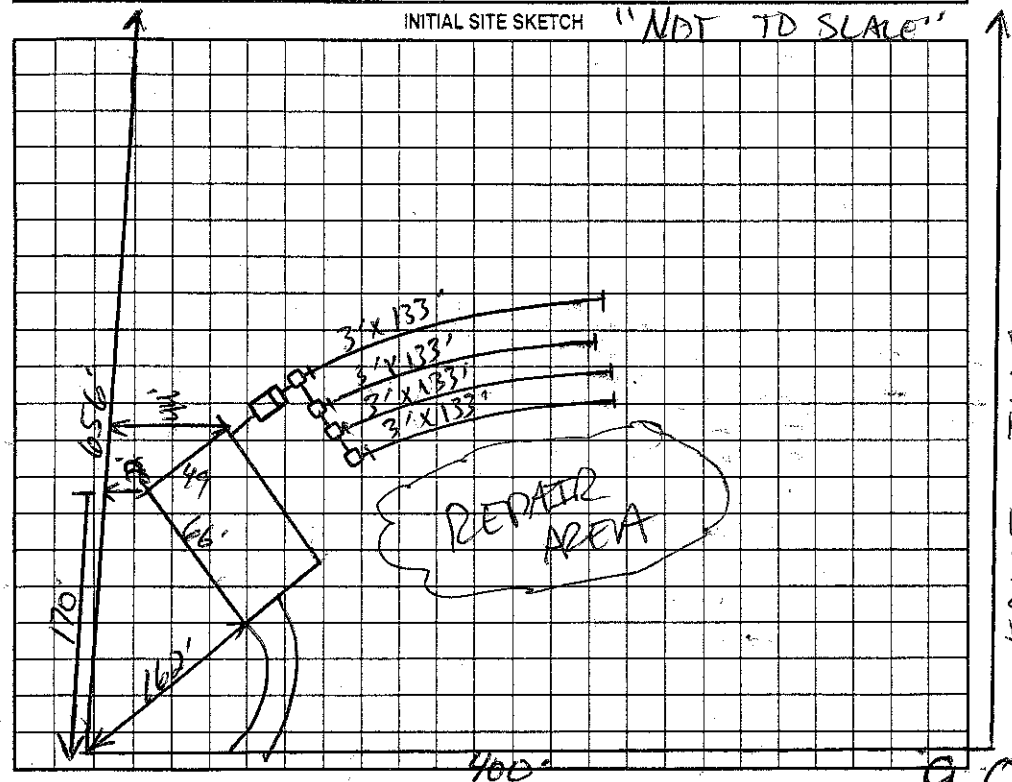

AS BUILT SKETCH

* System installed according to sketch

Permit can be suspended or revoked if any false information is supplied toward securing the permit/any unauthorized changes are made to the site/any unauthorized changes are made in the installation of the system. Improvement Permit with plat valid without expiration. Improvement Permit with site plan valid for sixty months. Authorization to Construct is valid for a period equal to that of Improvement Permit – not to exceed sixty months.

Signed: date 11-6-03 Installed by: SAMMY REAVIS

Improvement Permit by: date 11-6-03 Operation Permit by: date 9-15-04

Authorization to Construct by: RS date 11-6-03 Existing System Inspection by: date

HEALTH DEPT. COPY: WHITE OWNER COPY (FINAL): YELLOW OWNER COPY (INITIAL): PINK