THIS PERMIT REPLACES EXPIRED PERMIT # 19326

IREDELL COUNTY HEALTH DEPARTMENT

STATESVILLE 704-878-5305 (C) MOORESVILLE 704-664-5281

IMPROVEMENT PERMIT / AUTHORIZATION TO CONSTRUCT / OPERATION PERMIT / EXISTING SYSTEM INSPECTION

PERMIT# ~~10659~~ 10730 4862-55-7602 DATE 6-12-02

OWNER OR CONTRACTOR ROGER D. KENNEDY PHONE Business Home 704-546-2239

ADDRESS 4062 HARMONY HIGHWAY HARMONY NC 28634

LOCATION US 21 N, TL TABOR, CONTINUE EAGLE MILLS RD, 0.5 MILE ON LEFT

SUBDIVISION BLOCK / SECTION LOT LOT AREA 1.05 ACRES SITE CLASS PS DESIGN FLOW 360 L.T.A.R. 0.30 GPD/FT²

Septic Tank: 1000 Gallons: STB 620 Date 10-28-01
Pump Tank: Gallons: PT Date
Pump Make: Model Serial No
Nitrification Field: No Fields 1 Square Feet 1200 Linear Feet 400
No Lines THREE Trench Width 36" Max Trench Bottom Depth 36"

✓ New System Repair System Type I II III IV V
System Description CONVENTIONAL, GRAVITY
Repair System Description CONVENTIONAL, GRAVITY
Maintenance Agreement Required Yes ✓ No
Gravel Depth 12" Slab ✓ Crawl Space Basement w/plumbing Basement wo/plumbing


✓ House/Mod. Home No. Bedrooms 3
✓ Mobile Home No. Bathrooms 2
Business No. Employees
Other

Water Supply:
✓ Individual
☐ Public
☐ Community
WELL


Comments/Conditions

Comments/Conditions SEPTIC TANK WITH MARKER INSTALLED USING "FABER" FILTER SYSTEM ALTERED AS SHOWN AT REQUEST OF OWNER & INSTALLED

INITIAL SITE SKETCH

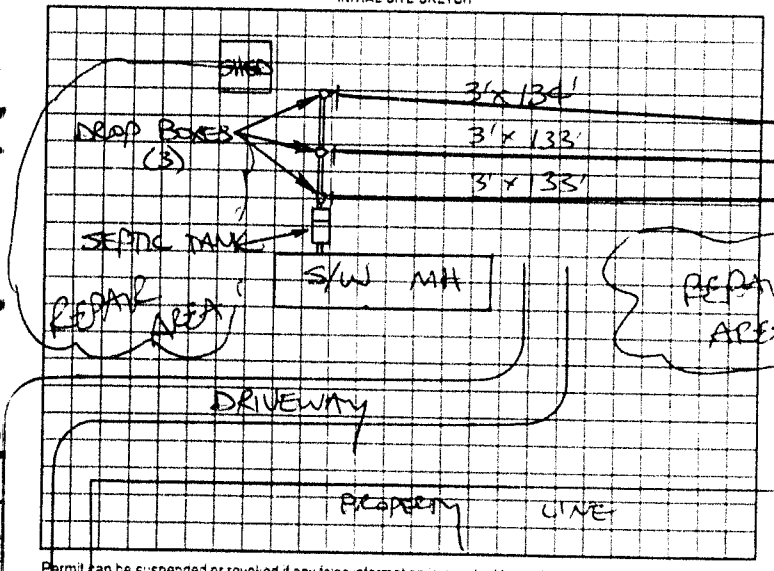

AS BUILT SKETCH

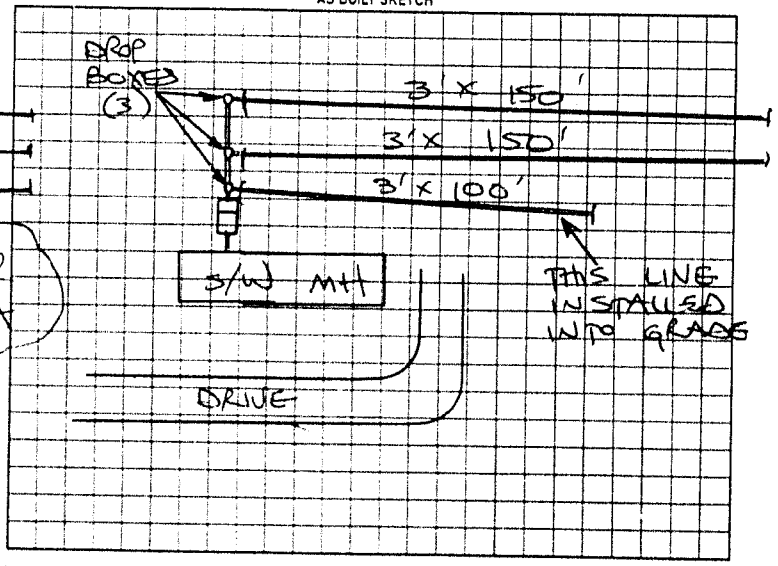

Permit can be suspended or revoked if any false information is supplied toward securing the permit, any unauthorized changes are made to the site, any unauthorized changes are made in the installation of the system. Improvement Permit with plat valid without expiration. Improvement Permit with site plan valid for sixty months. Authorization to Construct is valid for a period equal to that of Improvement Permit - not to exceed sixty months.

Signed: Roger Kennedy date 6-12-02 Installed by SAMMY REAVIS

Improvement Permit by STEVE HEDRICK date 6-12-02 Operation Permit by STEVE HEDRICK date 7-1-02

Authorization to Construct by: STEVE HEDRICK date 6-12-02 Existing System Inspection by date

HEALTH DEPT COPY WHITE OWNER COPY (FINAL) YELLOW OWNER COPY (INITIAL) PINK