IREDELL COUNTY HEALTH DEPARTMENT

STATESVILLE 704-878-5305 MOORESVILLE 704-664-5281

IMPROVEMENT PERMIT / AUTHORIZATION TO CONSTRUCT / OPERATION PERMIT / EXISTING SYSTEM INSPECTION

PERMIT# 151694 PIN# 4862568653 DATE 8-11-08

OWNER OR APPLICANT Roger Kennedy PHONE: Business Home 704 546 2239

ADDRESS 319 Eagle Mills Rd.

LOCATION Hwy 21N to 901 turn left, (R) on Eagles Mills - Post Harmony Gardens ~½ mile on left.

SUBDIVISION n/a BLOCK / SECTION LOT 1 LOT AREA 9.121 SITE CLASS. T5 DESIGN FLOW 240 L.T.A.R. .3

Septic Tank: 1000 Gallons: STB 700 Date 5-28-08

Pump Tank: Gallons: PT Date

Pump Make: Model Serial No.

Nitrification Field: No Fields 1 Square Feet 900 Linear Feet 200

No Lines 3 Trench Width 36" Max Trench Bottom Depth 36" Gravel Depth

■ New System ☐ Repair ☐ Expansion (Conventional) System Type: I (II) III IV V VI

System Description: 26% Reduction Gravity

Repair System Description: 25% Reduction Gravity

Maintenance Agreement Required: ☐ Yes ■ No

(X) House/Mod. Home (X) Mobile Home ☐ Business ☐ Other

No Bedrooms 2 No. Persons No. Employees


Water Supply: ● Individual ☐ Public ☐ Community

☐ Slab ■ Crawl Space ☐ Basement w/plumbing ☐ Basement wo/plumbing


Comments:/Conditions: An approved system may also be used.

Comments:/Conditions: ST has Filter Attached

INITIAL SITE SKETCH

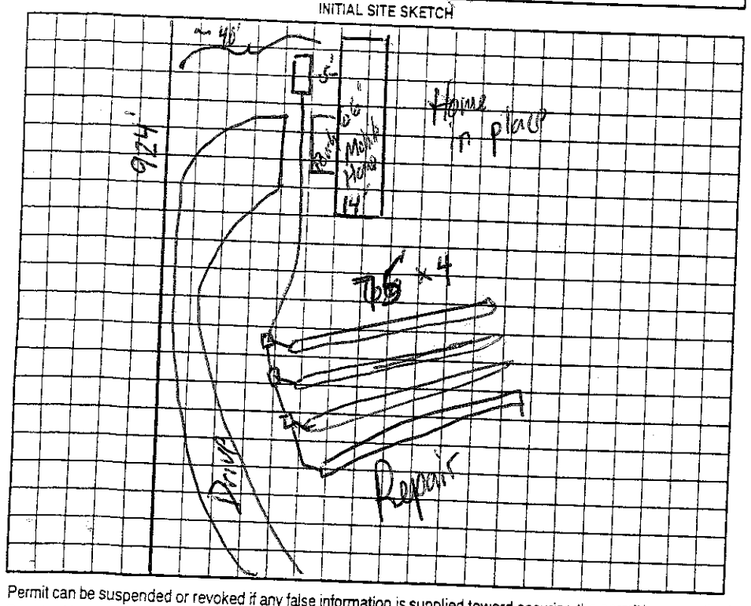

AS BUILT SKETCH

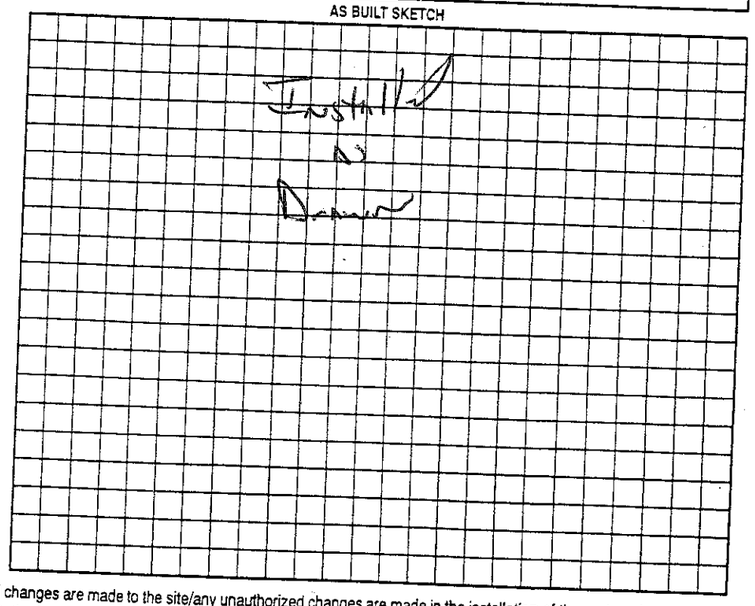

Permit can be suspended or revoked if any false information is supplied toward securing the permit/any unauthorized changes are made to the site/any unauthorized changes are made in the installation of the system. Improvement Permit with plat valid without expiration ☐ Improvement Permit with site plan valid for sixty months ■ Authorization to Construct is valid for a period equal to that of Improvement Permit – not to exceed sixty months.

Signed: Roger Kennedy date 8-13-08

Improvement Permit by: date 8-11-08

Authorization to Construct by: date 8-11-08

Installed by: Sammy Revis

Operation Permit by: R.S. date 8 September 08

Existing System Inspection by: date

HEALTH DEPT. COPY: WHITE OWNER COPY (FINAL): YELLOW OWNER COPY (INITIAL): PINK