IREDELL COUNTY HEALTH DEPARTMENT

Statesville Office (704) 878-5305 Mooresville Office (704) 660-3625 PERMIT # 177540

IMPROVEMENT PERMIT / AUTHORIZATION TO CONSTRUCT / OPERATION PERMIT / EXISTING SYSTEM

PIN # 4862591266

APPLICANT: Gilmer Binkley APPLICANT ADDRESS: 125 Trivette Rd.

PHONE: 704-539-4368 ALT. PHONE: 704-450-3352

SITE ADDRESS: 125 Trivette Rd.

SITE DIRECTIONS: I-77 N TR 901 TL Eagle Mills TL Trivette Rd.


SUBDIVISION: N/A SECTION: N/A LOT # N/A LOT AREA: 58.22 acres DESIGN FLOW: 240 gpd L.T.A.R.: 0.3

Septic Tank	1000 (gal)	STB 956	Date 11-24-12	☑ New System ☐ Repair ☐ Expansion	System Type: I (II) III IV V VI	☑ Residence	No. Bedrooms 2
Pump Tank	(gal)	PT	Date	System Description:	Conventional	☐ Business	No. Persons
Pump Make	Model		Serial #	Repair System Description:	Conventional	☐ Other	No. Employees
# Nitrification Fields	1 # Lines 3		Linear Ft: 270	Maintenance Agreement Required:	☐ YES ☑ NO	☐ Slab	☑ Crawl Space
Trench Width	36" Max. Trench Bottom Depth 36"		Gravel Depth 12"	☑ GRAVITY	☐ PRESSURE	☐ Basement w/ plumbing	☐ Basement w/o plumbing

Water Supply: ☐ Private ☑ Public ☐ Community

Comments / Conditions: Install a conventional system on contour with serial distribution. Use drop boxes to connect nitrification lines to septic tank. Pump & crush old septic tank.

INITIAL SITE SKETCH

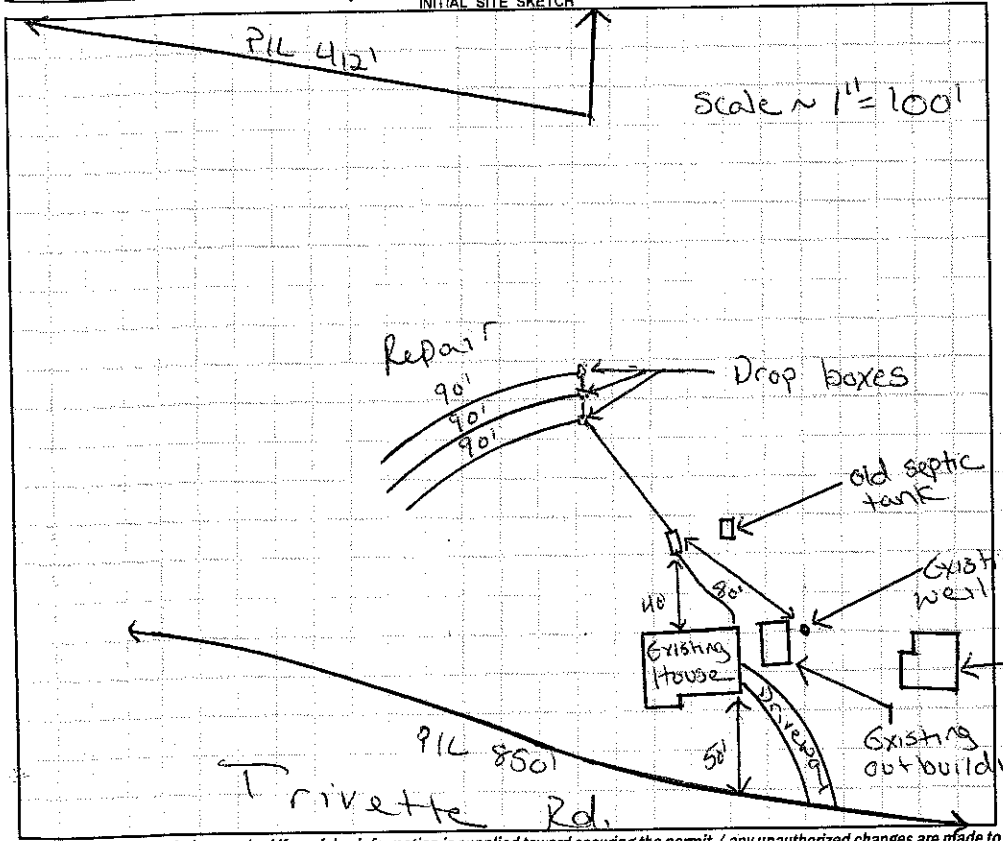

AS BUILT SKETCH

- Red Poly/Ok filter installed
- Installed as drawn

Permit can be suspended or revoked if any false information is supplied toward securing the permit / any unauthorized changes are made to the site / any unauthorized changes are made in the installation of the system. **CONTACT A LOCATOR SERVICE PRIOR TO ANY EXCAVATION**

☐ **IMPROVEMENT PERMIT** *with plat* valid without expiration. ☑ **IMPROVEMENT PERMIT** *with site plan* valid for 60 mos. ☑ **AUTHORIZATION TO CONSTRUCT** valid for period equal to IMPROVEMENT PERMIT--not to exceed 60 mo.

Owner / Applicant Signature: Kristen Stroud Date: 3-22-13 Installed by: Tommy Nixon

IMPROVEMENT PERMIT by: Justin Henderson Date: 3-21-13 OPERATION PERMIT by: Justin Henderson Date: 4-2-13

AUTHORIZATION TO CONSTRUCT by: Justin Henderson Date: 3-21-13 Existing System Inspected by: Date:

Health Dept. Copy - WHITE Applicant (Final Approval) - YELLOW Applicant (Conditional Approval) - PINK