Michael Price owner as of 5-5-09

IREDELL COUNTY HEALTH DEPARTMENT

STATESVILLE 704-878-5305 (at) MOORESVILLE 704-664-5281

IMPROVEMENT PERMIT / AUTHORIZATION TO CONSTRUCT / OPERATION PERMIT / EXISTING SYSTEM INSPECTION

PERMIT# 15100 PIN# 4862640847 DATE 23 July 08

OWNER OR APPLICANT Clayton Daniel PHONE: Business _____ Home 704-873-2547

ADDRESS 2026 Northside Drive Statesville NC 28677

LOCATION 77 N Exit 65 Rt. Rt. Eagle mill lot on left 1 mile

SUBDIVISION Eagle Mill Estates BLOCK / SECTION _____ LOT 1 LOT AREA 1.739 SITE CLASS. _____ DESIGN FLOW 360 L.T.A.R. .2

Septic Tank: 1000 Gallons: STB 760 Date 11-24-09

Pump Tank: _____ Gallons: PT _____ Date _____

Pump Make: _____ Model _____ Serial No. _____

Nitrification Field: No Fields ____ Square Feet 1800 Linear Feet 450

No Lines 5 Trench Width 36" Max Trench Bottom Depth 24"

☑ New System ☐ Repair ☐ Expansion System Type: I II III IV V VI

System Description: 25% Gravity

Repair System Description: 25% Gravity

Maintenance Agreement Required: ☐ Yes ☐ No

Gravel Depth _____ ☐ Gravity ☐ Pressure

☑ House/Mod. Home No. Bedrooms 3

☐ Mobile Home No. Persons ____

☐ Business No. Employees ____

☐ Other _____

Water Supply: ☐ Individual ☑ Public ☐ Community

☐ Slab ☑ Crawl Space ☐ Basement w/plumbing ☐ Basement wo/plumbing


Comments/Conditions:

Located on Contour
Maintain all setbacks


Comments/Conditions:

24" Max Trench
End Cap Distribution

INITIAL SITE SKETCH

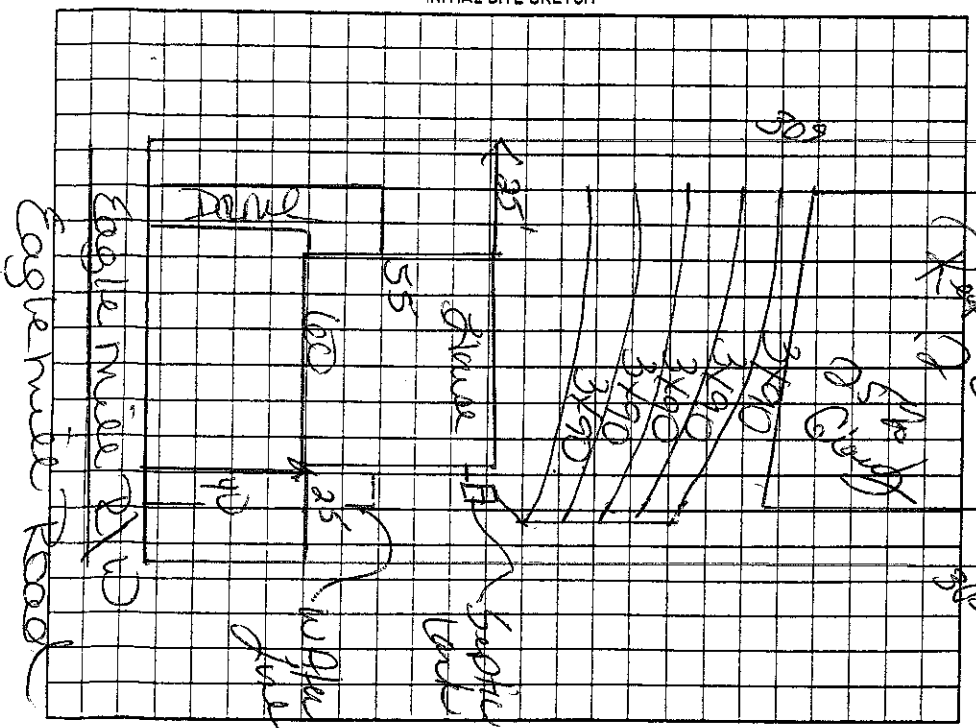

AS BUILT SKETCH

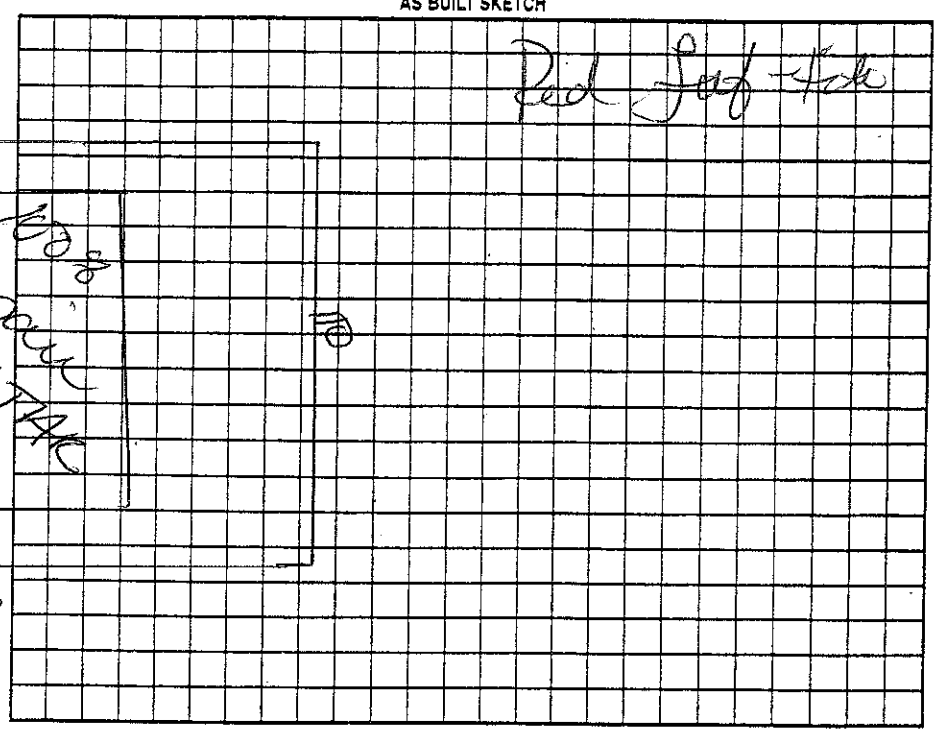

Permit can be suspended or revoked if any false information is supplied toward securing the permit/any unauthorized changes are made to the site/any unauthorized changes are made in the installation of the system. Improvement Permit with plat valid without expiration ☐ Improvement Permit with site plan valid for sixty months ☑ Authorization to Construct is valid for a period equal to that of Improvement Permit – not to exceed sixty months.

Signed: Darrel Nee date 7-23-08

Improvement Permit by: Kelly Cook date 7-23-08

Authorization to Construct by: Kelly Cook date 7-23-0

Installed by: Darrel Nee Hoss Bradley

Operation Permit by: Kelly Cook date 8-15-08

Existing System Inspection by: _____ date _____

HEALTH DEPT. COPY: WHITE OWNER COPY (FINAL): YELLOW OWNER COPY (INITIAL): PINK