IREDELL COUNTY HEALTH DEPARTMENT

Statesville Office (704) 878-5305 Mooresville Office (704) 660-3625 PERMIT # 210949

IMPROVEMENT PERMIT / AUTHORIZATION TO CONSTRUCT / OPERATION PERMIT / EXISTING SYSTEM

PIN # 4862825111

APPLICANT: Abees Clearing + Grading APPLICANT ADDRESS: 2381 US Hwy 64 West

SITE ADDRESS: 334 Allen Rd. PHONE: 704-239-3693 ALT. PHONE: N/A

SITE DIRECTIONS: Hwy 21 @ N TL West Houstonville Rd. TL Allen Rd.

SUBDIVISION: N/A SECTION: N/A LOT # N/A LOT AREA: 6.828 acres DESIGN FLOW: 360gpd L.T.A.R.: 0.25


Septic Tank	1000	(gal)	STB 760-1000	Date	7-28	☑ New System	☐ Repair	☐ Expansion	System Type: I II (III) IV V VI	☑ Residence	No. Bedrooms 3
Pump Tank		(gal)	PT	Date		System Description:	25% Reduction			☐ Business	No. Persons 6
Pump Make		Model		Serial #		Repair System Description:	25% Reduction w/soil cap			☐ Other	No. Employees
# Nitrification Fields	1	# Lines	3	Linear Ft:	360	Maintenance Agreement Required:	☐ YES	☑ NO		☐ Slab	☑ Crawl Space
Trench Width	36"	Max. Trench Bottom Depth	24"	Gravel Depth	N/A	☑ GRAVITY	☐ PRESSURE			☐ Basement w/plumbing	☐ Basement w/o plumbing

Water Supply: ☑ Private ☐ Public ☐ Community


Comments / Conditions: IMPROVEMENTS ONLY! Sub-divide + Record Property Prior to issuance of CA2. Install a 25% Reduction System on contours with serial distribution.

★ Install trench bottom @ 24" on high side ★★

INITIAL SITE SKETCH

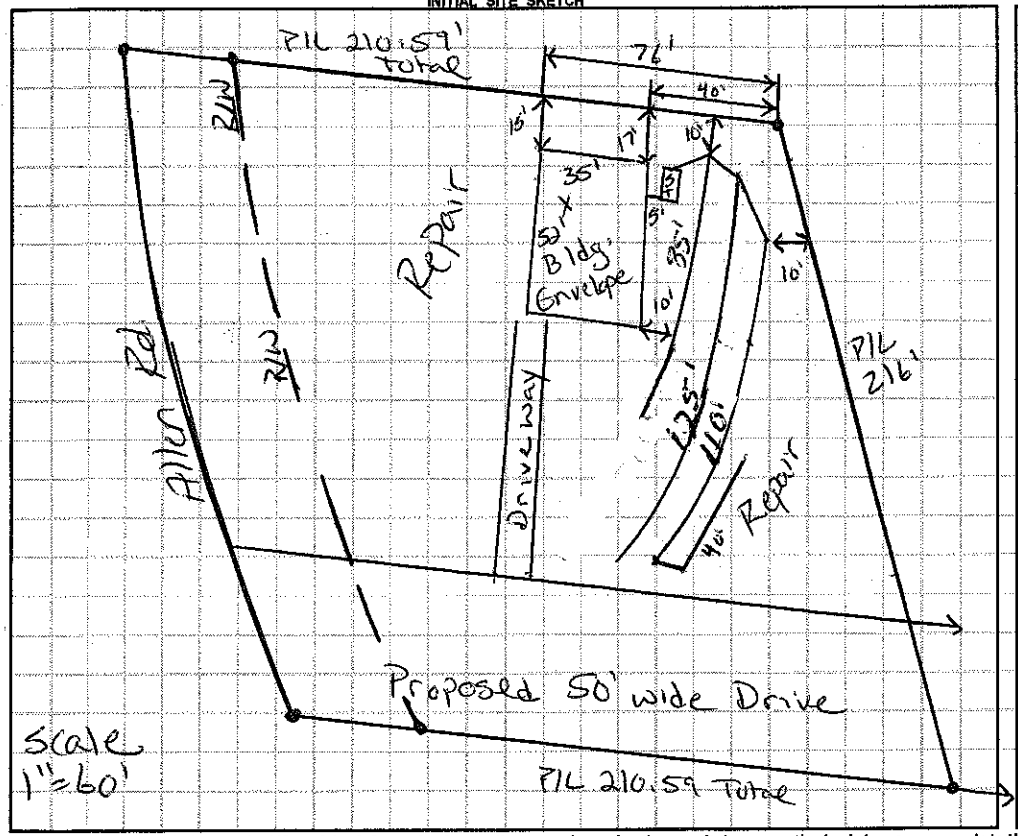

AS BUILT SKETCH

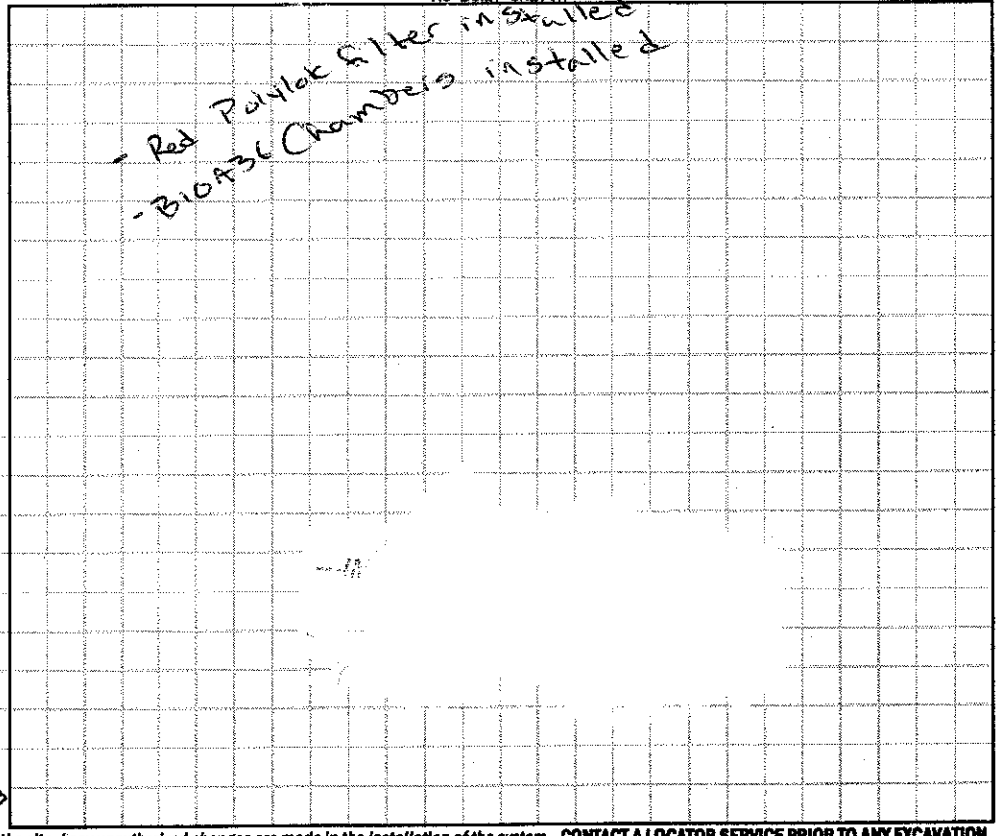

Permit can be suspended or revoked if any false information is supplied toward securing the permit / any unauthorized changes are made to the site / any unauthorized changes are made in the installation of the system. **CONTACT A LOCATOR SERVICE PRIOR TO ANY EXCAVATION**

☐ **IMPROVEMENT PERMIT** *with plat valid without expiration.* ☑ **IMPROVEMENT PERMIT** *with site plan valid for 60 mos.* ☑ **AUTHORIZATION TO CONSTRUCT** *valid for period equal to IMPROVEMENT PERMIT--not to exceed 60 mo.*

Owner / Applicant Signature: Deena Abee Date: 6/29/15 Installed by: Tim Abee

IMPROVEMENT PERMIT by: Justin Henderson Date: 6-29-15 OPERATION PERMIT by: Justin Henderson Date: 12-16-15

AUTHORIZATION TO CONSTRUCT by: Justin Henderson Date: 10-6-15 Existing System Inspected by: Date:

Health Dept. Copy - WHITE Applicant (Final Approval) - YELLOW Applicant (Conditional Approval) - PINK