IREDELL COUNTY HEALTH DEPARTMENT

STATESVILLE 704-878-5305 MOORESVILLE 704-664-5281

IMPROVEMENT PERMIT / AUTHORIZATION TO CONSTRUCT / OPERATION PERMIT / EXISTING SYSTEM INSPECTION

PERMIT # 144033 PIN # 4862730141 DATE 3-16-09

OWNER or APPLICANT James C Miles PHONE: Business 336 262 3188 Home: 704-539-5473

OWNER or APPLICANT ADDRESS Corner of Allen and Houstonville

LOCATION / DIRECTIONS 77 N to exit 65, T(R) on 901, (L) on Eagle Mills, (R) on Houstonville, (R) on Allen

SUBDIVISION n/a BLOCK / SECTION LOT # n/a LOT AREA 5.07 Ac. DESIGN FLOW 360 L.T.A.R. .3

Septic Tank 1000 Gallons: STB 620 Date 11-11-08

Pump Tank Gallons: PT Date

Pump Make Model Serial #

Nitrification Field No Fields 1 No Lines 3 Linear Feet 300

Trench Width 36" Max. Trench Bottom Depth 36" Gravel Depth n/a GRAVITY PRESSURE

☒ New System ☐ Repair ☐ Expansion System Type I II III IV V VI

System Description: 25% Reduction Gravity

Repair System Description: 25% Reduction (Pump, if nec.)

Maintenance Agreement Required ☐ YES ☒ NO

☒ Residence No. Bedrooms 3

☐ Business No. Persons

☐ Other No. Employees

☐ Slab ☒ Crawl Space


☐ Basement w/plumbing ☐ Basement w/o plumbing

Water Supply: ☐ Private ☒ Public ☐ Community


Comments / Conditions

Comments / Conditions: Filter installed.

INITIAL SITE SKETCH

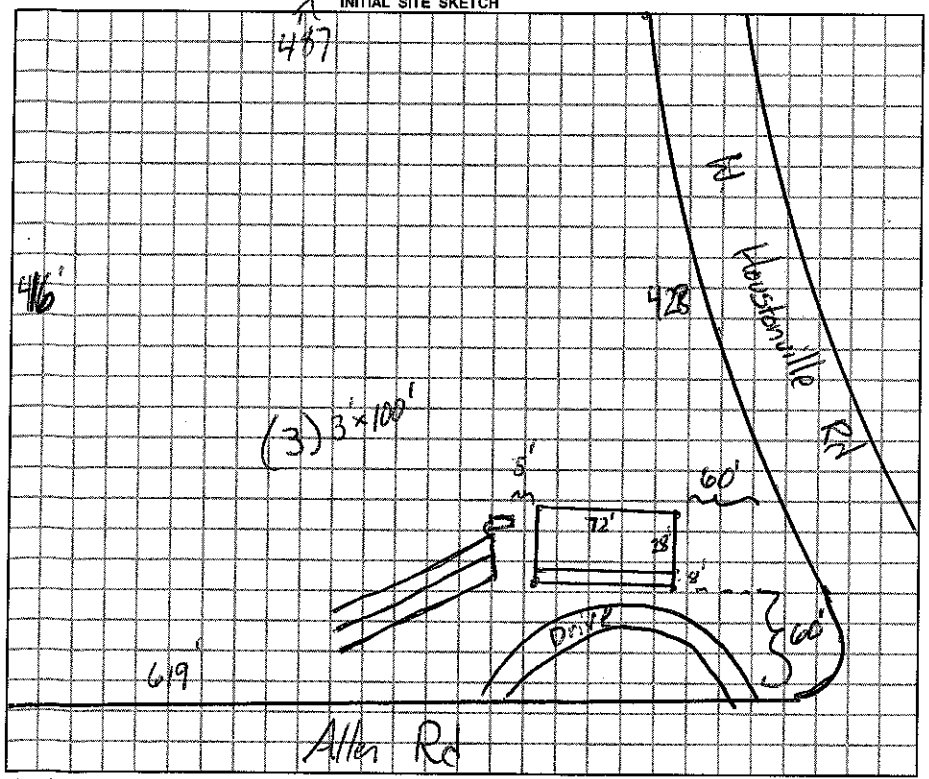

AS BUILT SKETCH

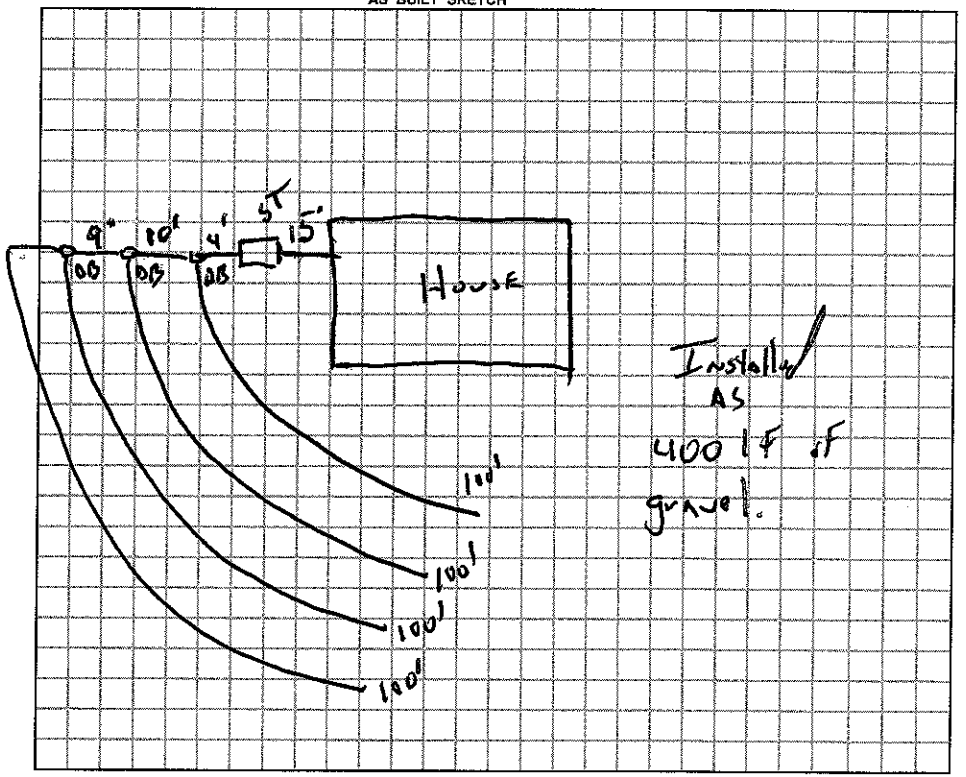

Permit can be suspended or revoked if any false information is supplied toward securing the permit / any unauthorized changes are made to the site / any unauthorized changes are made in the installation of the system.

☐ *IMPROVEMENT PERMIT w / plan valid without expiration.* ☒ *IMPROVEMENT PERMIT w / site plan valid for 60 mos.* ☐ *AUTHORIZATION TO CONSTRUCT valid for period equal to IMPROVEMENT PERMIT-not to exceed 60 mo.*

Owner / Applicant Signature: James C. Miles Date 3-18-09

Improvement Permit by: Date 3-16-09

Authorzation to Construct by: Date 3-16-09

YOU SHOULD CONTACT A LOCATOR SERVICE PRIOR TO ANY EXCAVATION.

Installed by: Samuel Reavis

Operation Permit by: , R.S. Date: 25 June 09

Existing System Inspected by: Date:

WHITE COPY Environmental Health YELLOW COPY (Final) Owner / Applicant PINK COPY (Initial) Owner / Applicant