IREDELL COUNTY HEALTH DEPARTMENT

STATESVILLE 704-878-5305 MOORESVILLE 704-664-5281

IMPROVEMENT PERMIT / AUTHORIZATION TO CONSTRUCT / OPERATION PERMIT / EXISTING SYSTEM INSPECTION

PERMIT # 159532 PIN # 4862734397 DATE 2-25-10

OWNER or APPLICANT Veronica Wittenmyer PHONE: Business 7048813376 Home:

OWNER or APPLICANT ADDRESS 172 Tranquility Lane Harmony NC 28634

LOCATION / DIRECTIONS 77 North (R) 901 (L) EAGLE MILLS (R) Houstonville on corner of Houstonville & Allen Rd 398 Allen Rd Hamptonville

SUBDIVISION N/A BLOCK / SECTION N/A LOT # N/A 1 LOT AREA 3 Acres DESIGN FLOW 600 L.T.A.R. .3

Septic Tank 1500 Gallons: STB 964 Date 1-23-10
Pump Tank Gallons: P T Date
Pump Make Model Serial #
Nitrification Field No Fields 1 No Lines 5 Linear Feet 500'
Trench Width 36" Max. Trench Bottom Depth 36" Gravel Depth N/A

☒ New System ☐ Repair ☐ Expansion System Type I II (III) IV V VI
System Description: Gravity 25% REDUCTION
Repair System Description: SAME
Maintenance Agreement Required ☐ YES ☒ NO
☒ GRAVITY ☐ PRESSURE


☒ Residence No. Bedrooms 5
☐ Business No. Persons 8
☐ Other No. Employees
☐ Slab ☐ Crawl Space
☐ Basement w/plumbing ☐ Basement w/o plumbing

Water Supply: ☐ Private ☐ Public ☐ Community

Comments / Conditions
① House system is flagged out entirely
② Install lines on Contours & maintain setbacks
③ Owner requested 25% Reduction ④ This permit replaces previously issued permit dated 1-22-10

Comments / Conditions

INITIAL SITE SKETCH

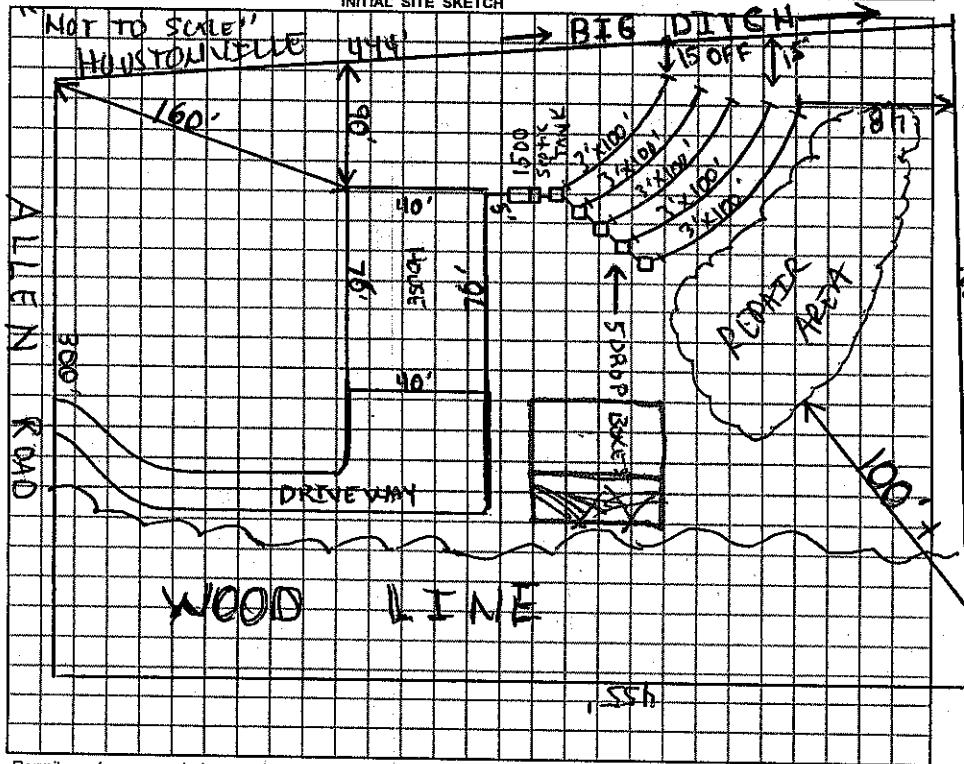

AS BUILT SKETCH

end-cap distribution

Location of the proposed pole barn 30'x40' addition does not appear to impact the existing on-site septic system.**NOTE:

REHS

Date: 1-20-12

ICHD-Environmental Health Division

Permit can be suspended or revoked if any false information is supplied toward securing the permit / any unauthorized changes are made to the site / any unauthorized changes are made in the installation of the system.

☐ *IMPROVEMENT PERMIT w / plat valid without expiration.* ☒ *IMPROVEMENT PERMIT w / site plan valid for 60 mos.* ☒ *AUTHORIZATION TO CONSTRUCT valid for period equal to IMPROVEMENT PERMIT-not to exceed 60 mo.*

Owner / Applicant Signature: Veronica Wittenmyer Date 3-1-10

Improvement Permit by: Date 2-25-10

Authorization to Construct by: Date 2-25-10

YOU SHOULD CONTACT A LOCATOR SERVICE PRIOR TO ANY EXCAVATION.

Installed by: Abee Grading

Operation Permit by: Date: 3-16-10

Existing System Inspected by: Date:

WHITE COPY Environmental Health YELLOW COPY (Final) Owner / Applicant PINK COPY (Initial) Owner / Applicant