IREDELL COUNTY HEALTH DEPARTMENT

THIS PERMIT VOIDS PREVIOUS ISSUED 12-19-96 #6567

STATESVILLE 704-878-5305 MOORESVILLE 704-664-5281

IMPROVEMENT PERMIT / CERTIFICATE OF COMPLETION / OPERATION PERMIT / EXISTING SYSTEM INSPECTION

PROPERTY DESCRIPTION NO. 25621 DATE 2-13-97 TAX MAP NO. 17L-A-41 (PART OF) Watershed: ☐ PS ☐ LP No

OWNER OR CONTRACTOR RANDY L. CHRISTIAN PHONE: Business Home 876-4974

ADDRESS C/O P.O. BOX 134, OLIN, NC. 28660

LOCATION I-77N, TR NC 901, TL EAGLE MILLS ROAD, TR HOUSTONVILLE ROAD, ON RIGHT PAST ALLEN ROAD.

SUBDIVISION BLOCK / SECTION LOT LOT AREA 17 ACRES +/- SITE CLASS PS DESIGN FLOW 480 L.T.A.R. 0.39 GPD/FT²

Septic Tank: 1000 Gallons; STB 1007 Date 1-11-97

Pump Tank: Gallons; PT Date

Pump Make: Model Serial No.

Nitrification Field: No Fields 1 Square Feet 1440 Linear Feet 480

No Lines SIX Trench Width 36" Max Trench Bottom Depth 30"

☑ New System ☐ Repair System Type: I, II, III, IV, V, VI

System Description: CONVENTIONAL GRAVITY

Repair System Description: CONVENTIONAL GRAVITY

Maintenance Agreement Required: ☐ Yes ☑ No

Gravel Depth 12"

☐ House/Mod. Home No. Bedrooms 4

☑ Mobile Home No. Bathrooms 2

☐ Business No. Employees

☐ Other

☐ Slab ☑ Crawl Space ☐ Basement w/plumbing ☐ Basement wo/plumbing


Water Supply: ☑ Individual ☐ Community ☐ Public

WELL

Comments: ① KEEP SYSTEM MINIMUM 100' FROM WELL ② USE ONE FLOW DIVERTER TEE TO ACHIEVE EQUAL DISTRIBUTION INTO TWO DIST. BOXES FEEDING THREE LINES EACH ③ INSTALL LINES ON CONTOUR

Comments:

INITIAL SITE SKETCH

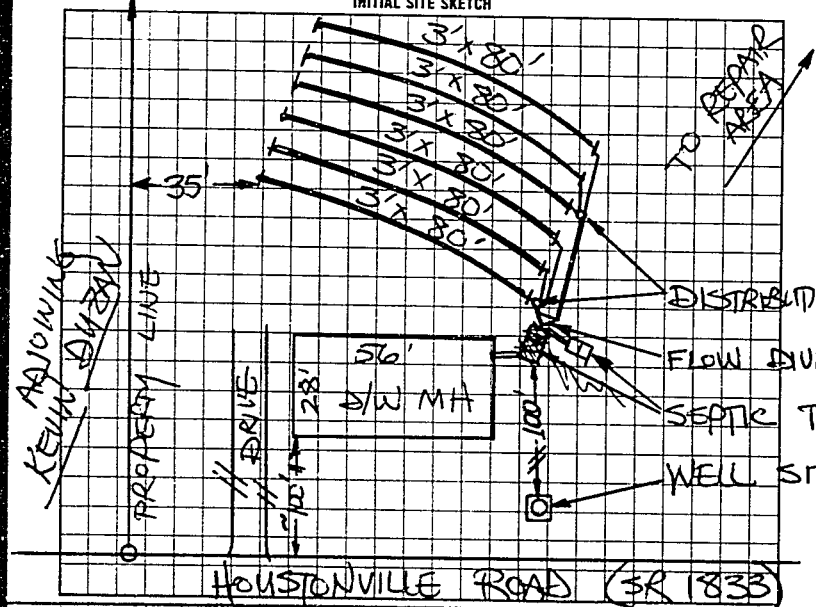

AS BUILT SKETCH

SYSTEM INSTALLED ACCORDING TO INITIAL SITE SKETCH

I understand that this permit can be suspended or revoked if any false information is supplied toward securing the permit/any unauthorized changes are made to the site/any unauthorized changes are made in the installation of the system. Improvement Permit is valid for 60 months from date of issuance AUTHORIZATION TO CONSTRUCT IS VALID FOR 60 MONTHS FROM DATE OF ISSUANCE.

Signed: X Randy Christian

Improvement Permit by: STEVE HEDRICK date 2-13-97

AUTH. TO CONST. by: STEVE HEDRICK date 2-13-97

Installed by: KENNY PEARSON

~~Certificate of Completion by:~~ date

Operation Permit by: STEVE HEDRICK date 2-19-97

HEALTH DEPT. COPY: WHITE INSPECTION COPY (FINAL): GREEN OWNER COPY (FINAL): YELLOW INSPECTION COPY (INITIAL): PINK OWNER COPY (INITIAL): GOLD