IREDELL COUNTY HEALTH DEPARTMENT

Statesville Office (704) 878-5305 Mooresville Office (704) 660-3625 PERMIT # [illegible]

IMPROVEMENT PERMIT / AUTHORIZATION TO CONSTRUCT / OPERATION PERMIT / EXISTING SYSTEM

PIN # 4862535350

APPLICANT: Melissa Duzan APPLICANT ADDRESS: 557 W. Houstonville Rd Hamptonville NC

SITE ADDRESS: 557 W. Houstonville Rd Hamptonville NC PHONE: 704-539-4456 ALT. PHONE: 704-902-6239

SITE DIRECTIONS: 77 N to exit 65 T/R the T/L Eagle Mills Rd T/R W. Houstonville Rd Lot on right

SUBDIVISION: N/A SECTION: N/A LOT # N/A LOT AREA: 10 ac DESIGN FLOW: 360 L.T.A.R.: .3

Septic Tank 1000 (gal) STB 760-1000 Date 1-11

Pump Tank (gal) PT Date

Pump Make Model Serial #

Nitrification Fields 1 # Lines 3 Linear Ft: 300

Trench Width 36" Max. Trench Bottom Depth 24" Gravel Depth N/A

☒ New System ☐ Repair ☐ Expansion System Type: I II (III) IV V VI

System Description: 25% Reduction

Repair System Description: 25% Reduction

Maintenance Agreement Required: ☐ YES ☒ NO

☒ GRAVITY ☐ PRESSURE

☒ Residence ☐ Business ☐ Other ☐ Slab ☐ Basement w/plumbing


No. Bedrooms 3 No. Persons 6 No. Employees

☒ Crawl Space ☐ Basement w/o plumbing


Water Supply: ☐ Private ☒ Public ☐ Community

Comments / Conditions: Install 25% reduction on contour with serial distribution.

INITIAL SITE SKETCH

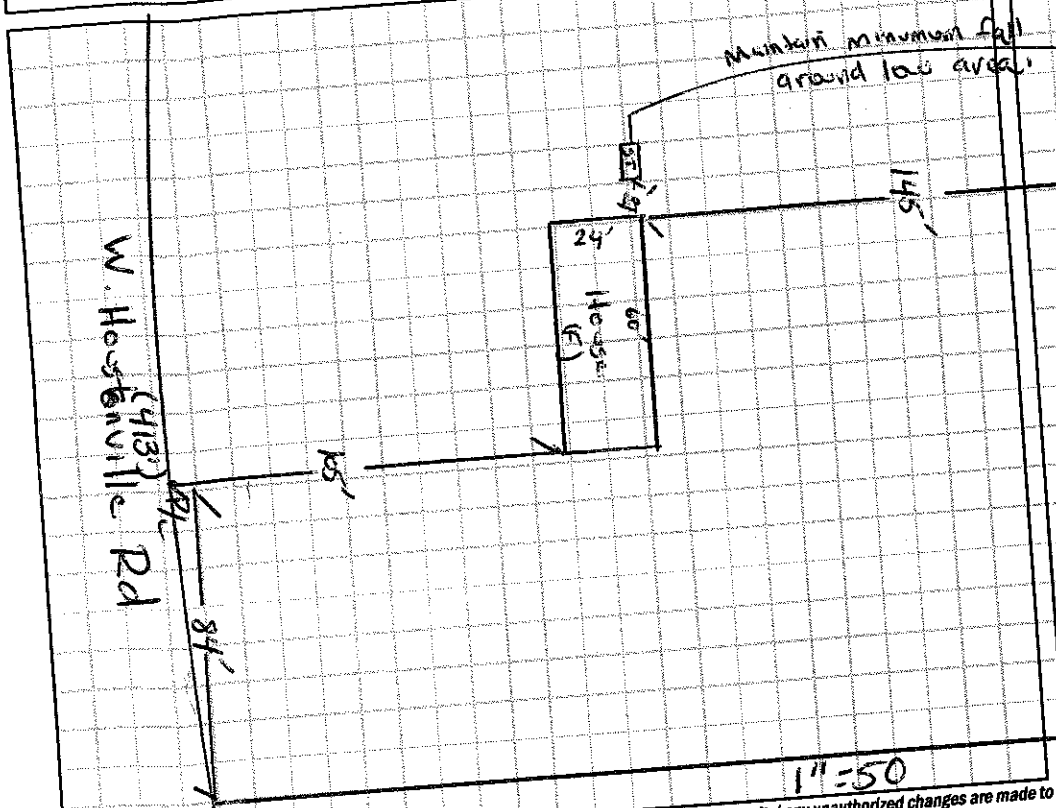

AS BUILT SKETCH

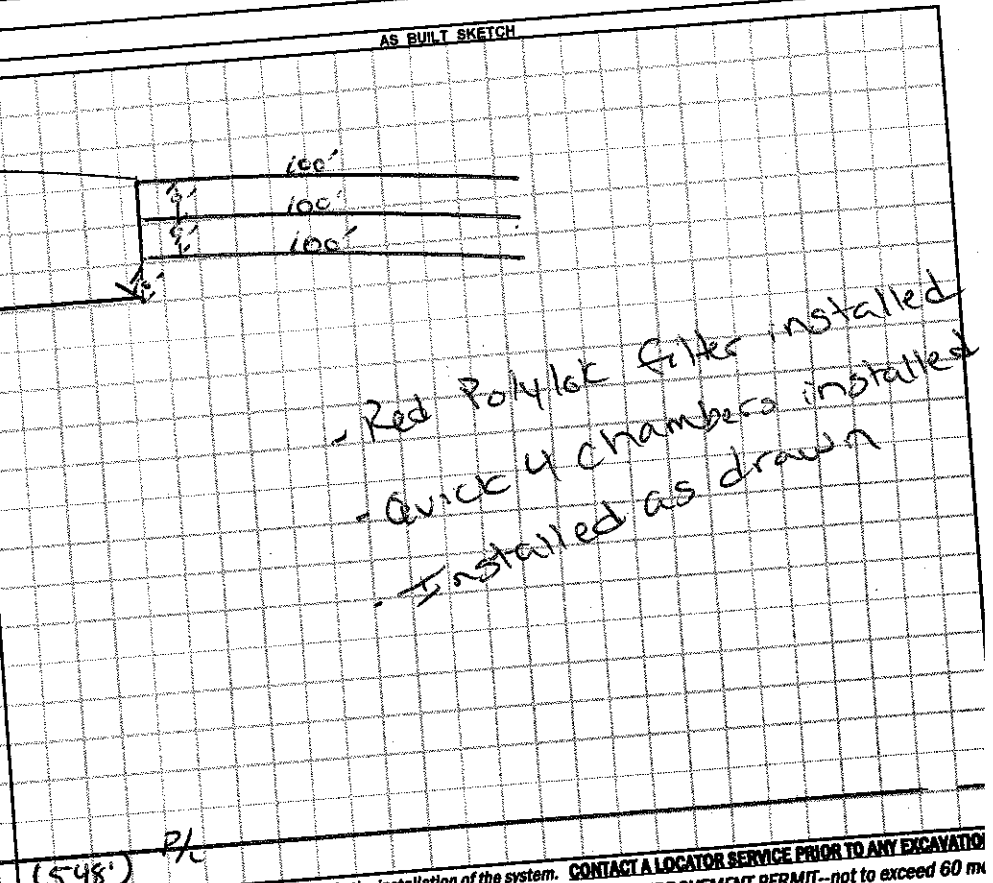

Permit can be suspended or revoked if any false information is supplied toward securing the permit / any unauthorized changes are made to the site / any unauthorized changes are made in the installation of the system. CONTACT A LOCATOR SERVICE PRIOR TO ANY EXCAVATIO

☐ IMPROVEMENT PERMIT with plat valid without expiration.

☒ IMPROVEMENT PERMIT with site plan valid for 60 mos.

☒ AUTHORIZATION TO CONSTRUCT valid for period equal to IMPROVEMENT PERMIT--not to exceed 60 m

Owner / Applicant Signature: Date:

IMPROVEMENT PERMIT by: Date: 05/16/14

AUTHORIZATION TO CONSTRUCT by: Date: 05/16/14

Installed by: Gunter Grading Date: 6-11-14

OPERATION PERMIT by: Justin Henderson Date:

Existing System Inspected by:

Health Dept. Copy - WHITE Applicant (Final Approval) - YELLOW Applicant (Conditional Approval) - PINK