#059483

IREDELL COUNTY HEALTH DEPARTMENT

STATESVILLE 704-878-5305 MOORESVILLE 704-664-5281

IMPROVEMENT PERMIT / CERTIFICATE OF COMPLETION / OPERATION PERMIT / EXISTING SYSTEM INSPECTION

PROPERTY DESCRIPTION NO 23393 DATE 4-8-96 TAX MAP NO 17L-A-56 Watershed JJT Basin ✓ No

OWNER OR CONTRACTOR KIMBERLY HOLLAND PHONE Business Home 539-4107

ADDRESS 365 YORK / SPANN, HAMPTONVILLE NC 27020

LOCATION I-77 N, TR NC901, TL EAGLE MILLS, TR YORK SPANN RD, 4th DRIVE on RIGHT

SUBDIVISION BLOCK / SECTION LOT LOT AREA 7.45 AC SITE CLASS PS DESIGN FLOW 360 LTAR EXISTING

Septic Tank: 1000 Gallons; STB Date

Pump Tank: Gallons; PT Date

Pump Make: Model Serial No

Nitrification Field: No Fields 1 Square Feet 900 Linear Feet 300

No Lines 3 Trench Width Max Trench Bottom Depth Gravel Depth

New System Repair System Type CONV, CONTV

System Description

Repair System Description

Maintenance Agreement Required Yes ✓No

House/Mod Home ✓ No Bedrooms 3

Mobile Home No Bathrooms 2

Business No Employees

Other


Slab ✓Crawl Space Basement w/plumbing Basement wo/plumbing

Water Supply ✓Individual Community Public WELL


Comments:

Comments KEEP SYSTEM MINIMUM 5' FROM MH.

INITIAL SITE SKETCH

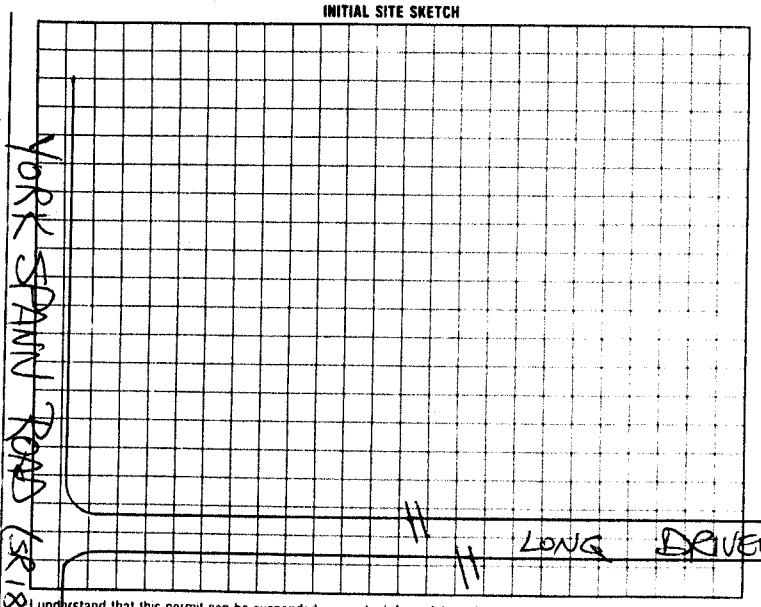

AS BUILT SKETCH

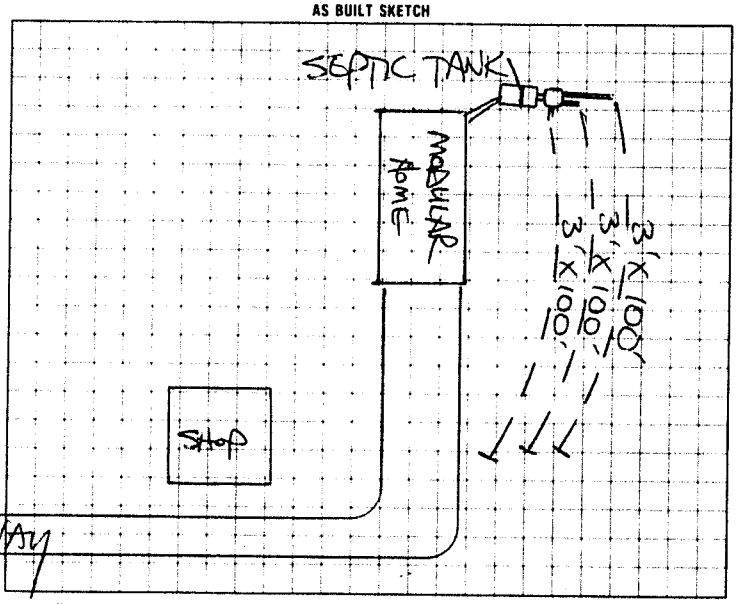

I understand that this permit can be suspended or revoked if any false information is supplied toward securing the permit, any unauthorized changes are made to the site/any unauthorized changes are made in the installation of the system

Signed

Improvement Permit by date

Existing System Inspection by STEVE HENDRICK date 4-8-96

Installed by

Certificate of Completion by date

Operation Permit by date

HEALTH DEPT COPY: WHITE INSPECTION COPY (FINAL) GREEN OWNER COPY (FINAL) YELLOW INSPECTION COPY (INITIAL) PINK OWNER COPY (INITIAL) GOLD