IREDELL COUNTY HEALTH DEPARTMENT

STATESVILLE 704-878-5305 (C) MOORESVILLE 704-664-5281 (C.I.)

IMPROVEMENT PERMIT / AUTHORIZATION TO CONSTRUCT / OPERATION PERMIT / EXISTING SYSTEM INSPECTION

PERMIT# 108360 PIN# 4863-04-2508 DATE 8-29-02

OWNER OR CONTRACTOR ROBERT M. BEASLEY PHONE: Business _____ Home _____

ADDRESS 5749 STHLGH CH. RD, HAMPTONVILLE NC 27020

LOCATION I-77 N, TL NC 901, TR MULLIS RD, BEAR @ AT END, 2ND DRIVE ON LEFT PAST ZION LIBERTY RD, BACK OFF ROAD

SUBDIVISION _____ BLOCK / SECTION _____ LOT _____ LOT AREA 12 ACRES SITE CLASS PS DESIGN FLOW 240 L.T.A.R. 0.4 GPD/FT

Septic Tank: 1000 Gallons: STB 794 Date 6-7-95
Pump Tank: _____ Gallons: PT _____ Date _____
Pump Make: _____ Model _____ Serial No. _____
Nitrification Field: No Fields 1 Square Feet 600 Linear Feet 200
No Lines THREE Trench Width 36" Max Trench Bottom Depth 36" Gravel Depth 12"

☐ New System ☐ Repair System Type: I II III IV V VI
System Description: CONVENTIONAL, GRAVITY
Repair System Description: _____
Maintenance Agreement Required: ☐ Yes ☐ No
☐ Slab ☐ Crawl Space ☐ Basement w/plumbing ☐ Basement wo/plumbing


☐ House/Mod. Home No. Bedrooms 2
☐ Mobile Home No. Bathrooms 2
☐ Business No. Employees _____
☐ Other _____

Water Supply:
☐ Individual
☐ Public
☐ Community


Comments:/Conditions:

Comments /Conditions SYSTEM SIZED FOR TWO BEDROOMS ONLY

INITIAL SITE SKETCH

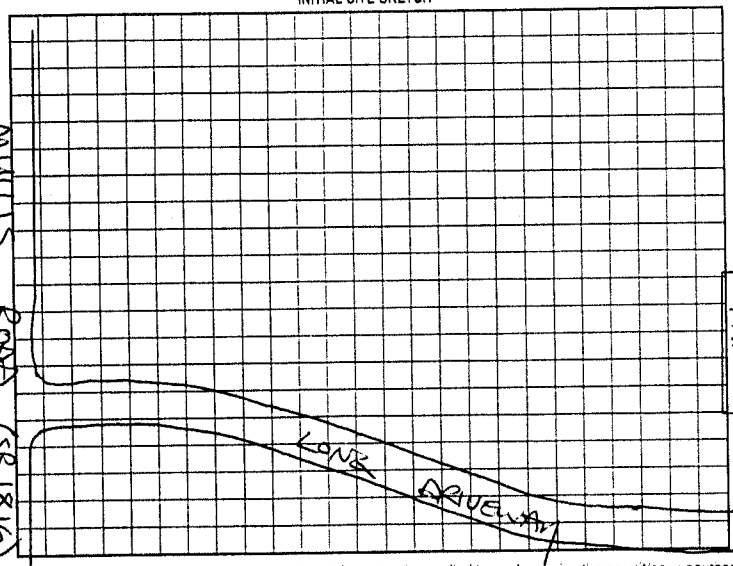

AS BUILT SKETCH

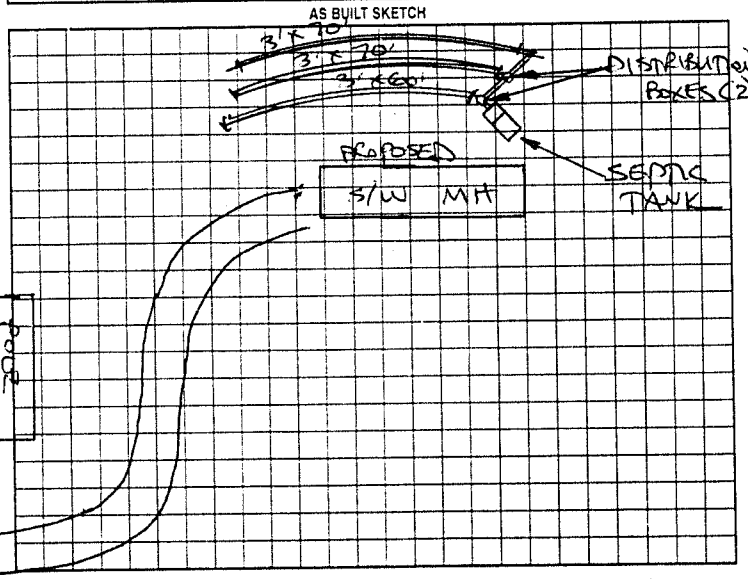

Permit can be suspended or revoked if any false information is supplied toward securing the permit/any unauthorized changes are made to the site any unauthorized changes are made in the installation of the system. Improvement Permit with plat valid without expiration. Improvement Permit with site plan valid for sixty months. Authorization to Construct is valid for a period equal to that of Improvement Permit – not to exceed sixty months

Signed: _____ date _____ Installed by _____

Improvement Permit by: _____ date _____ Operation Permit by _____ date _____

Authorization to Construct by: _____ date _____ Existing System Inspection by: STEVE HENDRICK date 8-29-02

HEALTH DEPT. COPY: WHITE OWNER COPY (FINAL): YELLOW OWNER COPY (INITIAL): PINK