IREDELL COUNTY HEALTH DEPARTMENT

STATESVILLE 704-878-5305 MOORESVILLE 704-664-5281

IMPROVEMENT PERMIT / AUTHORIZATION TO CONSTRUCT / OPERATION PERMIT / EXISTING SYSTEM INSPECTION

PERMIT# 116982 PIN# 4863-04-~~2508.001~~ 5496 DATE 4-20-04

OWNER OR CONTRACTOR ROBERT M. BEASLEY PHONE: Business _____ Home (704) 539-4398

ADDRESS 617 MULLIS RD. UNION GROVE, NC 28689

LOCATION I-77 N EXIT 65 (L) HWY 901 (R) MULLIS RD. 2ND DRIVE ON (L) PAST ZION LIBERTY

SUBDIVISION _____ BLOCK / SECTION _____ LOT _____ LOT AREA 4.0 SITE CLASS. PS DESIGN FLOW 360 L.T.A.R. 0.30 GPD/FT²

Septic Tank: 1000 Gallons; STB 1012 Date 10-20-03
Pump Tank: _____ Gallons; PT _____ Date _____
Pump Make: _____ Model _____ Serial No. _____
Nitrification Field: No Fields 1 Square Feet 1200 Linear Feet 400
No Lines 4 Trench Width 12" Max Trench Bottom Depth 18" Gravel Depth N/A

☑ New System ☐ Repair System Type: I, II, (III), IV, V, VI
System Description: GRAVITY LARGE DIAMETER PIPE
Repair System Description: SAME
Maintenance Agreement Required: ☐ Yes ☑ No


☑ House/Mod. Home No. Bedrooms 3
☐ Mobile Home No. Bathrooms 2
☐ Business No. Employees _____
☐ Other _____
☐ Slab ☐ Crawl Space ☐ Basement w/plumbing ☐ Basement wo/plumbing

Water Supply: ☐ Individual ☑ Public ☐ Community


Comments:/Conditions: (1) INSTALL LINES ON CONTOUR (2) MAINTAIN SETBACKS (3) INSTALL SWALE TO DIVERT SURFACE WATER

Comments:/Conditions: (1) TUFF-TITE FILTER (2) 10" LDP (3) INSTALLED ACCORDING TO SKETCH (4) SL (GROUP I) BACKFILL INSTALLED OVER LINES, FOLLOWED W/ CL (GROUP III) (5) SWALE INSTALLED AROUND UPPER EDGE OF SYSTEM.

SCALE 1"=60' INITIAL SITE SKETCH

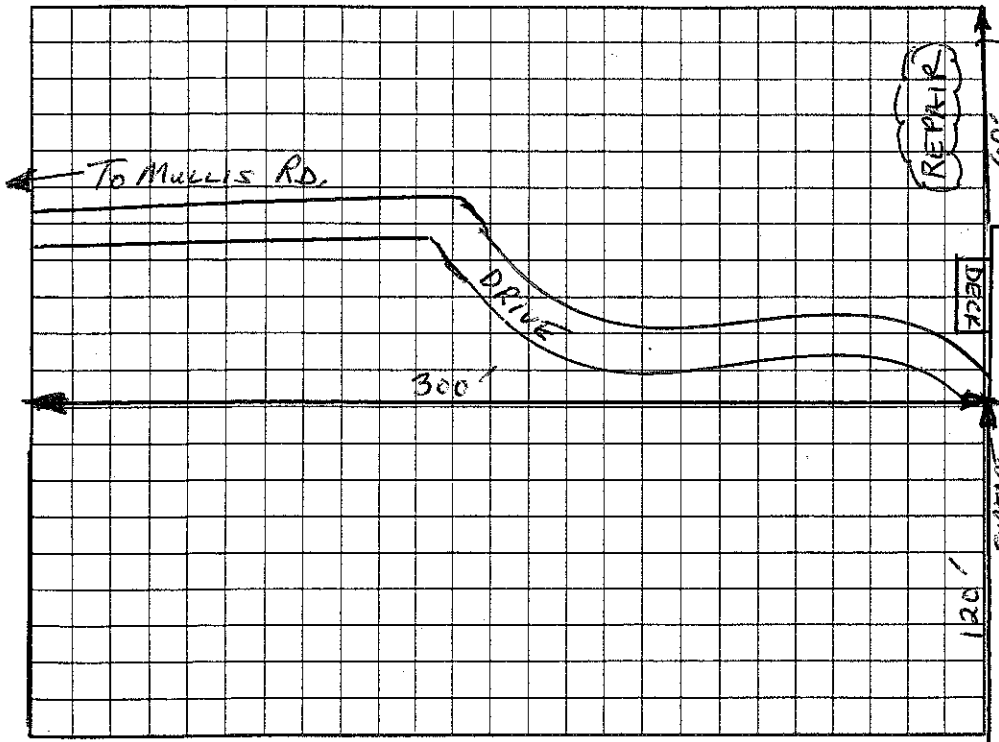

AS BUILT SKETCH

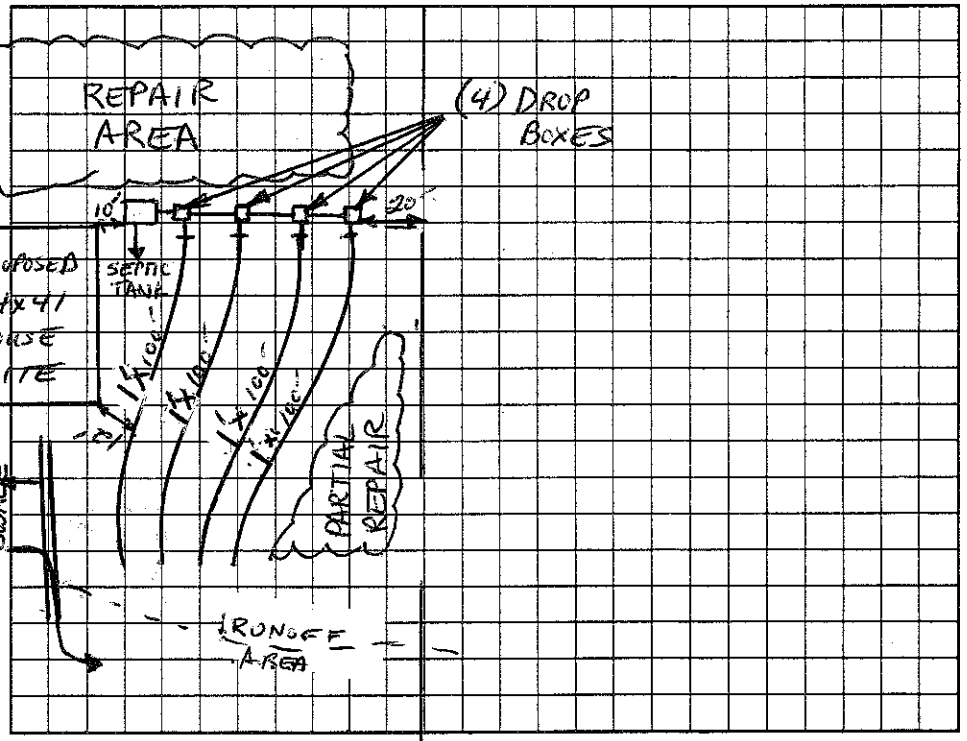

Permit can be suspended or revoked if any false information is supplied toward securing the permit/any unauthorized changes are made to the site/any unauthorized changes are made in the installation of the system. Improvement Permit with plat valid without expiration. Improvement Permit with site plan valid for sixty months. Authorization to Construct is valid for a period equal to that of Improvement Permit – not to exceed sixty months.

Signed: R. M. Beasley date 04-26-04 Installed by: A-1 Backhoe

Improvement Permit by: Christopher M. Shevill, RS date 4-20-04 Operation Permit by: Christopher M. Shevill, RS date 5-4-04

Authorization to Construct by: Christopher M. Shevill, RS date 4-20-04 Existing System Inspection by: _____ date _____

HEALTH DEPT. COPY: WHITE OWNER COPY (FINAL): YELLOW OWNER COPY (INITIAL): PINK