IREDELL COUNTY HEALTH DEPARTMENT

STATESVILLE 704-878-5305 MOORESVILLE 704-664-5281

IMPROVEMENT PERMIT / AUTHORIZATION TO CONSTRUCT / OPERATION PERMIT / EXISTING SYSTEM INSPECTION

PERMIT# 074797 PIN# 4863 20 6061 DATE 7-22-98

OWNER OR CONTRACTOR HAZELINE SOUTHOR PHONE: Business Home (336) 468-4382

ADDRESS 4916 HUNTING CREEK CH. RD, HAMPTONVILLE, NC 27020

LOCATION I-77 N, TR NC 901, TL WINTHROP, TL CRATER, TR CARTWRIGHT, TL AARON, TR VANAR LEE

SUBDIVISION _____ BLOCK / SECTION _____ LOT _____ LOT AREA 3.87 ACRES SITE CLASS. PS DESIGN FLOW 360 L.T.A.R. 0.30 GPD/FT²

Septic Tank: 1000 Gallons; STB 238 Date 6-20-98
Pump Tank: _____ Gallons; PT _____ Date _____
Pump Make: _____ Model _____ Serial No. _____
Nitrification Field: No Fields 1 Square Feet 1200 Linear Feet 400
No Lines FOUR Trench Width 36" Max Trench Bottom Depth 30"

☑ New System ☐ Repair System Type: I, II, III, IV, V, VI
System Description: CONVENTIONAL GRAVITY
Repair System Description: CONV. GRAVITY
Maintenance Agreement Required: ☐ Yes ☑ No
Gravel Depth 12"


☐ House/Mod. Home No. Bedrooms 3
☑ Mobile Home No. Bathrooms 2
☐ Business No. Employees ____
☐ Other _____
☐ Slab ☑ Crawl Space ☐ Basement w/plumbing ☐ Basement wo/plumbing

Water Supply: ☑ Individual ☐ Public ☐ Community
WELL NEXT DOOR

Comments:/Conditions: INSTALL LINES ON CONTOUR AS FLAGGED, NO DEEPER THAN 30".

Comments:/Conditions:

INITIAL SITE SKETCH ~SCALE: 1"=50'

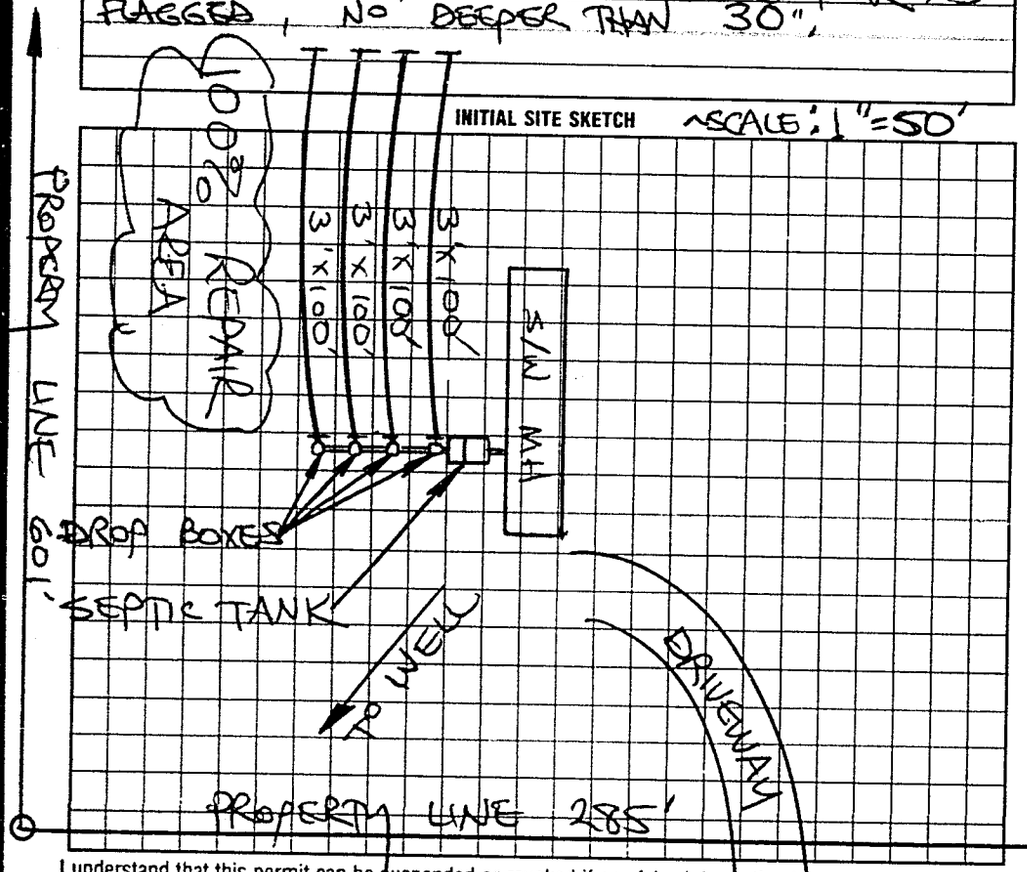

AS BUILT SKETCH

SYSTEM INSTALLED ACCORDING TO INITIAL SITE SKETCH

I understand that this permit can be suspended or revoked if any false information is supplied toward securing the permit/any unauthorized changes are made to the site/any unauthorized changes are made in the installation of the system. Improvement Permit with plat valid without expiration. Improvement Permit with site plan valid for sixty months. Authorization to Construct is valid for a period equal to that of Improvement Permit – not to exceed sixty months.

Signed: Roger Southern date 7-22-98 Installed by: H.B. SALMONS

Improvement Permit by: STEVE HEDRICK date 7-22-98 Operation Permit by: STEVE HEDRICK date 1-30-98

Authorization to Construct by: STEVE HEDRICK date 7-22-98 Existing System Inspection by _____ date _____

HEALTH DEPT COPY: WHITE INSPECTION COPY (FINAL): GREEN OWNER COPY (FINAL): YELLOW INSPECTION COPY (INITIAL): PINK OWNER COPY (INITIAL): GOLD

25001