IREDELL COUNTY HEALTH DEPARTMENT

THIS PERMIT VOIDS PREVIOUS ISSUED 5-27-97

STATESVILLE 704-878-5305 MOORESVILLE 704-664-5281

IMPROVEMENT PERMIT / AUTHORIZATION TO CONSTRUCT / OPERATION PERMIT / EXISTING SYSTEM INSPECTION

PERMIT# 2589 PIN# 4863 20 8502 (PT) DATE 1-8-99

OWNER OR CONTRACTOR ROGER SOUTHER PHONE: Business Home (336) 468-4382

ADDRESS P.O. BOX 231 JONESVILLE, NC 28642

LOCATION I-77 N, TR NC 901, T/L CRATER, TR CARTWRIGHT, TL AARON RD, TR VAN DER LEE DRIVE AT SW

SUBDIVISION BLOCK / SECTION LOT LOT AREA 3.8735 ACRES SITE CLASS PS DESIGN FLOW 360 L.T.A.R. 0.30 GPD/FT²

Septic Tank: 1000 Gallons; STB 750 Date 11-21-98

Pump Tank: Gallons; PT Date

Pump Make: Model Serial No.

Nitrification Field: No Fields 1 Square Feet 1200 Linear Feet 400

No Lines FIVE Trench Width 36" Max Trench Bottom Depth 30" Gravel Depth 12"

✓ New System Repair System Type: I II III IV V VI

System Description CONVENTIONAL GRAVITY

Repair System Description CONV. GRAVITY

Maintenance Agreement Required Yes ✓ No

Slab ✓ Crawl Space Basement w/plumbing Basement w/o plumbing

Home/Mod Home No. Bedrooms 3

✓ Mobile Home No. Bathrooms 2

Business No. Employees

Other

Water Supply: ✓ Individual ☐ Public ☐ Community


WELL

Comments/Conditions:

Comments/Conditions: FOLYLOK FILTER & TANK PENETRATION SEAL

INITIAL SITE SKETCH

~SCALE: 1" = 40'

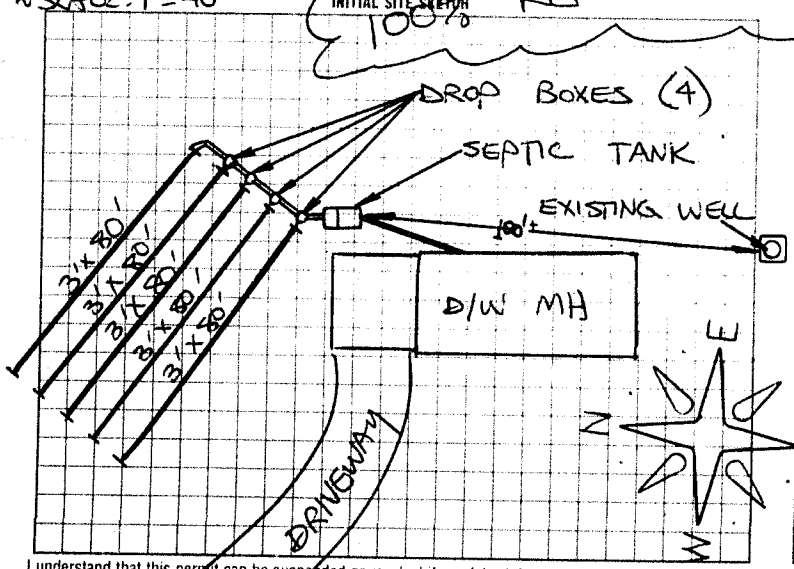

AS BUILT SKETCH

SYSTEM INSTALLED ACCORDING TO INITIAL SITE SKETCH

I understand that this permit can be suspended or revoked if any false information is supplied toward securing the permit/any unauthorized changes are made to the site/any unauthorized changes are made in the installation of the system. Improvement Permit with plat valid without expiration. Improvement Permit with site plan valid for sixty months. Authorization to Construct is valid for a period equal to that of Improvement Permit – not to exceed sixty months.

Signed: Roger Souther date 1-8-99

Improvement Permit by: STEVE HEDRICK date 1-8-99

Authorization to Construct by: STEVE HEDRICK date 1-8-99

Installed by: H.B SALMONS

Operation Permit by: STEVE HEDRICK date 1-21-99

Existing System Inspection by: date

HEALTH DEPT. COPY. WHITE | INSPECTION COPY (FINAL) GREEN | OWNER COPY (FINAL) YELLOW | INSPECTION COPY (INITIAL) PINK | OWNER COPY (INITIAL) GOLD